


NOTE: HOUSE SHOWN AS PER STAKED



PLAT OF SURVEY OF


UNIT 109 OF ABBEY SPRINGS CONDOMINIUM #3.
LOCATED IN THE SOUTH 1/2 OF SECTION 13, T1N,
R16E, VILLAGE OF FONTANA-ON-GENEVA LAKE,
WALWORTH COUNTY, WISCONSIN.

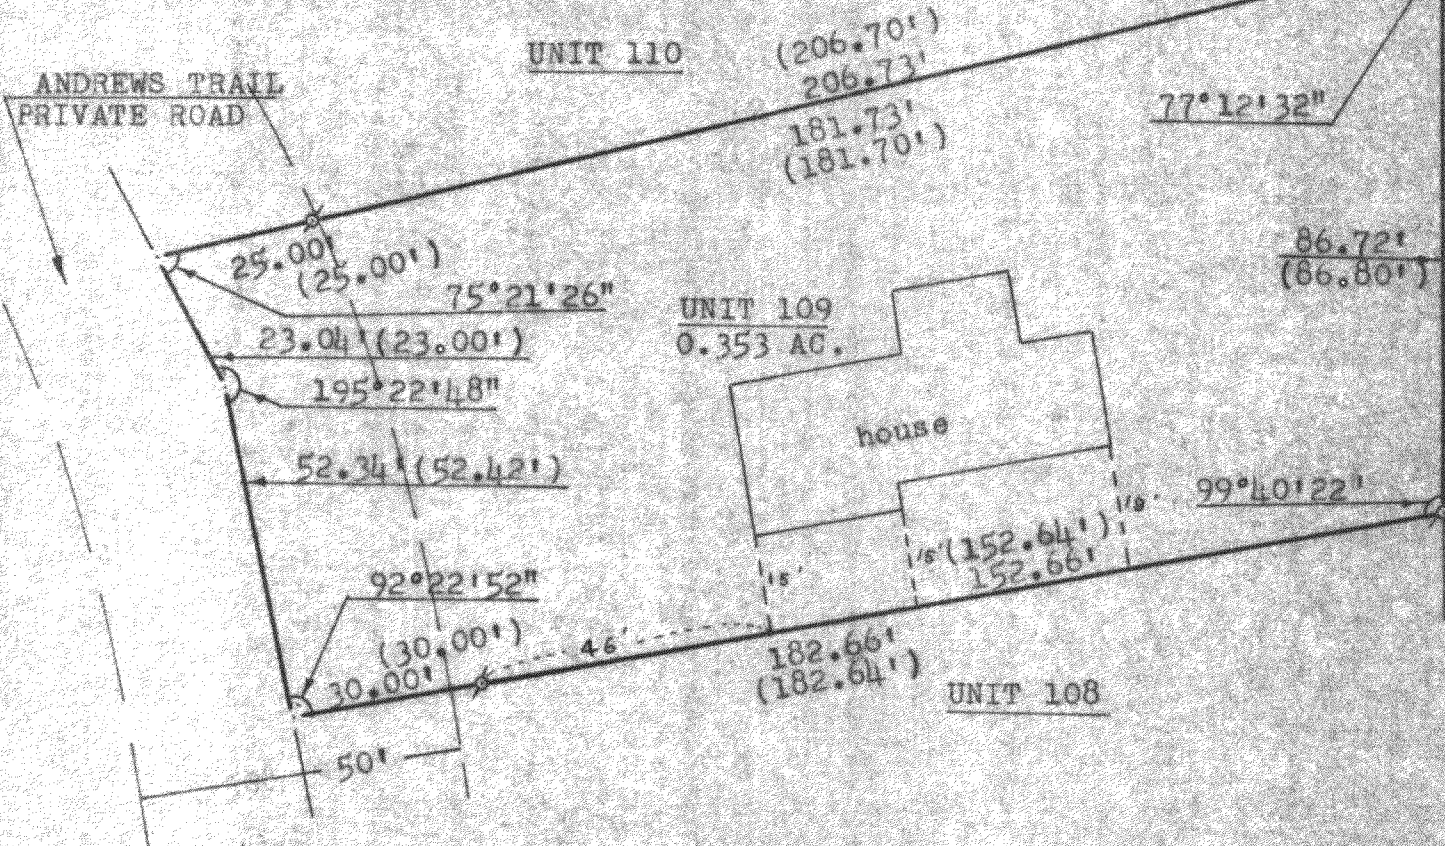

0 10 20 30
SCALE IN FEET

LEGEND:

⊗ - Found iron pipe
() - As platted

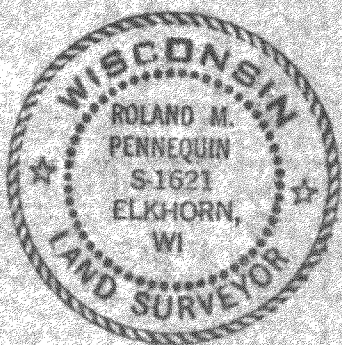

I, ROLAND M. PENNEQUIN, Registered
Land Surveyor, hereby certify that I
have surveyed the above described
property and that the plat shown
hereon is an accurate representation
of the exterior boundary lines and
all divisions of said property, to
the best of my belief.

Roland M. Pennequin
ROLAND PENNEQUIN
REGISTERED LAND SURVEYOR - S-1621

Date: *March 3 - 1981*