


DUNHAM SURVEYING, S.C.
SURVEYING & SUBDIVIDING
DELAVER, WISCONSIN 53115

N

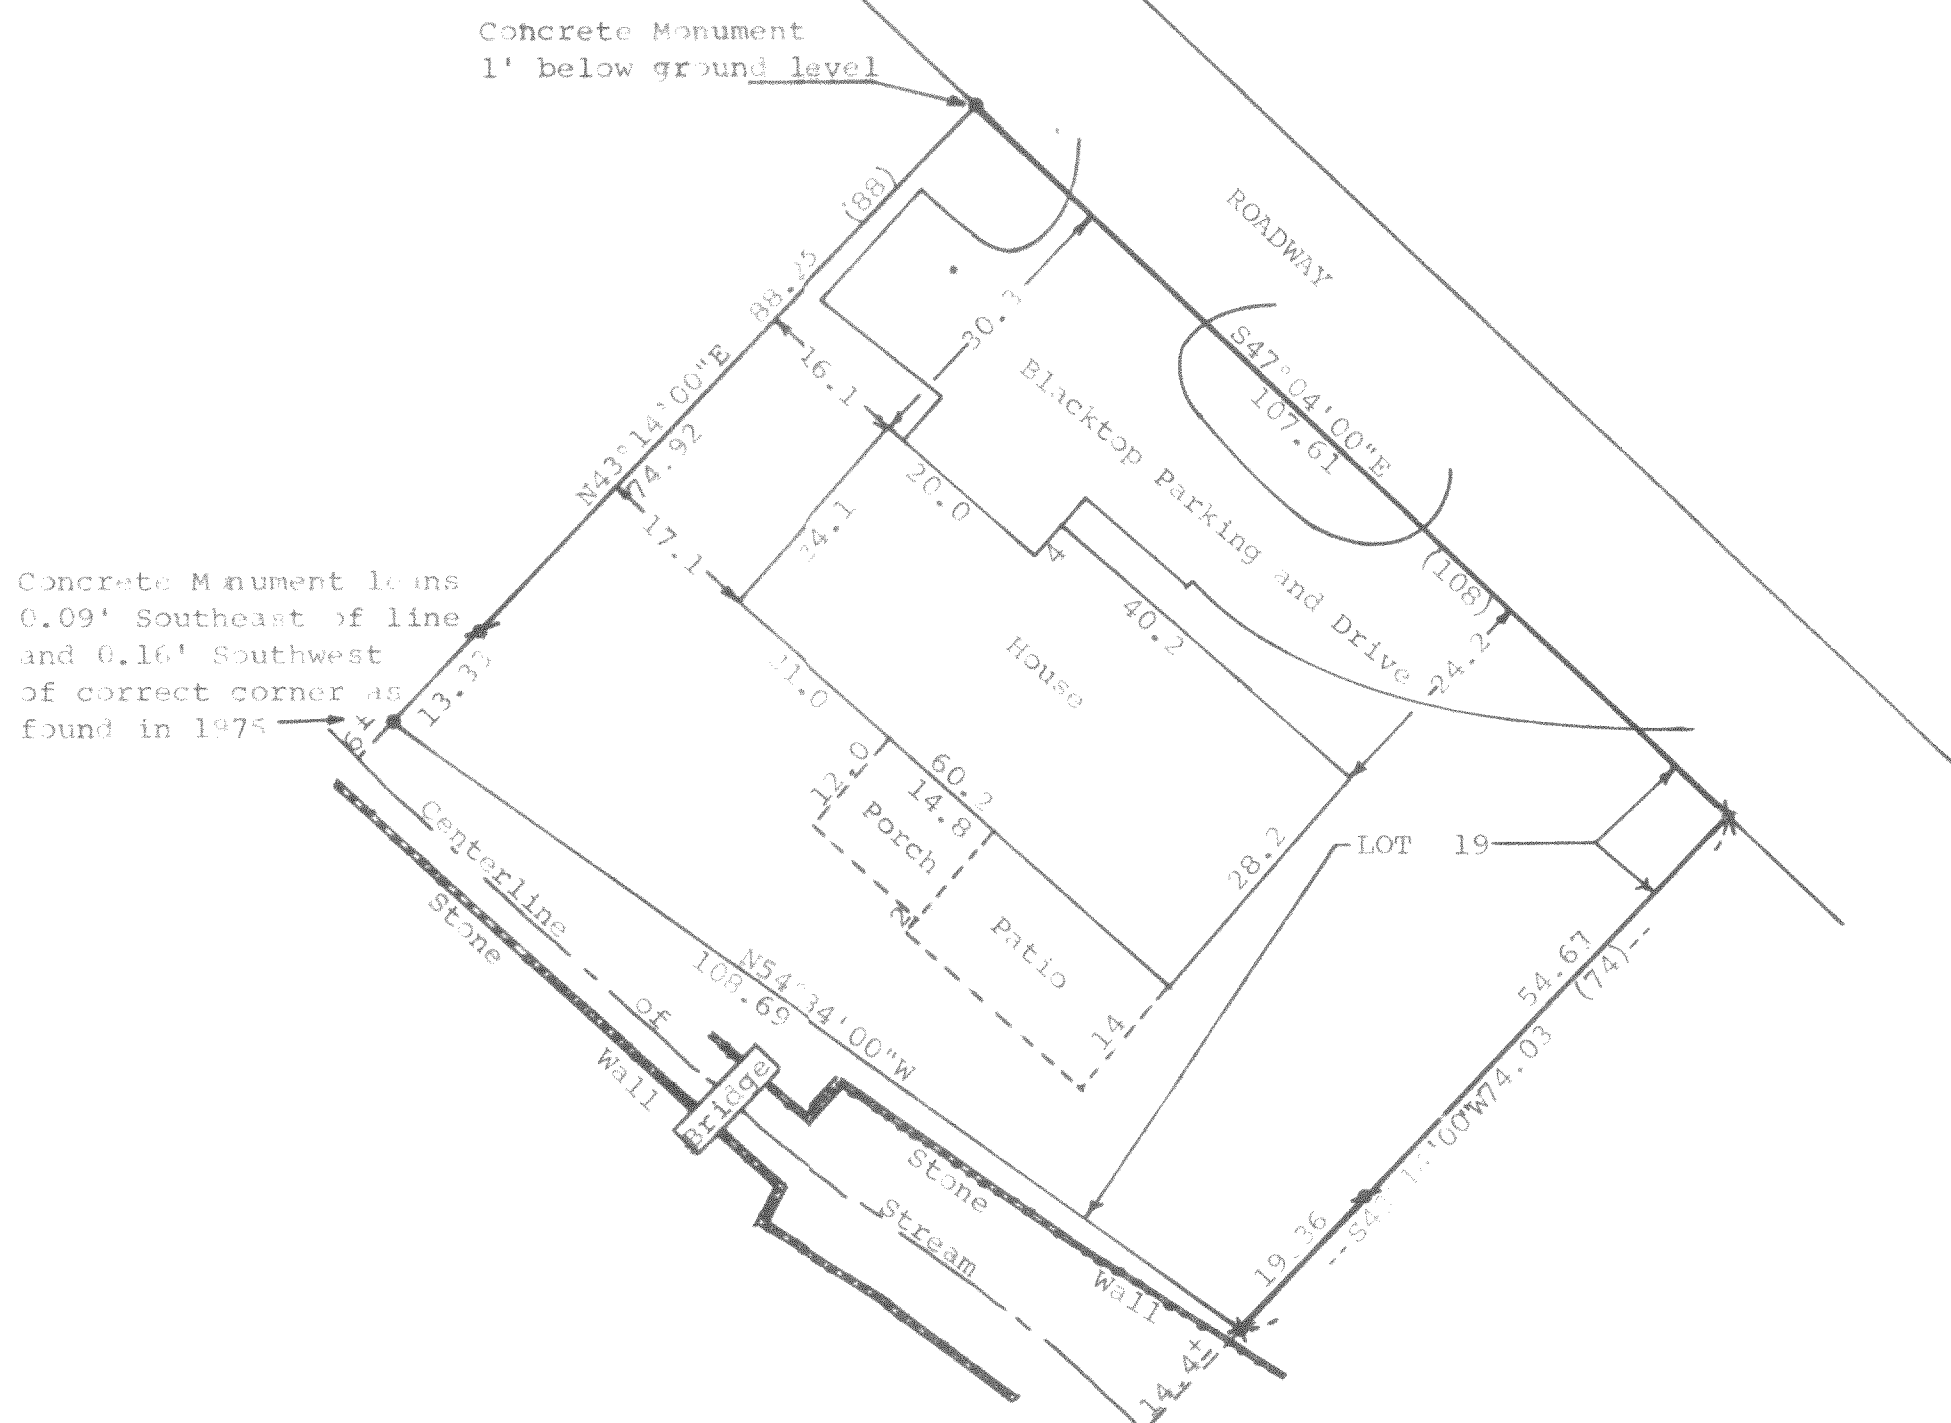

Scale - 1" = 20'

- = Concrete Monument Found 5" Dia.
- = 3/4" Iron Pipe Found
- = 1 1/2" Iron Pipe Found
- = 4" x 4" x 40" Iron Pipe Set

Bearings referenced to bearing recorded along the southwesterly line of the roadway. S47°04'00"E

Owner: Aldo Gianninni
Lower Gardens
Fontana, WI 53125

STATE OF WISCONSIN) SS
COUNTY OF WALWORTH)

I, George T. Dunham, Surveyor, certify that I have surveyed the property described as follows:

Lot 19 of The Gardens as per revised plat recorded June 9, 1927 in Volume 8 of Plats on pages 121 and 122, Walworth County Records, said lot being located in the Northwest 1/4 of Section 11, T 1 N, R 16 E, Village of Fontana on Geneva Lake, Walworth County, Wisconsin,

and that the above map is a true representation thereof and shows the size and location of the property, its exterior boundaries, the location of all visible structures and dimensions of all principal buildings thereon, boundary fences, apparent easements, roadways and visible encroachments, if any.

This survey is made for the use of the present owners of the property, and also those who purchase, mortgage, or guarantee the title thereto within one (1) year from date hereof.

January 7, 1983

George T. Dunham
George T. Dunham, Surveyor

