


O-INDICATES IRON PIPE

DESCRIPTION: Lot 5 of Block "G" of Unit 3 of Country Club Estates Subdivision
in the Village of Fontana, Walworth County, Wisconsin.

CERTIFICATE: I, James F. Biagi, surveyor, do hereby certify that I have
surveyed the property hereon described.

May 25, 1965.

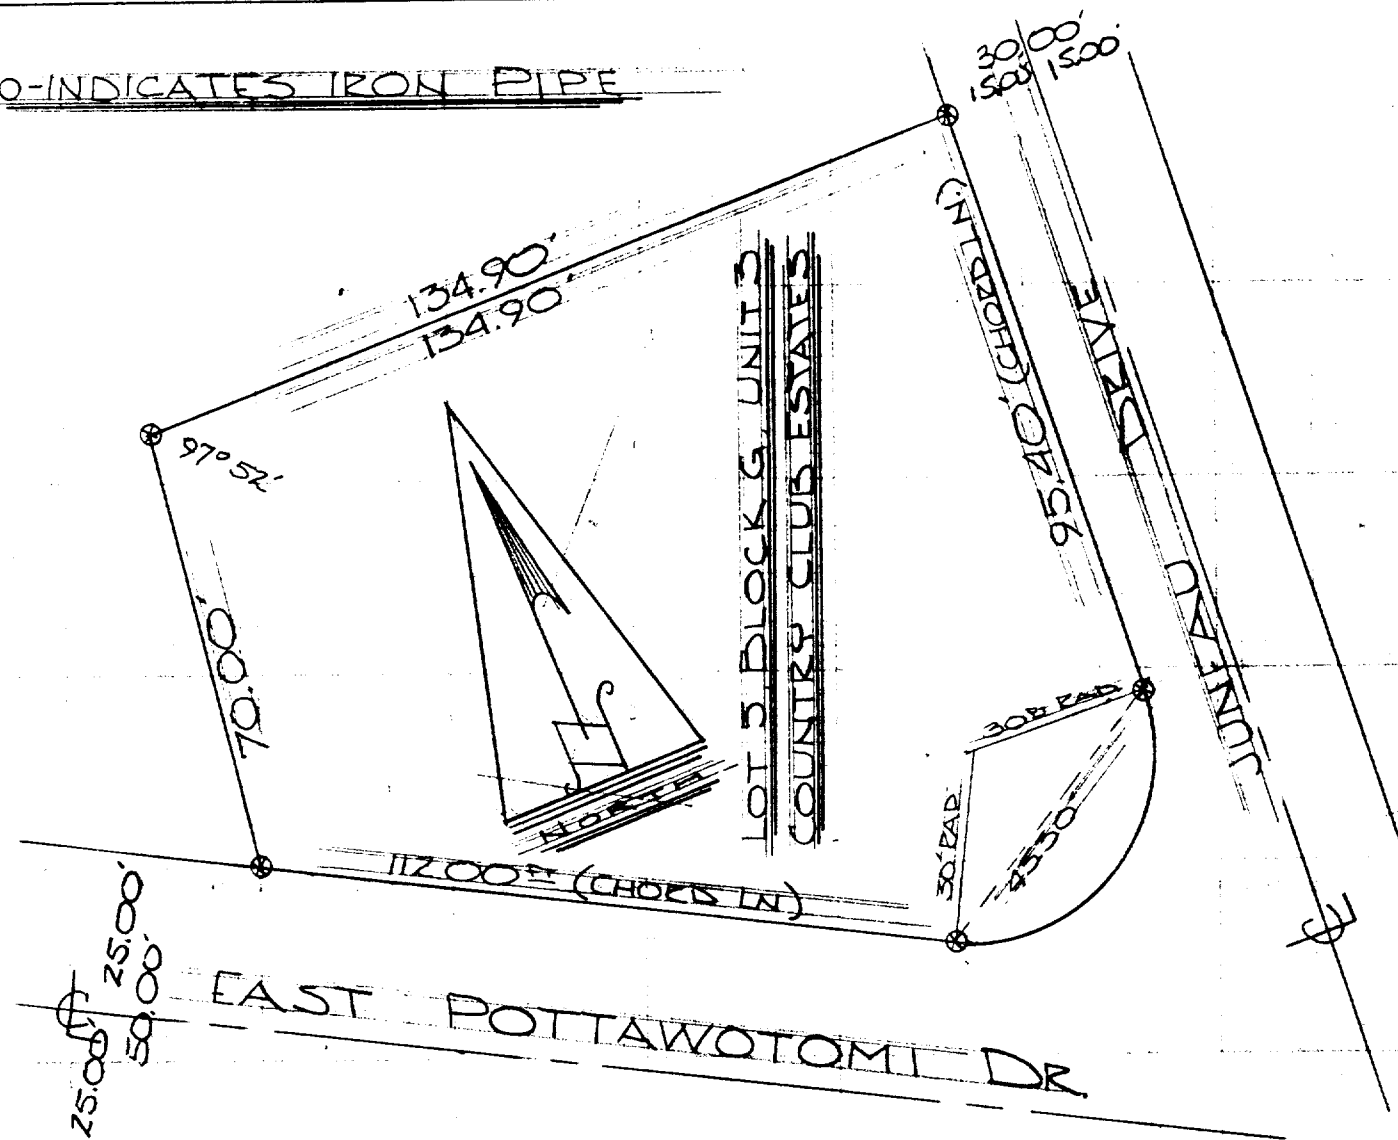

James F. Biagi, RLS 272