


PLAT OF SURVEY OF UNIT 2 LOT 124, COUNTRY CLUB ESTATES LOCATED IN VILLAGE OF FONTANA, NW 1/4 SEC. 23, T1N, R16E WALWORTH COUNTY, WISCONSIN

JENSEN SURVEYING & MAPPING S.C.

PO BOX 322 ELKHORN, WISCONSIN 53121 45 S. WISCONSIN ST.

PHONE: (414) 723-3434

MAPPING DATE: SEPT 20, 1984

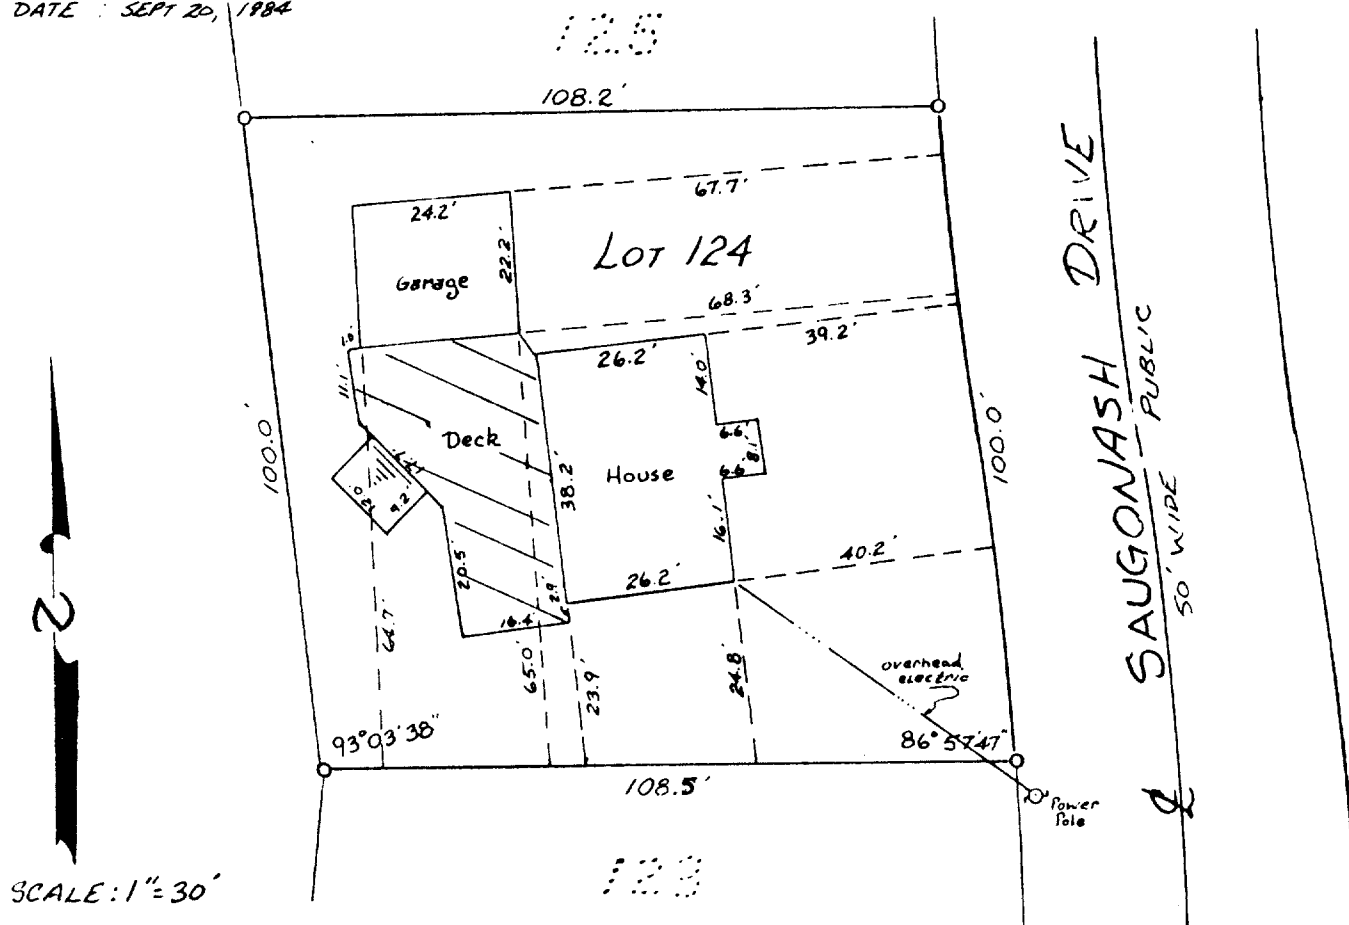

SCALE: 1" = 30'

LEGEND

○ ~ FOUND IRON PIPE

SURVEYED FOR: JACKIE RUST
RT#3 Box 56F
FONTANA, WISCONSIN 53125

I HEREBY CERTIFY THAT THE ABOVE
DESCRIBED PROPERTY HAS BEEN SURVEYED UNDER
MY DIRECTION THAT THE PLAT SHOWN HEREON IS
AN ACCURATE SURVEY, A TRUE REPRESENTATION THEREOF
CORRECTLY SHOWS THE EXTERIOR BOUNDARY LINES ON
SAID PROPERTY AND CORRECT MEASUREMENTS THEREOF
AND BUILDINGS THEREON.

Thomas T.A. Jensen
THOMAS T.A. JENSEN RLS #1084



1984 063

5-601-J ✓