


DUNHAM SURVEYING, S.C.
SURVEYING & SUBDIVIDING
DELAVAN, WISCONSIN 53115

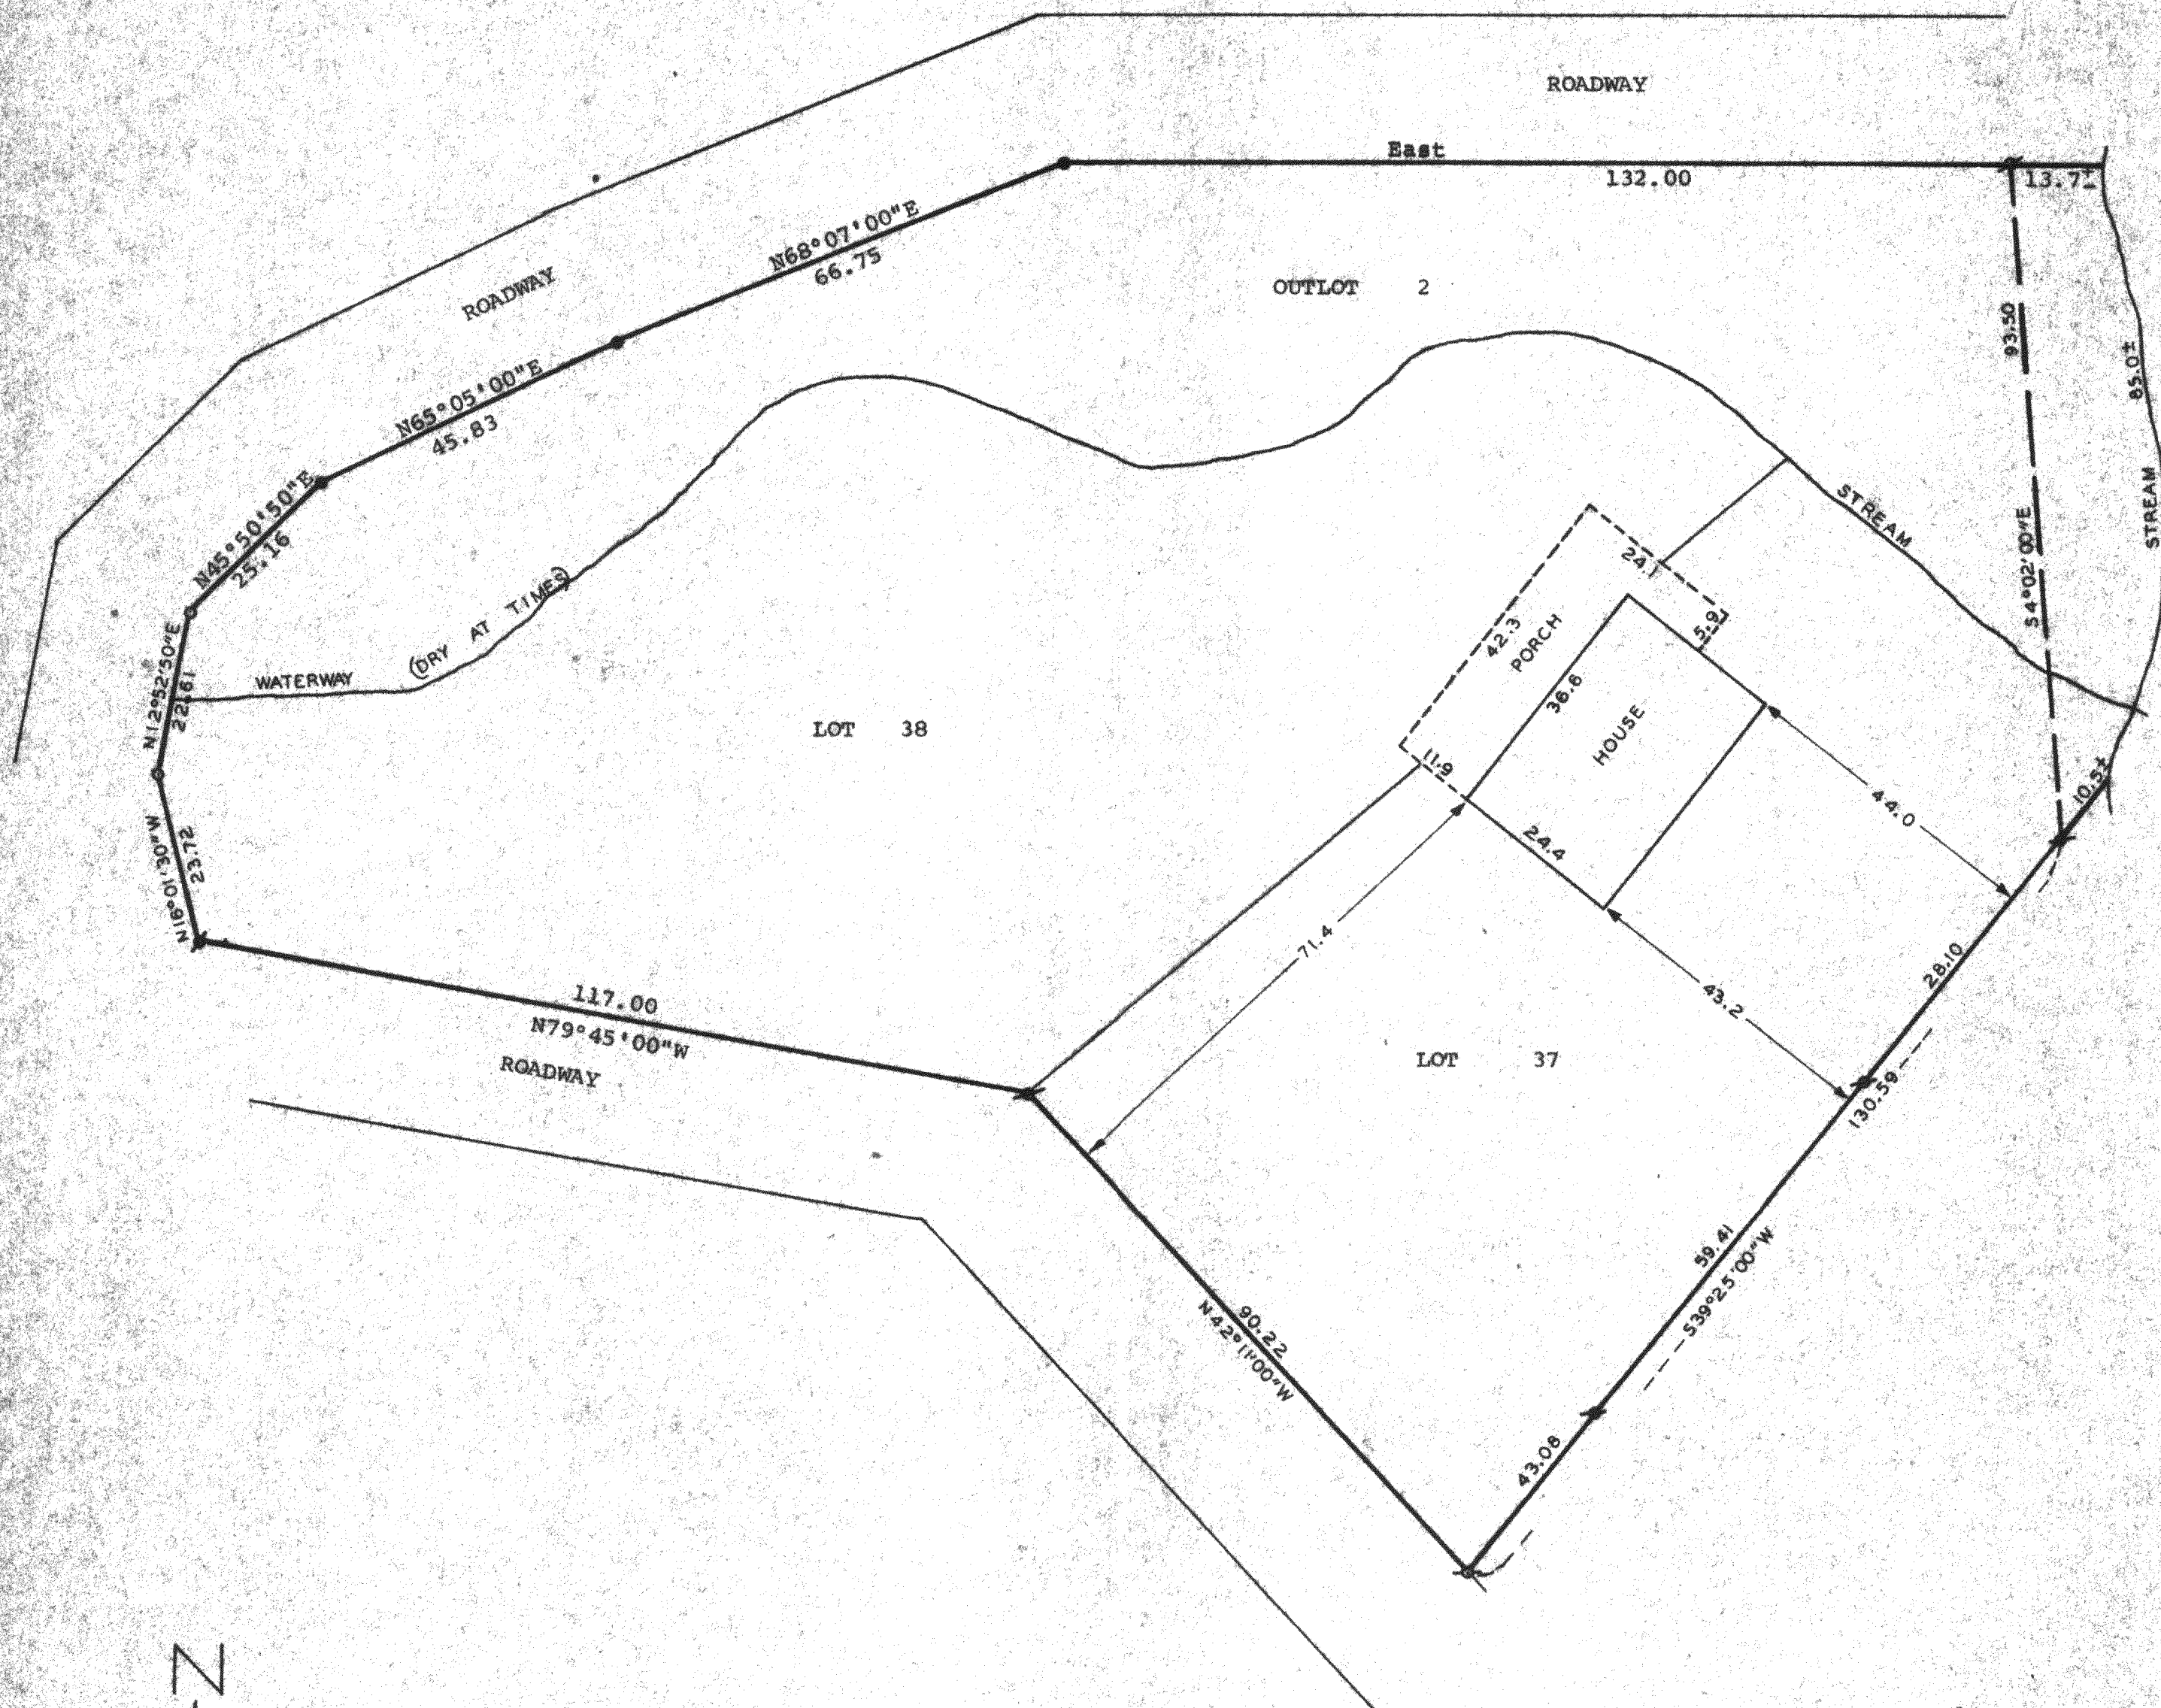

Scale - 1" = 20'

- = Concrete Monument Found
- ✱ = Concrete Monument Found Broken
- ✱ = 1" Iron Pipe Found
- = 3/4"x24" Iron Pipe Set
- = Found Rust Mark and 1"x30" Iron Pipe Set

Bearings are based on the North line of Outlot 2, assumed bearing of East.
Survey Ordered By: Sandra M. Hutchings
N. Lower Gardens Road
Fontana, WI 53125


STATE OF WISCONSIN)
COUNTY OF WALWORTH) SS

I, George T. Dunham, Surveyor, certify that I have surveyed the property described as follows,

Lots 37 and 38 and Outlot No. 2 in the Revised Plat of the Gardens, located in the Village of Fontana on Geneva Lake, Walworth County, Wisconsin,

and that the above map is a true representation thereof and shows the size and location of the property, its exterior boundaries, the location of all visible structures and dimensions of all principal buildings, thereon, boundary fences, apparent easements, roadways and visible encroachments, if any, and that I have surveyed the property hereon described according to the official records, to the best of my knowledge and beliefs,
July 28, 1983.

George T. Dunham
George T. Dunham, Surveyor.

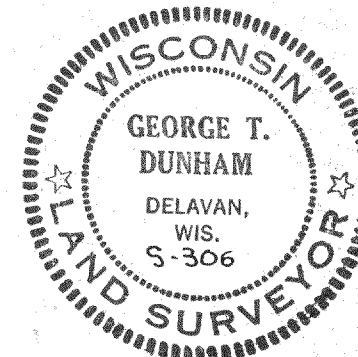

SG-43
SG-44

5-604D