


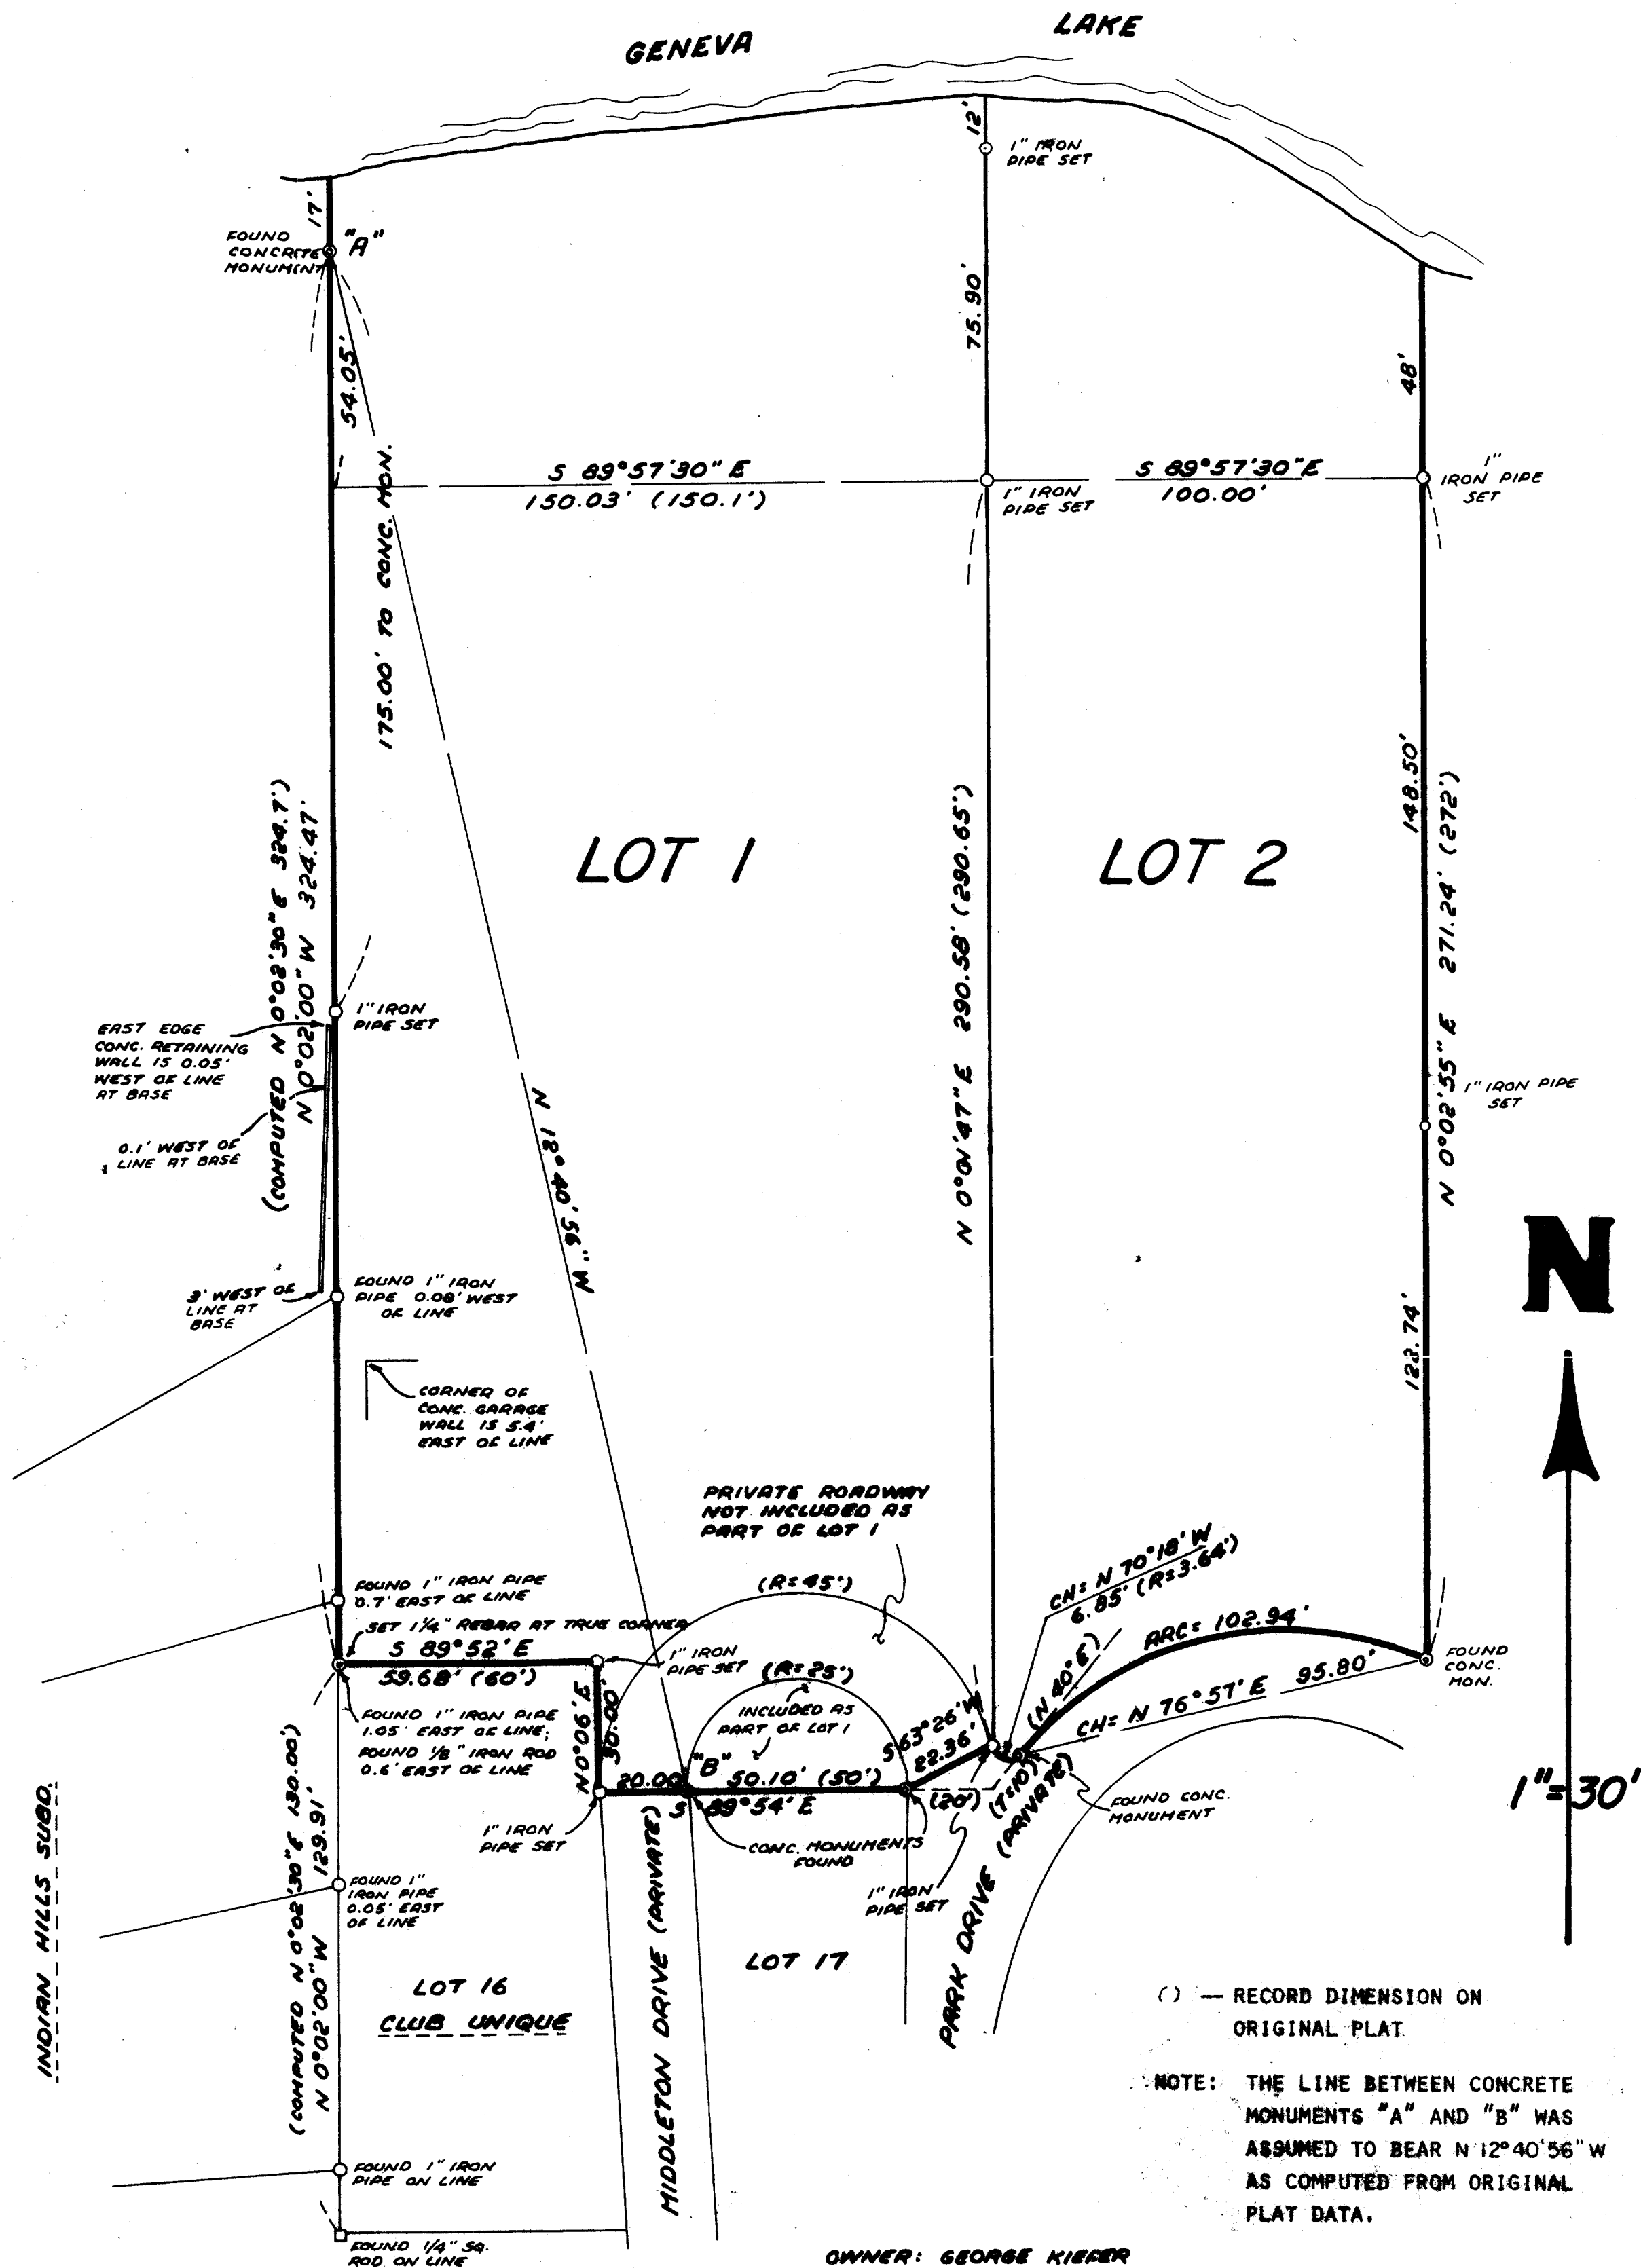

PLAT NO. 2044 OF
 LOTS 1 AND 2, CLUB UNIQUE SUBDIVISION, TOWN 1
 NORTH, RANGE 15, EAST, VILLAGE OF FONTANA,
 WALWORTH COUNTY, WIS.

FARRIS, HANSEN & ASSOCIATES, INC.

ENGINEERING, SURVEYING & LAND PLANNING

715 W. WALWORTH ST. • BOX 487 • BLAINE, WI.

PHONE: 414-723-2086



I HEREBY CERTIFY THAT I HAVE SURVEYED
 THE ABOVE DESCRIBED PROPERTY AND THAT
 THIS PLAT IS A TRUE AND ACCURATE REPRESENTATION
 THEREOF TO THE BEST OF MY PROFESSIONAL KNOWLEDGE AND BELIEF.

William R. Ohberg
 WILLIAM R. OHBERG, RLS NO. 1679

DATED THIS 4TH DAY OF FEB., 1983.

PROJECT NO. 2044