

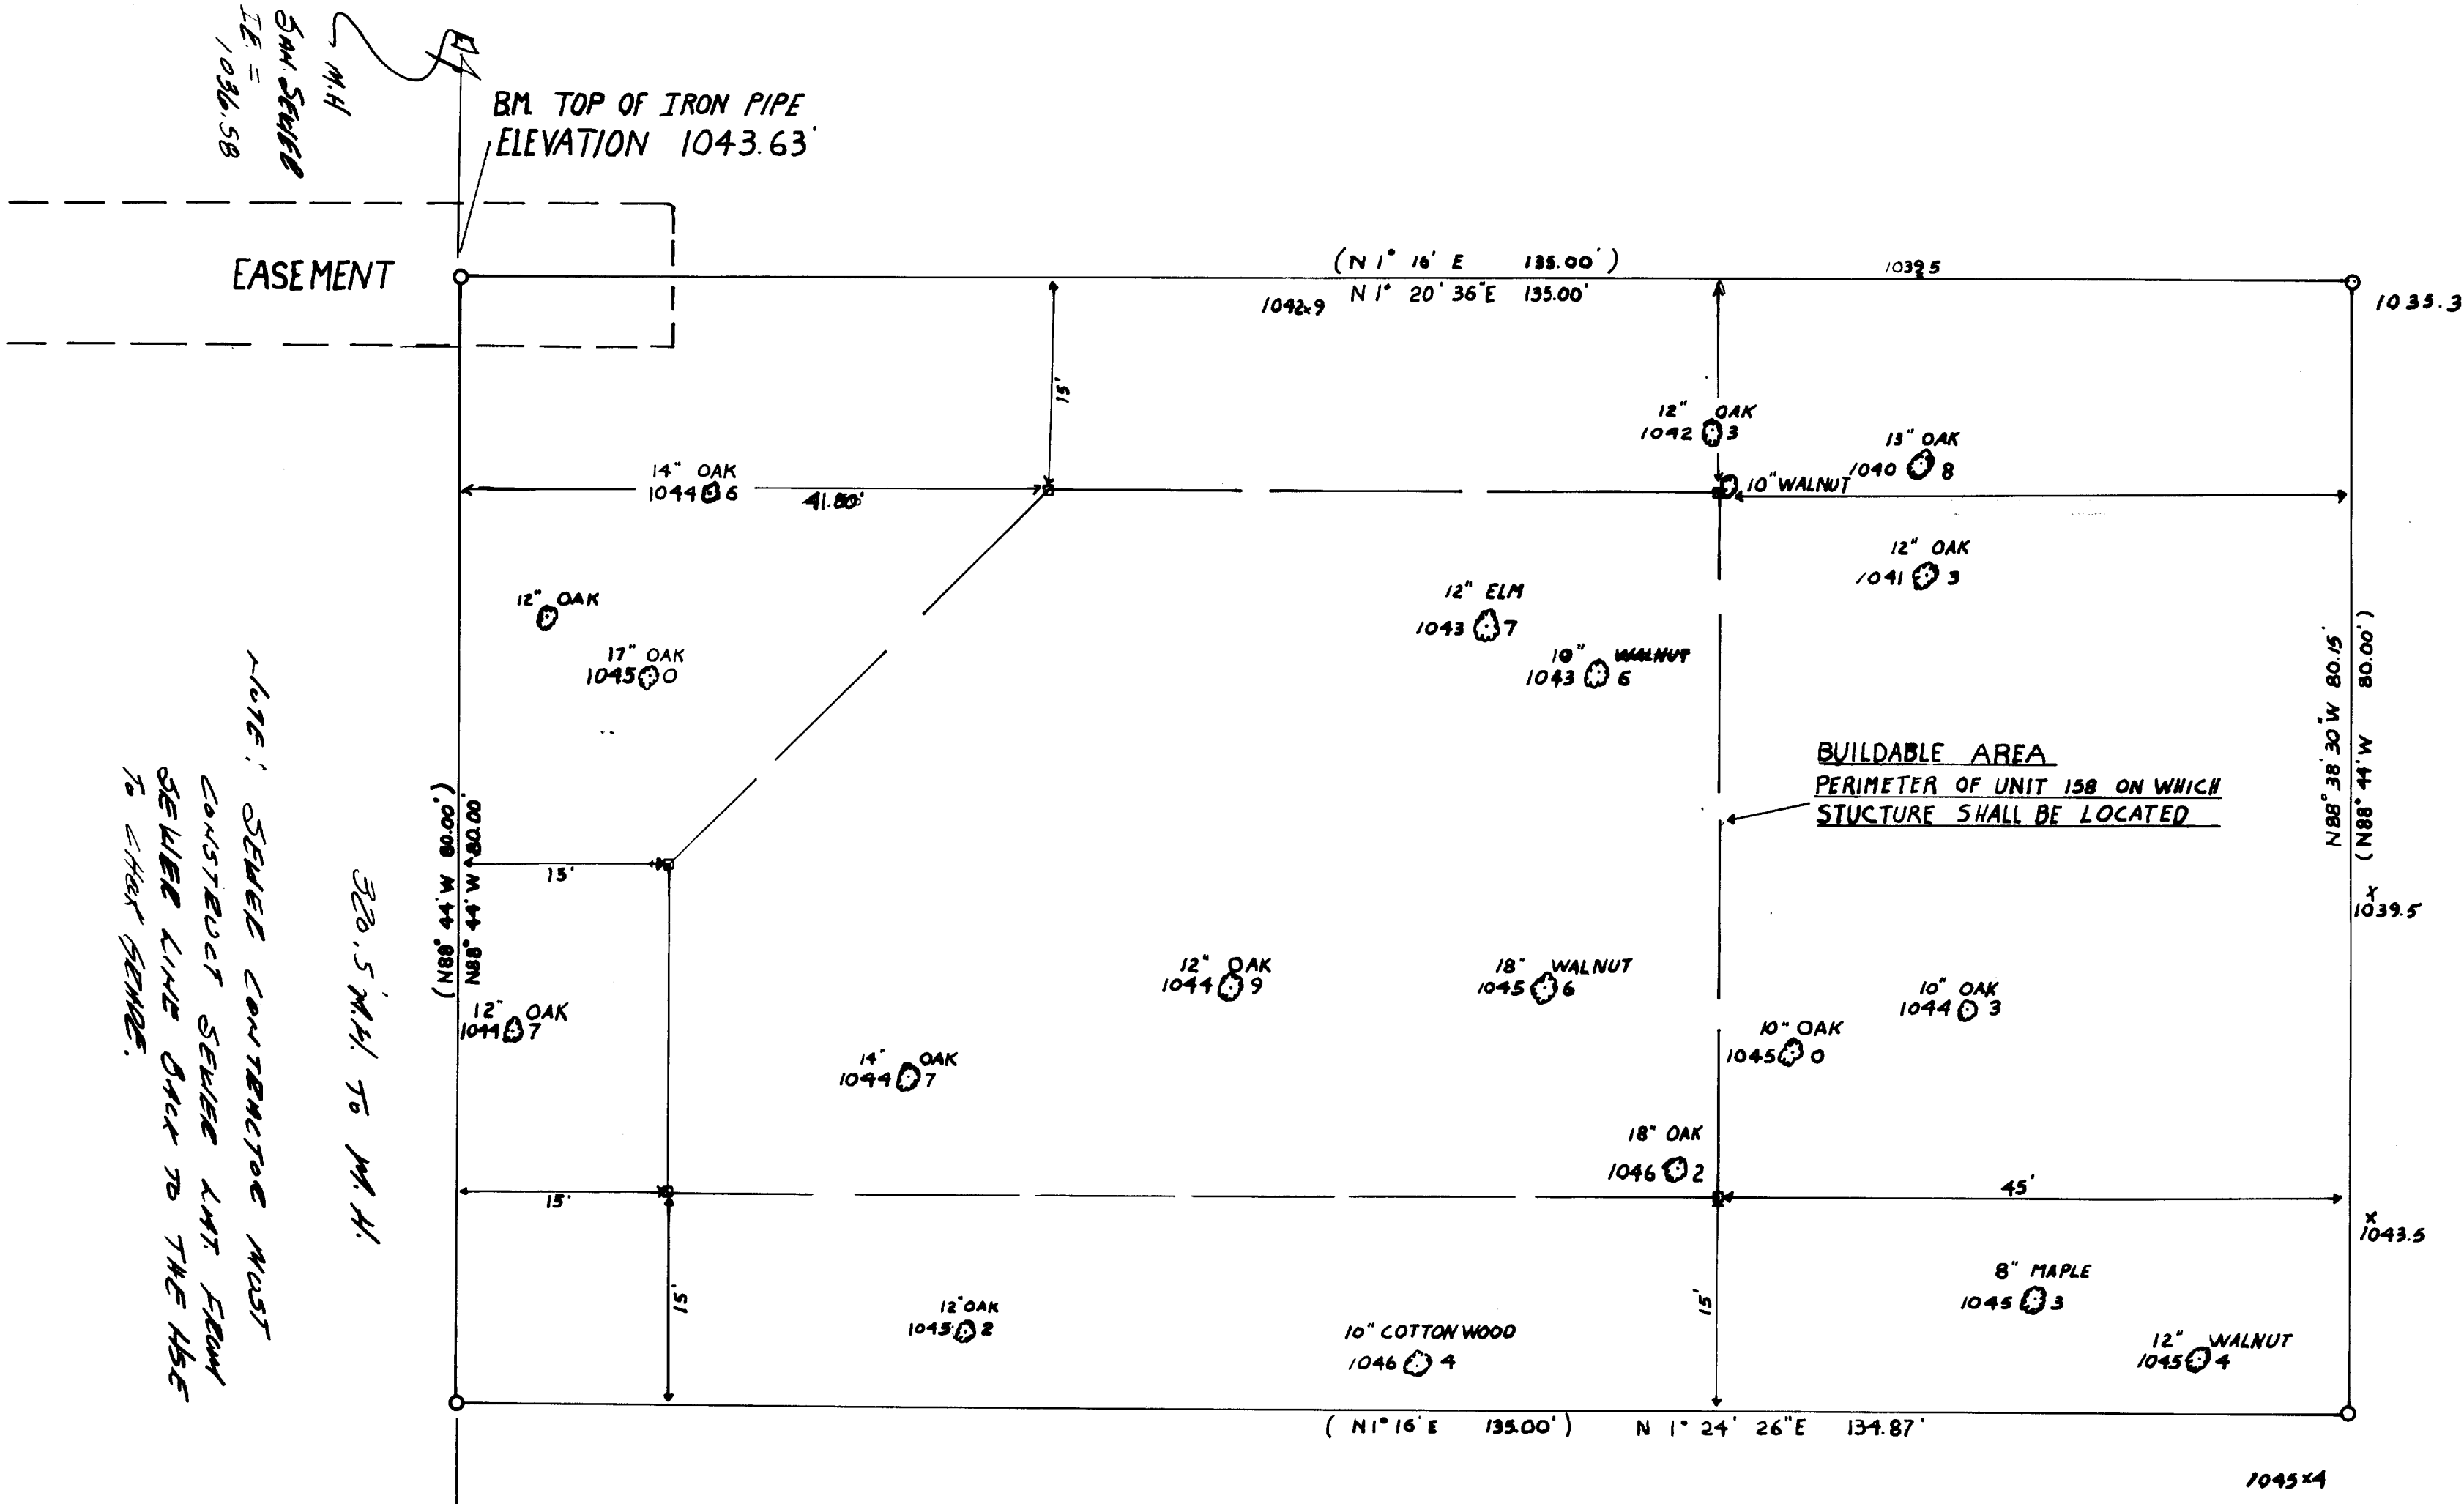


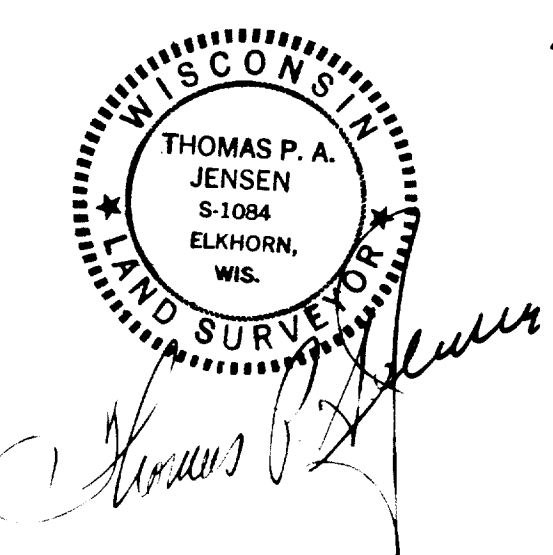

LEGEND

- FOUND IRON PIPE
- ⊙ TREE
- () RECORDED AS
- SET LATH

SCALE 1" = 10'

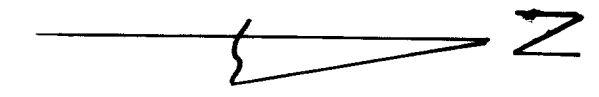

PLAT OF SURVEY OF UNIT 158 OF
 ABBEY SPRINGS CONDOMINIUM NO. II
 VILLAGE OF FONTANA-ON-LAKE GENEVA
 WALWORTH COUNTY, WISCONSIN
 MAPPING DATE: 5-30-83
 1983.023

JENSEN SURVEYING & MAPPING S.C.
 P.O. BOX 322
 ELKHORN, WI 53121
 (414) 723-3434
 SURVEYED BY: THOMAS P.A. JENSEN R.L.S. #1084
 SURVEYED FOR: ROBERT E. DUKE
 111 SOUTH WILSHIRE LANE
 ARLINGTON HEIGHTS ILL. 60004



NOTE: SEWER CONSTRUCTION MUST
 CONSTRUCT SEWER LAY FROM
 SEWER LINE BACK TO THE HSE
 TO CHECK SENSE.

320.5' M.H. TO M.H.
 320.5' M.H. TO M.H.
