


MAP SCALE IN FEET

UNIT 46

MERS. $N 3^{\circ} 27' W$ 152.00'

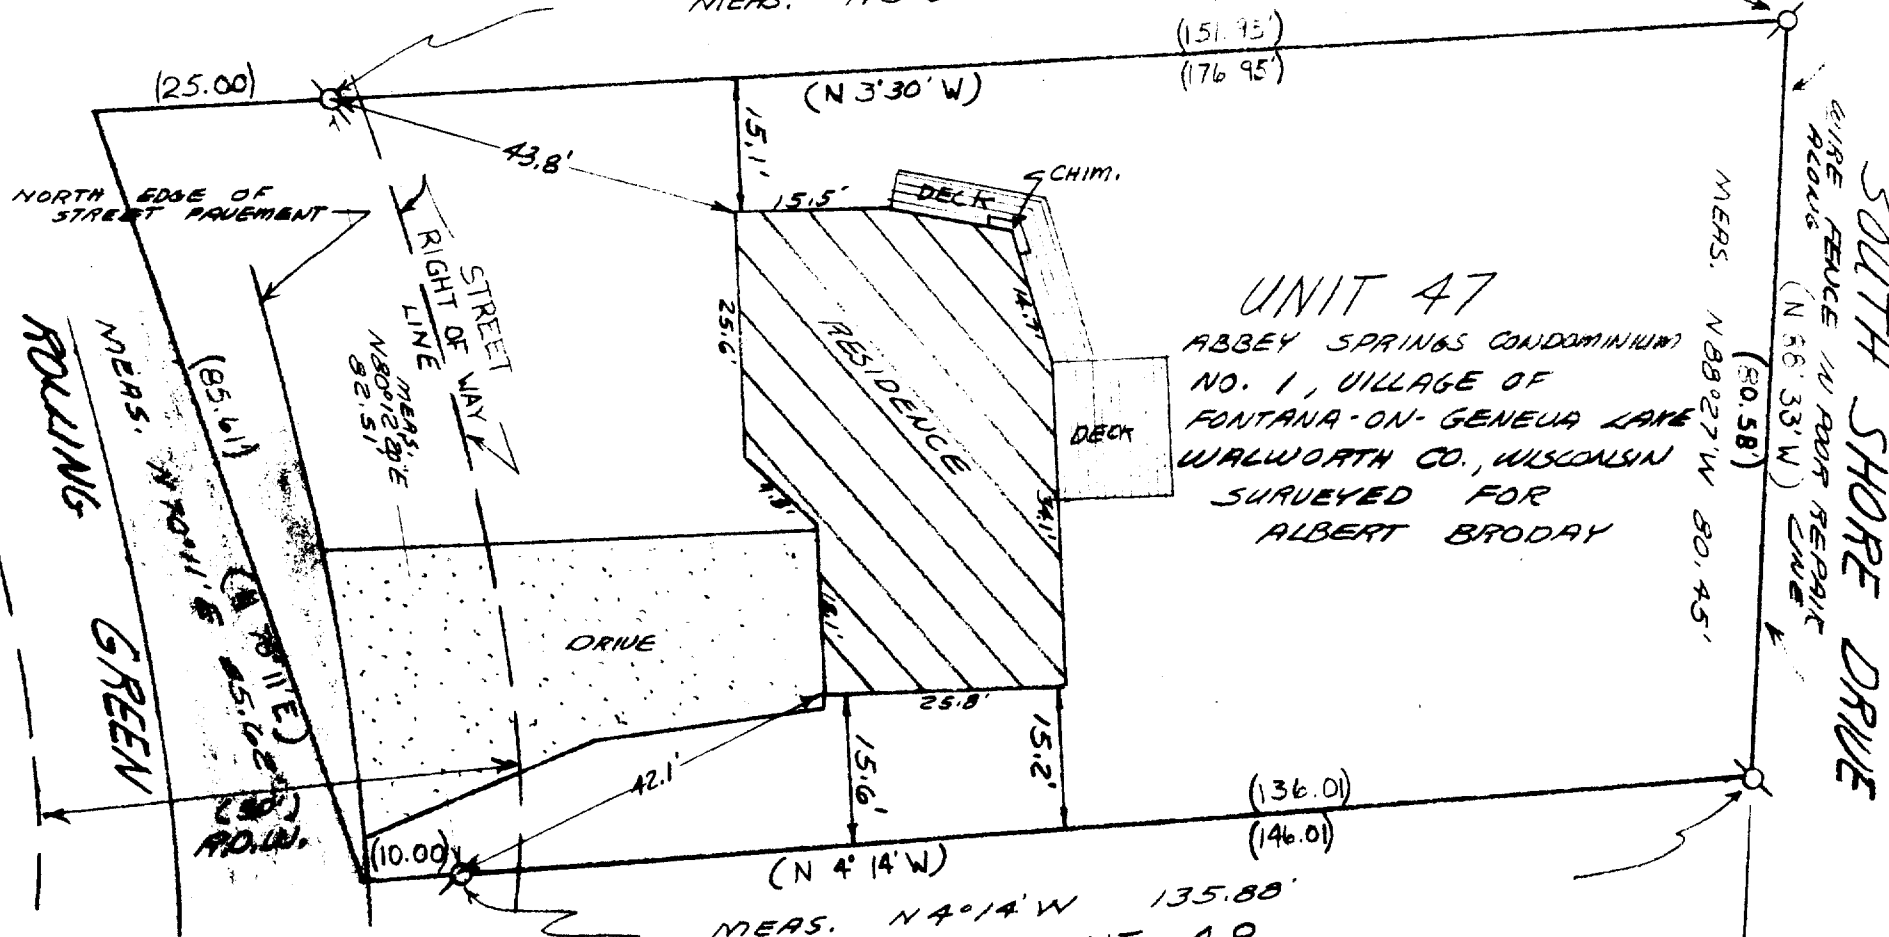


This survey is made for the use of the present owners of the property, and also those who purchase, mortgage, or guarantee the title thereto within one (1) year from date hereof.

Robert H. Thomas

DATED 9 DEC. 1983

UNIT 48

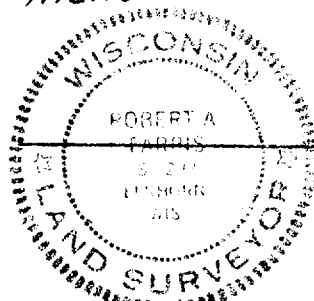

FARRIS, HANSEN & ASSOCIATES, INC.
715 W. Walworth St. P.O. Box 487
Elkhorn, WI 53121

DRAWING NUMBER 2189