


WHITEWATER, WISCONSIN 53190

Concrete Sidewalk Encroaches

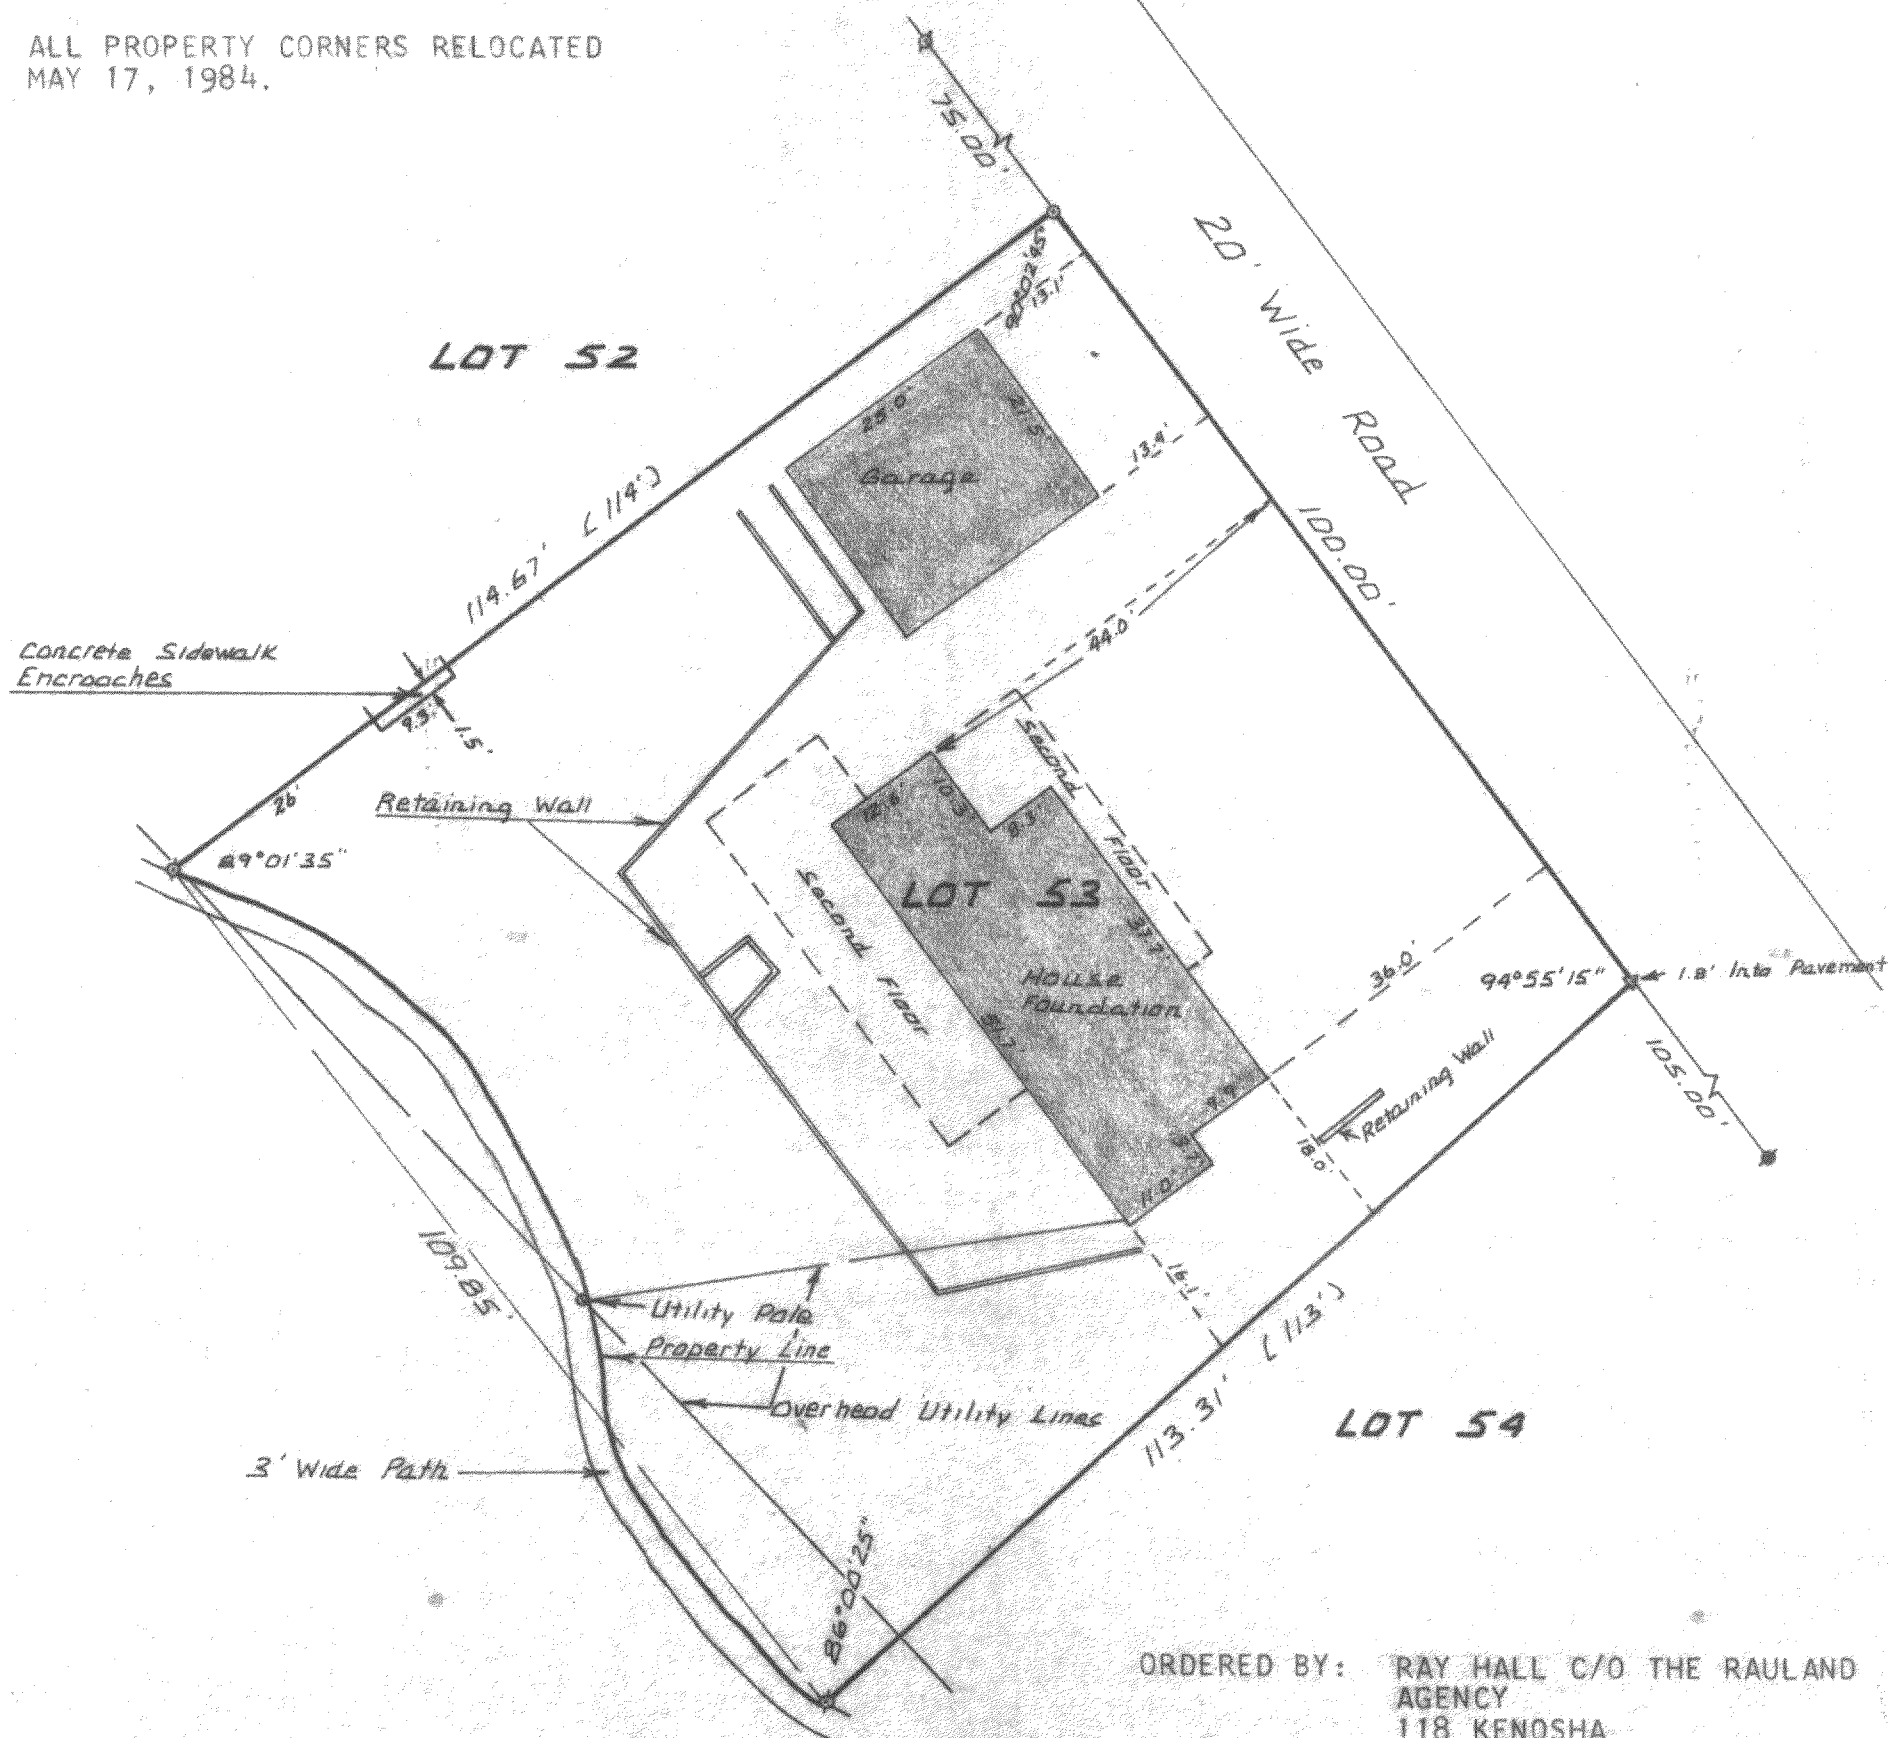


ORDERED BY: RAY HALL C/O THE RAULAND
AGENCY
118 KENOSHA
WALWORTH, WI 53184

LOT 53, THE GARDENS SUBDIVISION, SECTION 11,
TOWN 1 NORTH, RANGE 16 EAST, VILLAGE OF
FONTANA-ON-GENEVA LAKE, WALWORTH COUNTY,
WISCONSIN.



- Ø - IRON PIPE FOUND
- o - IRON PIPE SET
- Δ - CONCRETE MONUMENT FOUND
- ▲ - FOUND NAIL SET IN PAVEMENT
- () - RECORDED AS

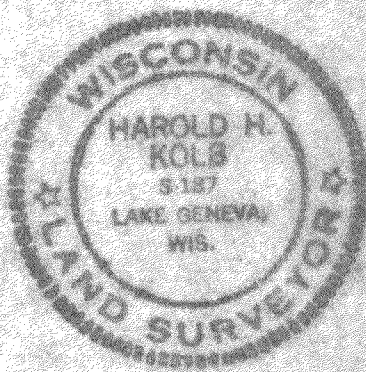

I HEREBY CERTIFY THAT I HAVE SURVEYED THE ABOVE DESCRIBED PROPERTY AND THAT THE ABOVE MAP IS A TRUE REPRESENTATION THEREOF AND SHOWS THE SIZE AND LOCATION OF THE PROPERTY, ITS EXTERIOR BOUNDARIES, THE LOCATION OF ALL VISIBLE STRUCTURES AND DIMENSIONS OF ALL PRINCIPAL BUILDINGS THEREON, BOUNDARY FENCES, APPARENT EASEMENTS, ROADWAYS AND VISIBLE ENCROACHMENTS, IF ANY. THIS SURVEY IS MADE FOR THE USE OF THE PRESENT OWNERS OF THE PROPERTY, AND ALSO THOSE WHO PURCHASE, MORTGAGE, OR GUARANTEE THE TITLE THERETO WITHIN ONE (1) YEAR FROM DATE HEREOF. MAY 17, 1984

Harold H. Kolb
HAROLD H. KOLB
WISCONSIN REGISTERED LAND SURVEYOR, S-187
DATE Sept. 12, 1980
REVISED: MAY 17, 1984

56-53

5-612-K

FOU-81 A