

HAROLD H. KOLB

REGISTERED PROFESSIONAL LAND SURVEYOR
LAKE GENEVA, WISCONSIN


MAY 8, 1984

RELOCATED THE FOUR CORNER
CONCRETE MONUMENTS ON LOT
13, AND SET IRON PIPE, 1"
X 24" ON THE NORTH LINE.
IRON PIPE "A" ON EAST
LINE IS MISSING.

Harold H. Kolb

HAROLD H. KOLB

ORDERED BY:
MAGGIE MC CANN
ROUTE 3, BOX 128
FONTANA, WI. 53125

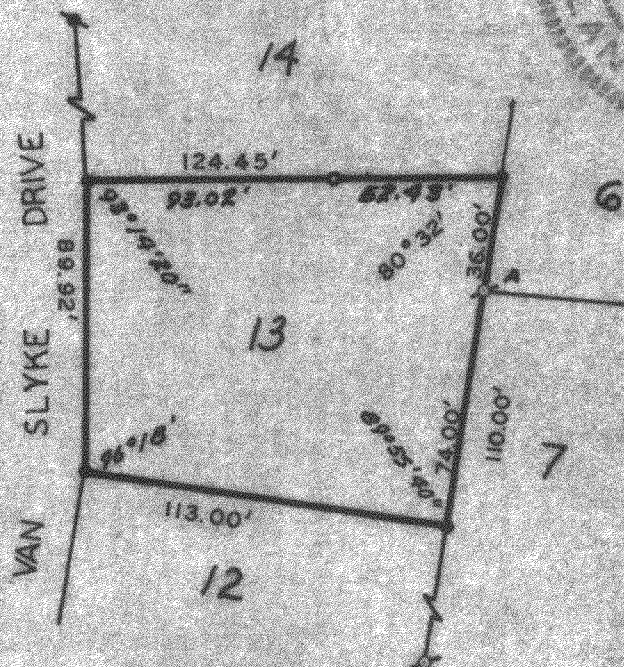

PLAT OF SURVEY OF

Lot 13, Block E, Unit 3, Country Club
Estates, a subdivision located in the
Village of Fontana-on-Geneva Lake,
Walworth County, Wisconsin.



LEGEND

- IRON PIPE FOUND
- — IRON PIPE PLACED
- CONCRETE MONUMENT FOUND
- x — SPIKE
- — CONCRETE MONUMENT PLACED

SCALE: 1" = 60'

I, HAROLD H. KOLB, DO HEREBY CERTIFY THAT I HAVE
SURVEYED THE PROPERTY HEREON DESCRIBED ACCORDING
TO THE OFFICIAL RECORDS, AND THAT THE PLAT HEREON
IS A CORRECT REPRESENTATION OF THE LOT LINES.

Harold H. Kolb

HAROLD H. KOLB

WISCONSIN REGISTERED LAND SURVEYOR, S-187

DATE May 25, 1966

5-619

SC03-00090