

ABERNATHY and ASSOCIATES**Kenneth B. Abernathy Jr.****Wisconsin Registered Land Surveyor S-1594**

Rt. 3, Box 273

Elkhorn, Wisconsin 53121

Phone: (414) 723-4260 (office)

(414) 723-4813 (residence)



PLAT OF SURVEY

Lots 1, 2 and 3 of Block B of COUNTRY CLUB ESTATES SUB., Unit No.
Located in Sections 14 and 23, T.1N., R.16E, Village of Fontana,
Walworth County, Wisconsin.

Ordered by: Lowell Sweet
114 N. Church St.
Elkhorn, Wi. 53121

Owned by: Setonia B. Mitchell
4402 Hally Rd.
Virginia Beach, Va. 23451

Vol. 8 of Plats P. 108
Slide 77 Cab. 2

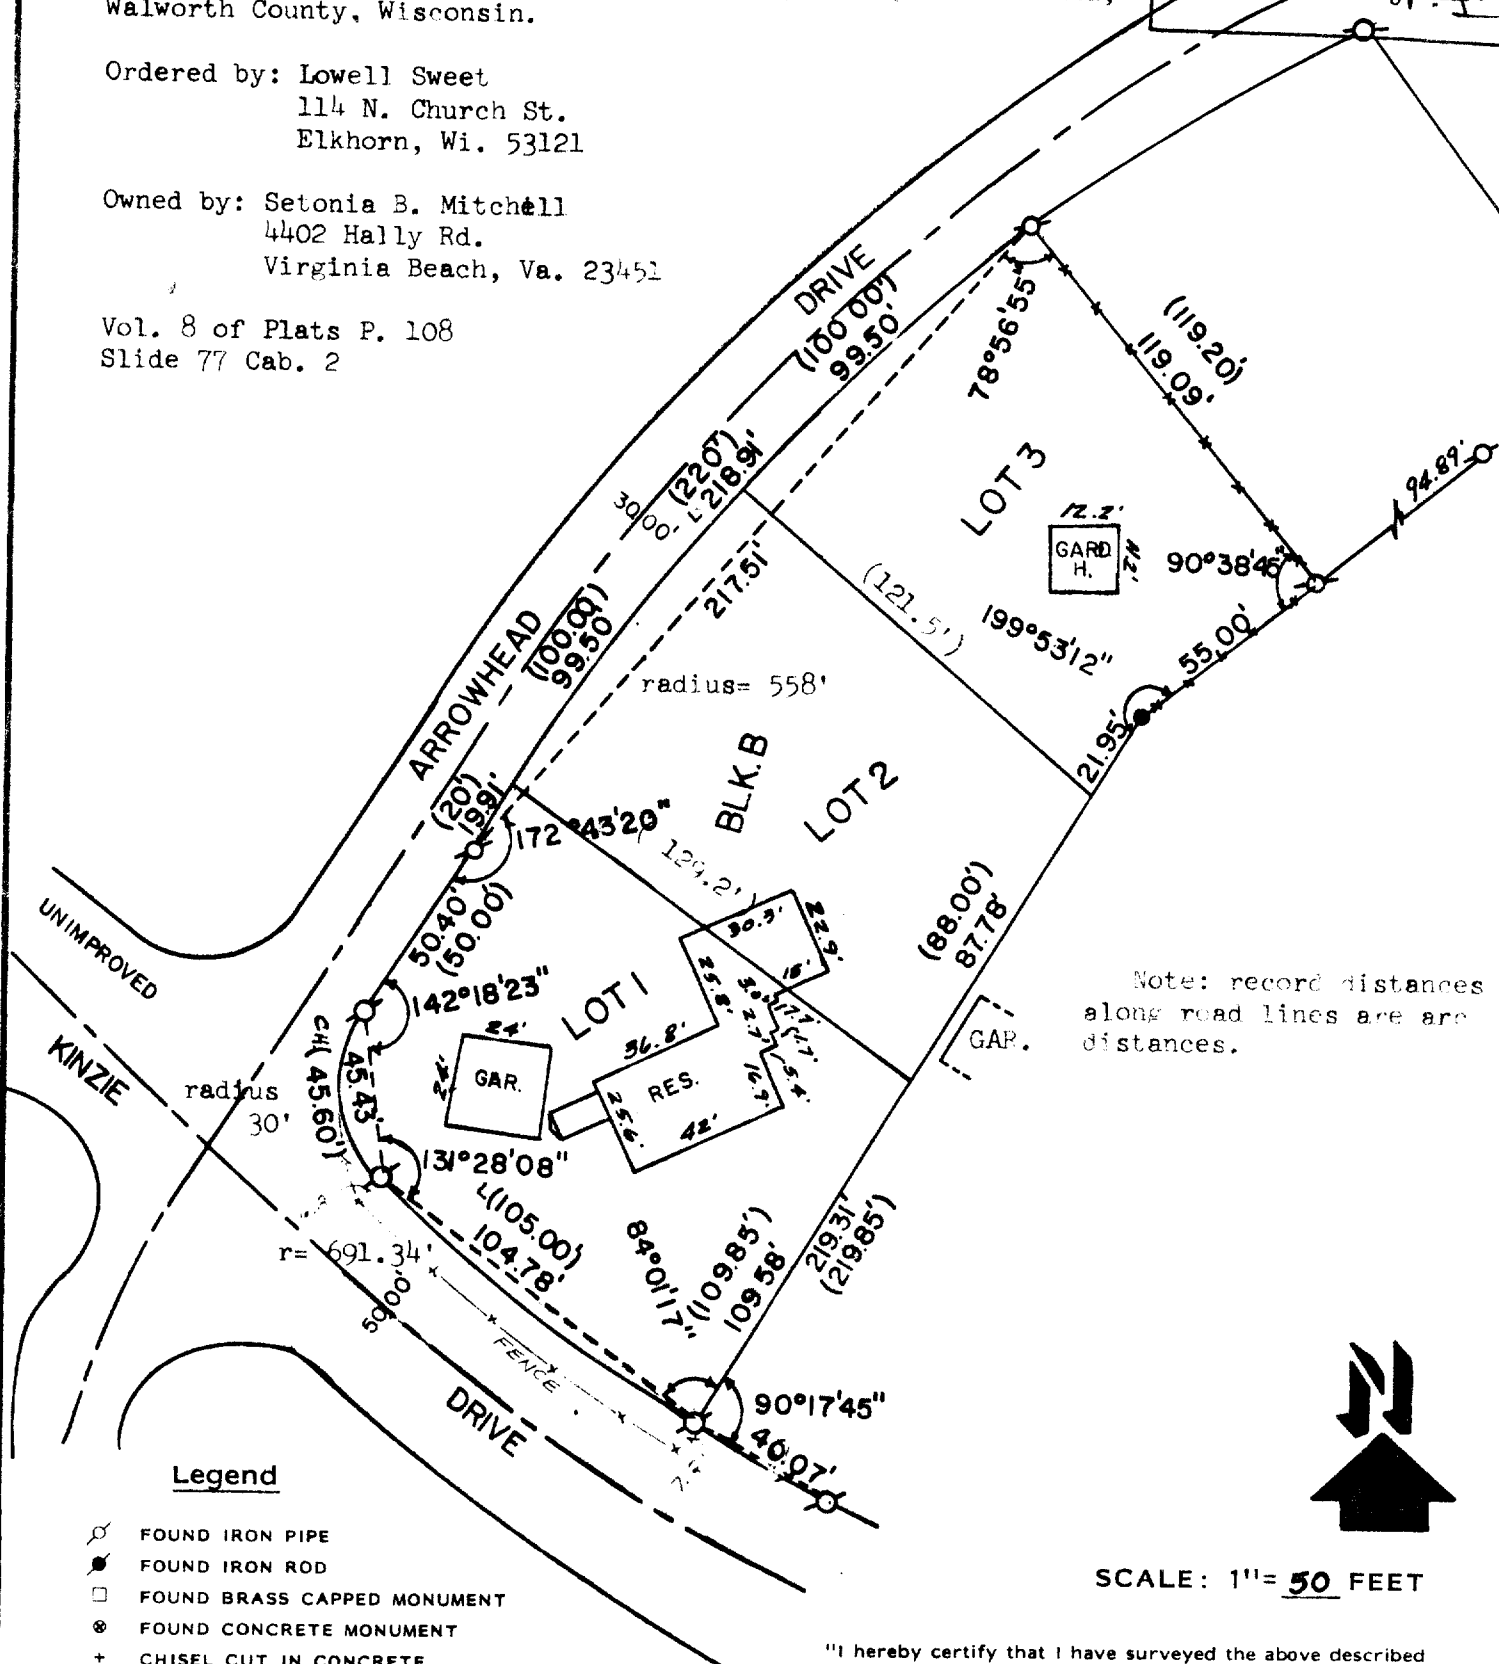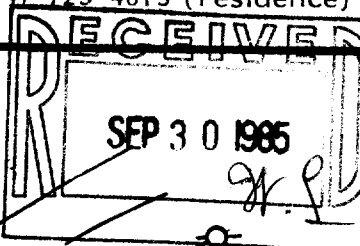

Note: record distances
along road lines are arc
distances.

Legend

- FOUND IRON PIPE
- FOUND IRON ROD
- FOUND BRASS CAPPED MONUMENT
- ⊙ FOUND CONCRETE MONUMENT
- + CHISEL CUT IN CONCRETE
- SET IRON ROD, 24" LONG, WEIGHING
1.5 LBS./LINEAL FT., 3/4" DIA.
- SET IRON ROD, 30" LONG, WEIGHING
4.5 LBS./LINEAL FT., 1-11/16" DIA.
- (xx) RECORDED AS DIMENSION
- x-x- EXISTING FENCE


SCALE: 1" = 50 FEET

"I hereby certify that I have surveyed the above described
property and that the above map is a true representation
thereof and shows the size and location of the property, its
exterior boundaries, the location of all visible structures
and dimensions of all principal buildings thereon, boundary
fences, apparent easements, roadways and visible encroach-
ments, if any."

"This survey is made for the use of the present owners of
the property, and also those who purchase, mortgage, or
guarantee the title thereto within one year from date
hereof."

KENNETH B. ABERNATHY, JR.
WISCONSIN REGISTERED LAND SURVEYOR,
S-1594

Date: SEPT. 23, 1985 Job No. 902

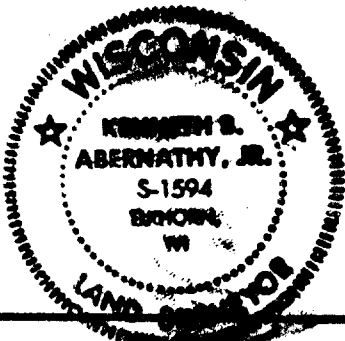

5003-21 + 5003-22

5-641