




AMERICAN SURVEYING COMPANY, INC.


LAND SURVEYORS
11931 Hwy. "K"
FRANKSVILLE, WISCONSIN
TEL. NO. (414) - 835-4774

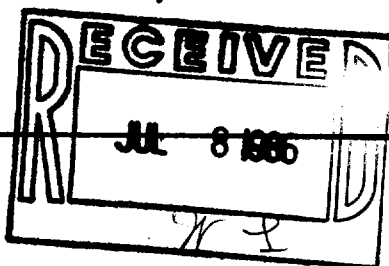

PLAT OF SURVEY

PREPARED FOR: Badger Home Builders, Inc.

DESCRIPTION: Lot 1, Block 4, BROOKWOOD SUBDIVISION, Village of Fontana-on-Geneva Lake,
Walworth County, Wisconsin

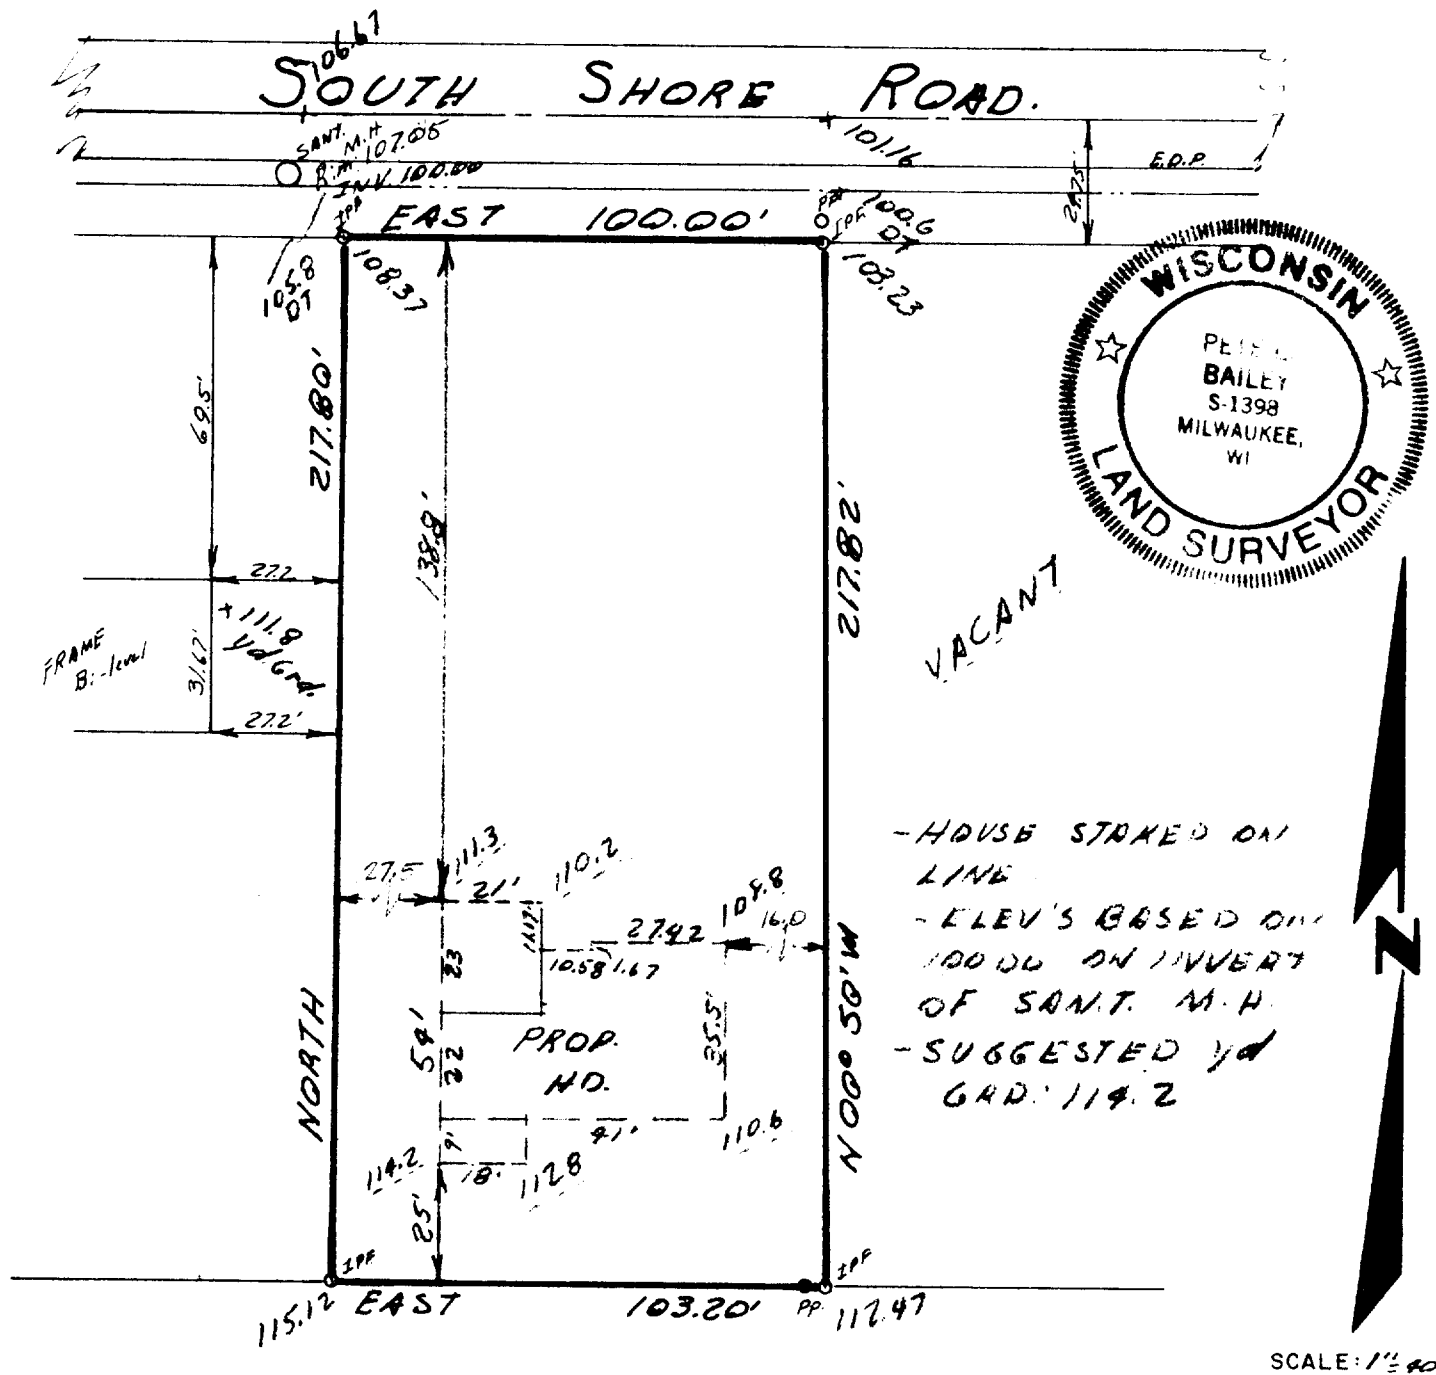

Revised 4-12-86

STATE OF WISCONSIN
COUNTY OF RACINE

I hereby certify that I have surveyed the above described property and the above map is a true representation thereof and shows the size and location of the property, its exterior boundaries, the location of all visible structures and dimensions of all principle buildings thereon, boundary fences, apparent easements, roadways and visible encroachments, if any.

This survey is made for the present owners of the property, and also those who purchase, mortgage, or guarantee the title thereto within one (1) year from the date thereof.

Dated at NORTH CAPE, this 20TH day of MARCH, 1986

Recertified

Peter L. Bailey
Registered Land Surveyor