
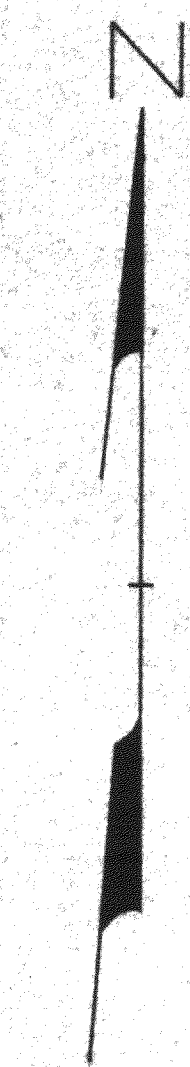
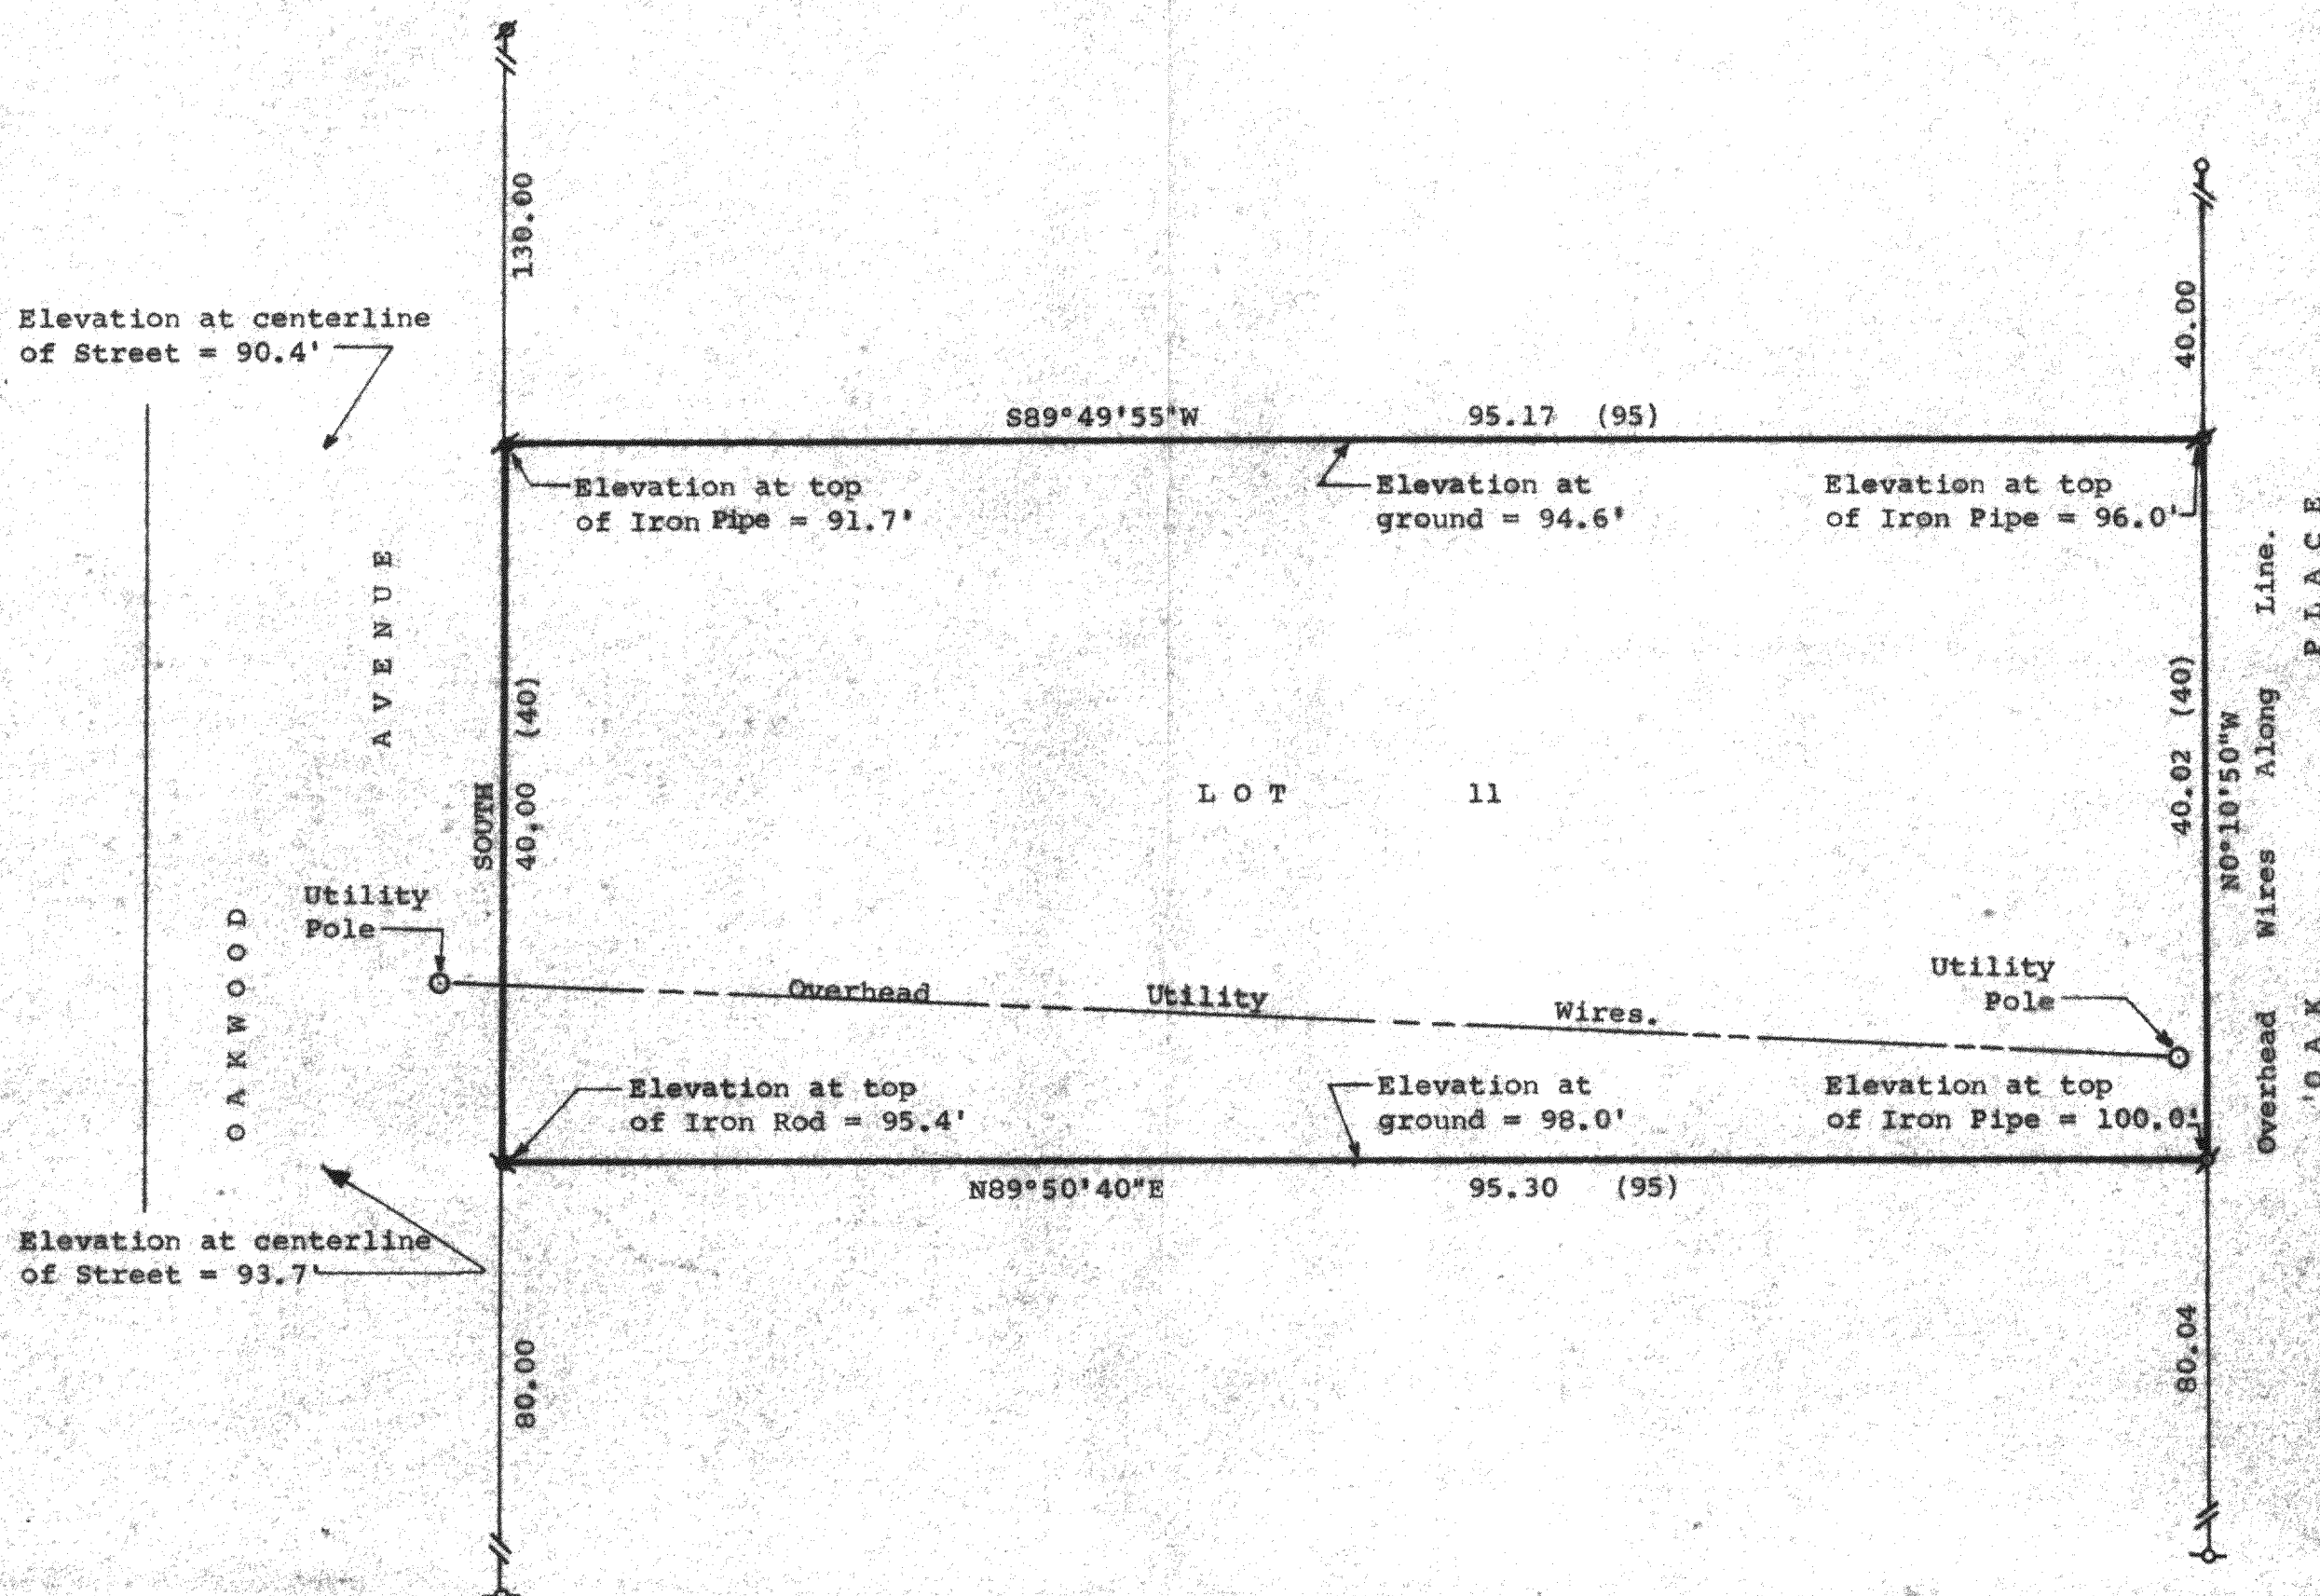


DUNHAM SURVEYING, S.C.
SURVEYING & SUBDIVIDING
DELAVER, WISCONSIN 53115

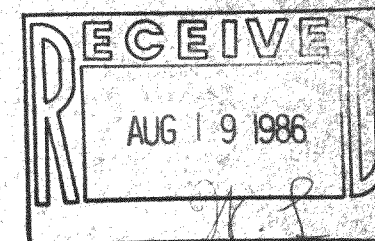

STATE OF WISCONSIN) SS
COUNTY OF WALWORTH)

I, George T. Dunham, Surveyor, certify that I have surveyed the property described as follows,

Lot 11, Block 12 of Glenwood Springs, a subdivision located in the Village of Fontana, Walworth County, Wisconsin, and that the map shown above is a true representation thereof and shows the size and location of the property, its exterior boundaries, the location of all visible structures and dimensions of all principal buildings thereon, boundary fences, apparent easements, roadways and visible encroachments, if any, and that I have surveyed the property hereon described according to the official records, to the best of my knowledge and belief.
July 27, 1984.

George T. Dunham
George T. Dunham, Surveyor

Scale - 1" = 10'
 ● = 1 1/2" Dia. Iron Pipe Found
 ● = 1" Dia. Iron Rod Found
 ● = 1" Dia. Iron Rod Found and Reset
 ○ = 3/4" Dia. Iron Pipe Found
 ○ = 3/4"x24" Iron Pipe Set
 ○ = 1/2" Dia. Iron Rod Found
 (0.00) = Recorded Distance
 ● = 1 1/2" Dia. Iron Pipe Found
 Bearings are referenced to the East line of Oakwood Avenue, assumed bearing of South.
 Owner: Pat Nicholson
 Rt. 1 Box 239
 Fontana, Wisconsin 53125

