

FARRIS, HANSEN & ASSOCIATES, INC.
7 RIDGEWAY COURT ELKHORN, WI
414-723-2098



SURVEY



Plat of Survey of **UNIT 411 OF ABBEY SPRINGS
CONDOMINIUM NO. 14
VILLAGE OF FONTANA, WIS.**

WORK ORDERED BY: VISNER CONSTRUCTION

MAP SCALE IN FEET
0 10 20 30 40 50 60 70 80 90 100

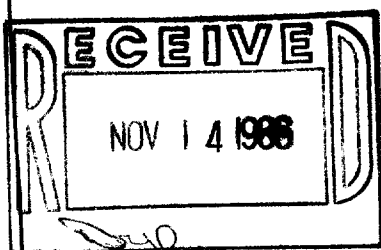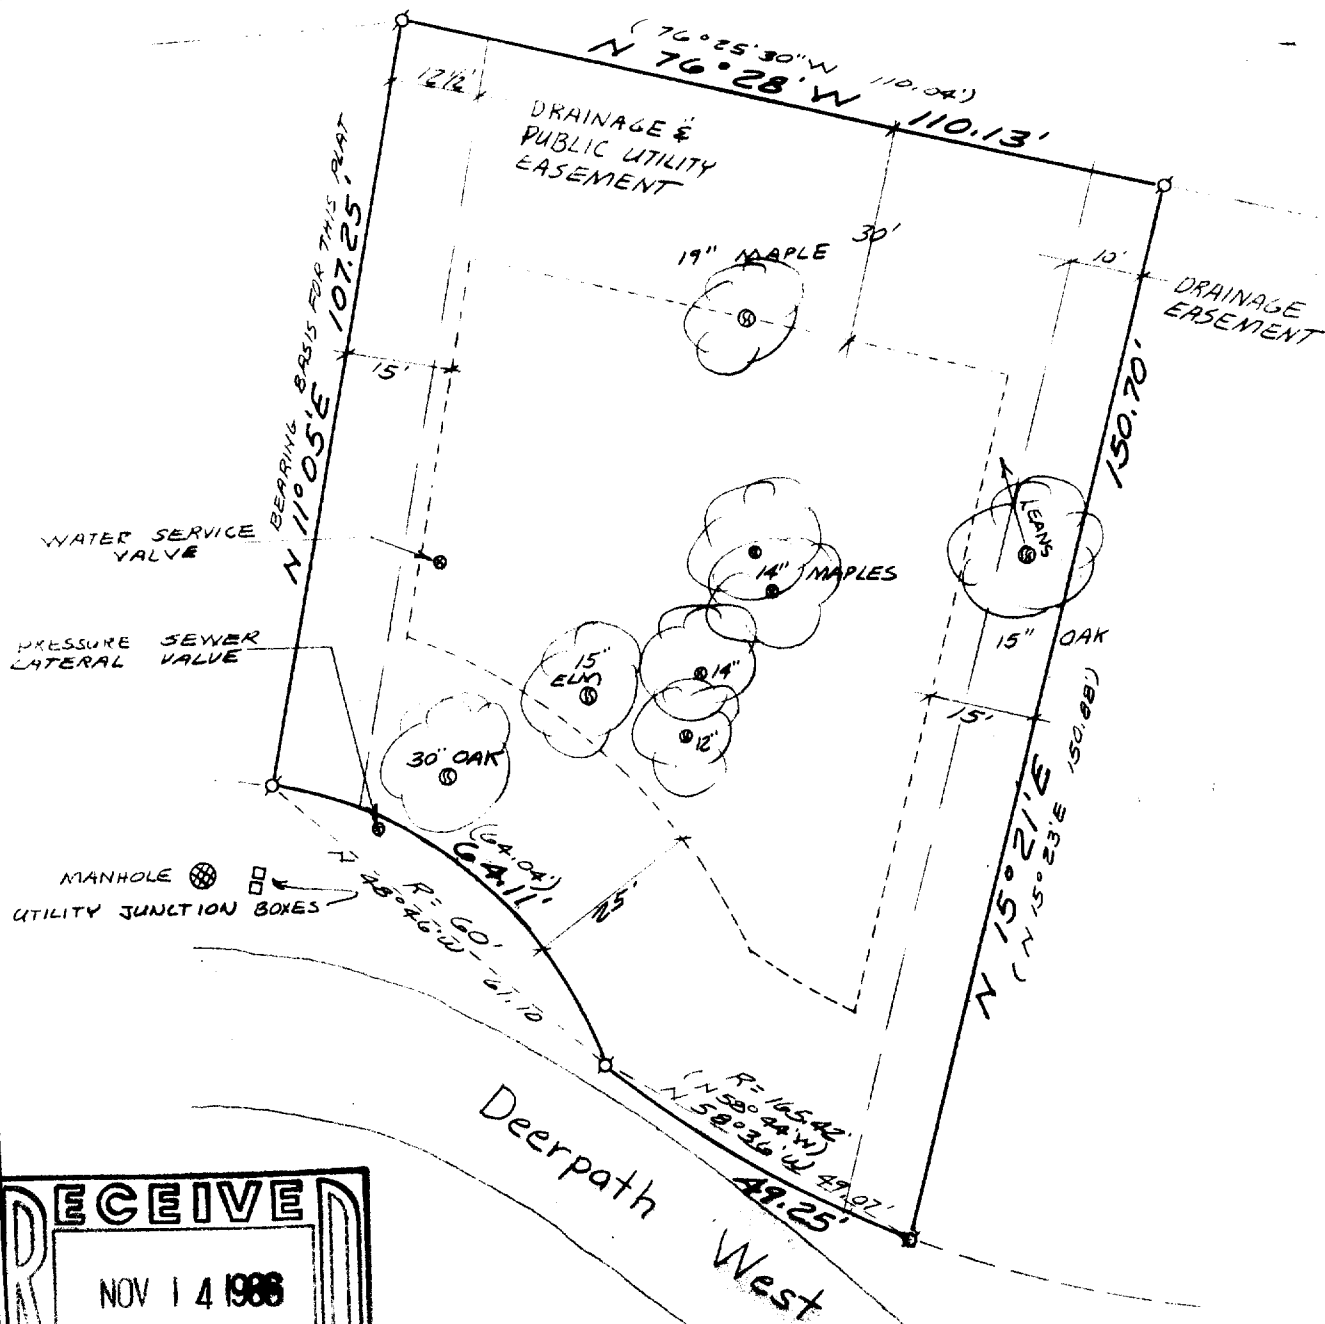

LEGEND

- Ø = Iron Pipe Survey Stake Found
- O = Iron Pipe Survey Stake Set
- (XXX) = Record Dimension
- = Building Limits
- TREES OVER 6\"/>

CERTIFICATE

I hereby certify that the above described property has been surveyed under my direction and that the above map is a true representation thereof and shows the size and location of the property, its exterior boundaries, the location of all visible structures and dimensions of all principal buildings thereon, boundary fences, apparent easements, roadways and visible encroachments, if any. This survey is made for the use of the present owners of the property, and also for those who purchase, mortgage, or guarantee the title thereto within one (1) year from the date hereof.

Robert A. Farris
Robert A. Farris, R.L.S.

Dated this 17th day of OCTOBER 1986

PROJECT NO. 2678

