


FARRIS, HANSEN & ASSOCIATES, INC.
7 RIDGEWAY COURT, ELKHORN, WI
414-723-2098

PLAT OF SURVEY OF
UNIT 116 OF ABBEY SPRINGS CONDOMINIUM
LOCATED IN SEC. 18, T. 1N., R. 17E., VILLAGE OF FONTANA-ON-GENEVA LK.
WALWORTH COUNTY, WISCONSIN

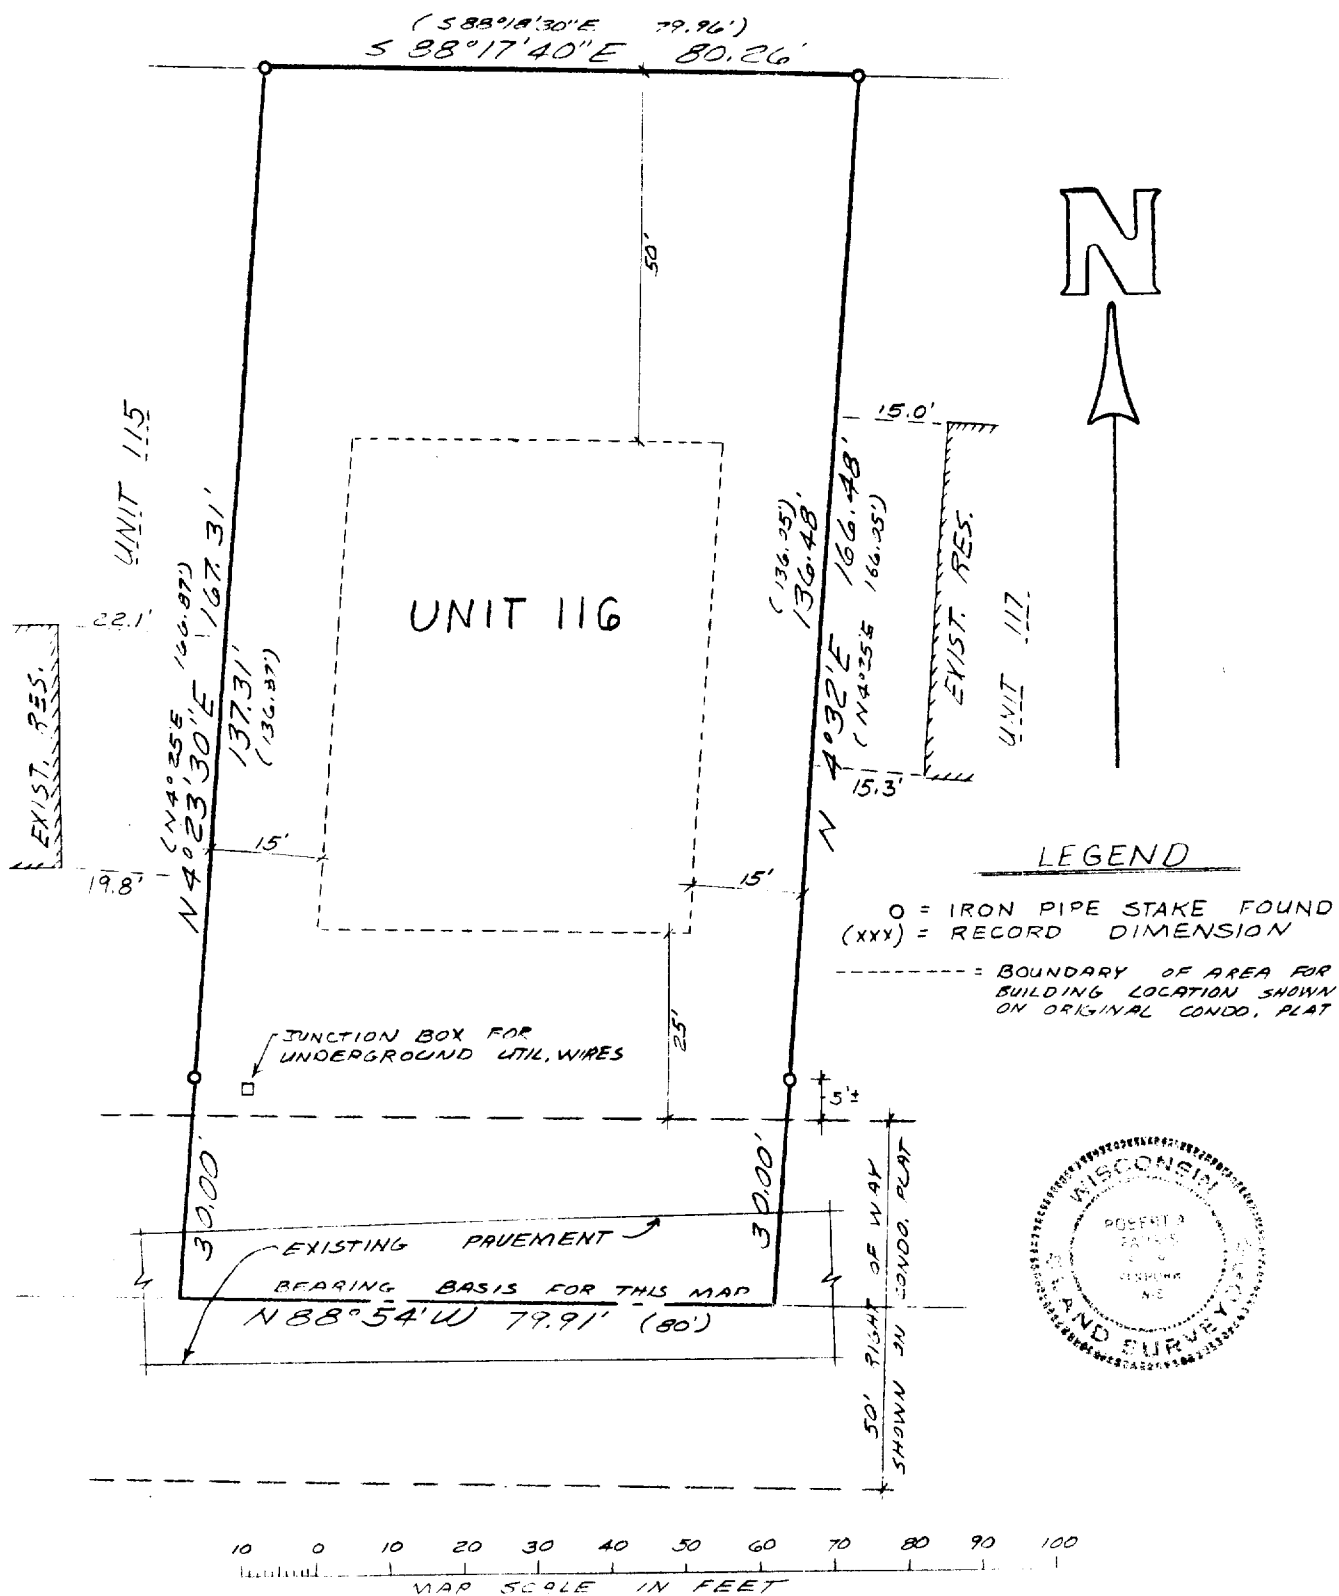

WORK ORDERED BY KEEFE REAL ESTATE INC.

I hereby certify that I have surveyed the above described property and that the above map is a true representation thereof and shows the size and location of the property, its exterior boundaries, the location of all visible structures and dimensions of all principal buildings thereon, boundary fences, apparent easements, roadways and visible encroachments, if any.
This survey is made for the use of the present owners of the property, and also those who purchase, mortgage, or guarantee the title thereto within one (1) year from the date hereof.

Robert A. Farris
12/23/86

PROJECT 1772