


WILSON COUNTY
SURVEYING & MAPS
LAKE GENEVA, WISCONSIN


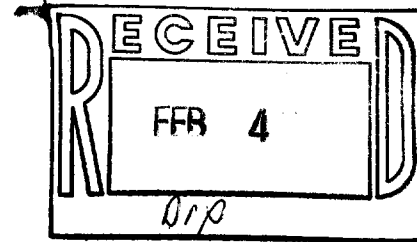


PLAN OF SURVEY OF

LOTS 1, 2 AND 3 OF CERTIFIED SURVEY MAP NO. 501,
LOCATED IN THE SOUTHWEST 1/4 OF SECTION 11,
T. 1 N., R. 16 E., VILLAGE OF FONTANA-ON-GENEVA
LAKE, WALWORTH COUNTY, WISCONSIN.

ORDERED BY: KEEFE REAL ESTATE
704 MAIN STREET
LAKE GENEVA, WISCONSIN 53147

NOTE: THERE ARE NO VISIBLE ENCROACHMENTS.

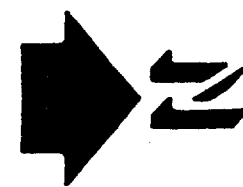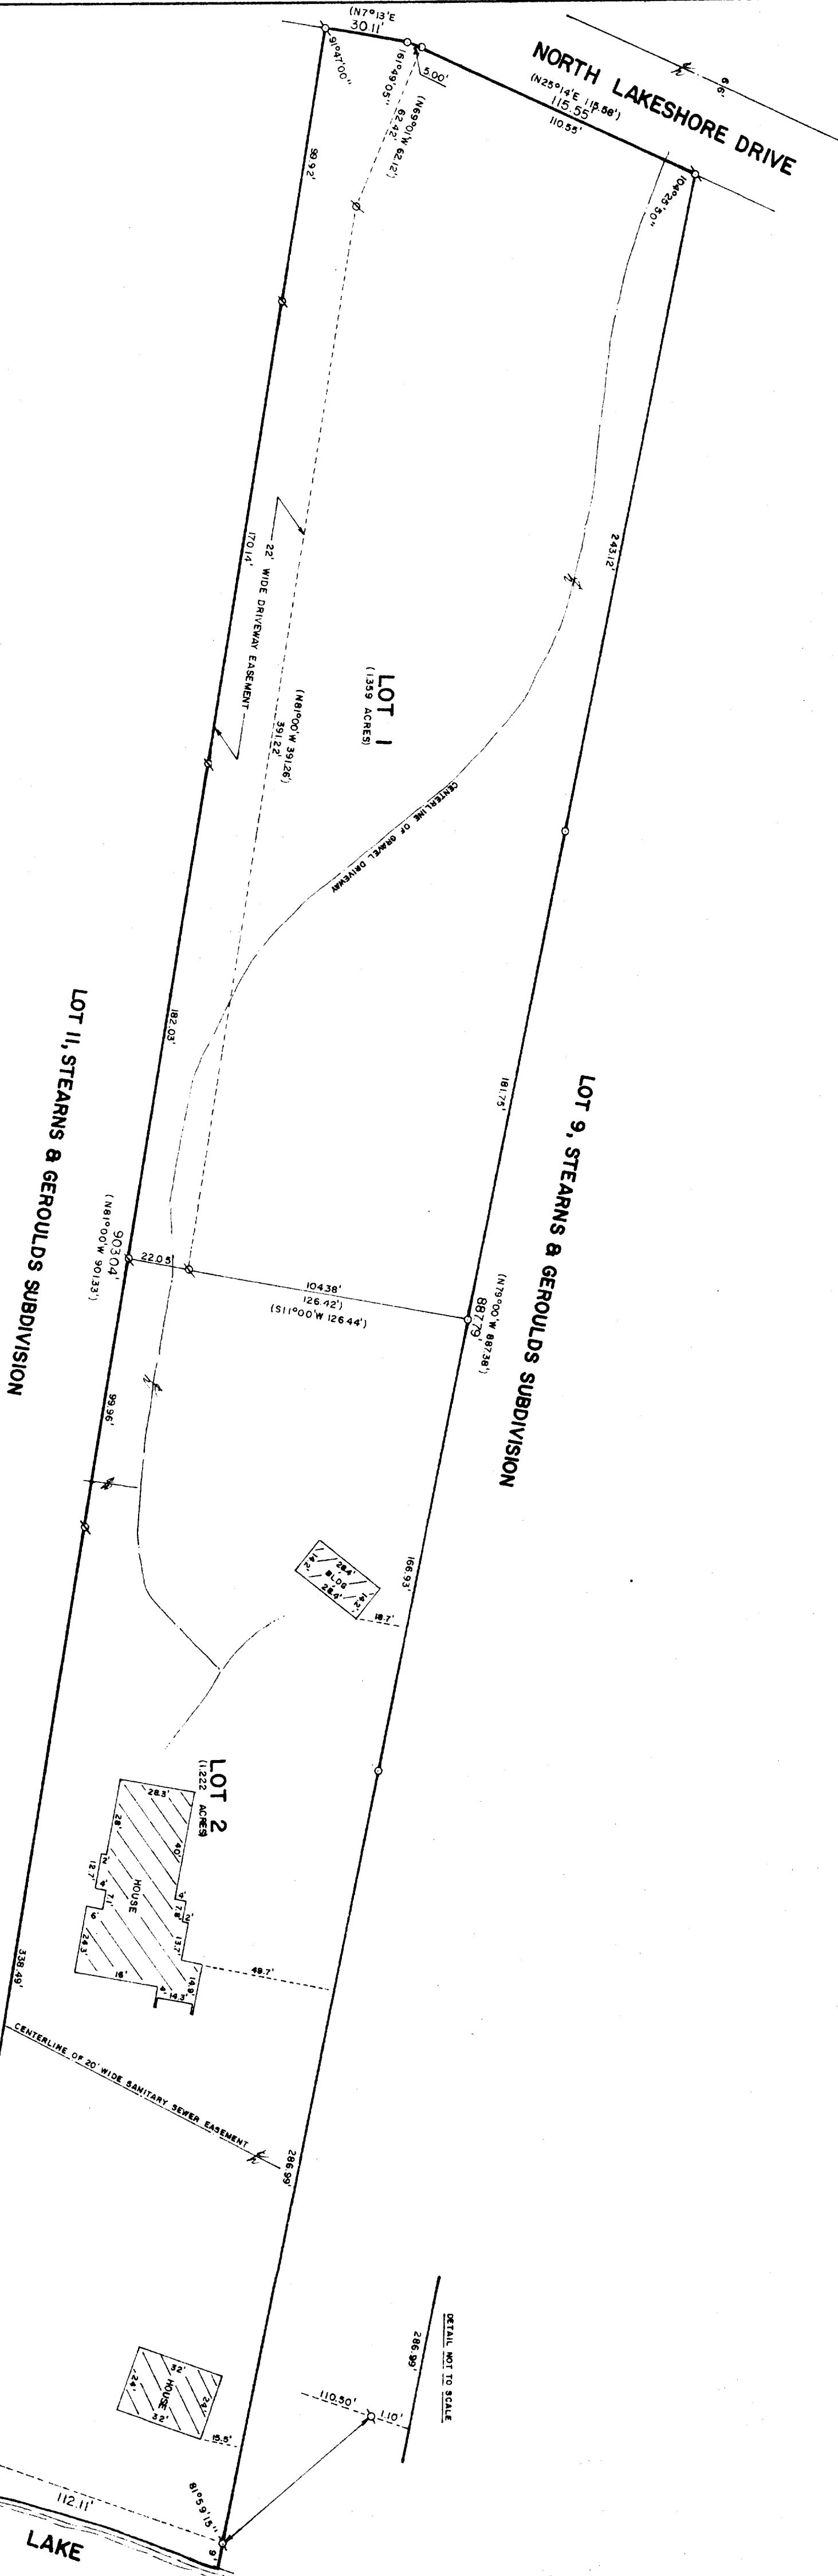

SCALE: 1"=40'

Ø - IRON PIPE FOUND
Ø - IRON ROD FOUND
○ - IRON ROD PLACED
() - RECORDED AS

I, ROBERT M. BAERENWALD, DO HEREBY CERTIFY THAT I
HAVE SURVEYED THE PROPERTY HEREON DESCRIBED ACCORDING
TO THE OFFICIAL RECORDS AND THAT THE PLAT HEREON IS A
CORRECT REPRESENTATION OF THE PROPERTY LINES TO THE
BEST OF MY KNOWLEDGE AND BELIEF.

Robert M. Baerenwald
ROBERT M. BAERENWALD
WISCONSIN REGISTERED LAND SURVEYOR, S-10008

Nov. 13, 1986
DATE: NOV 13 1986 JOB NO. 10008