
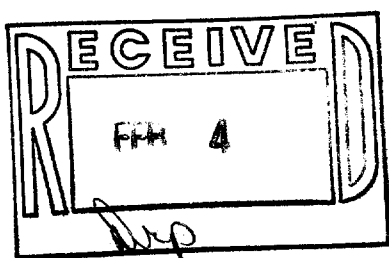



WALWORTH COUNTY
SURVEYING & MAPPING
LAKE GENEVA, WISCONSIN

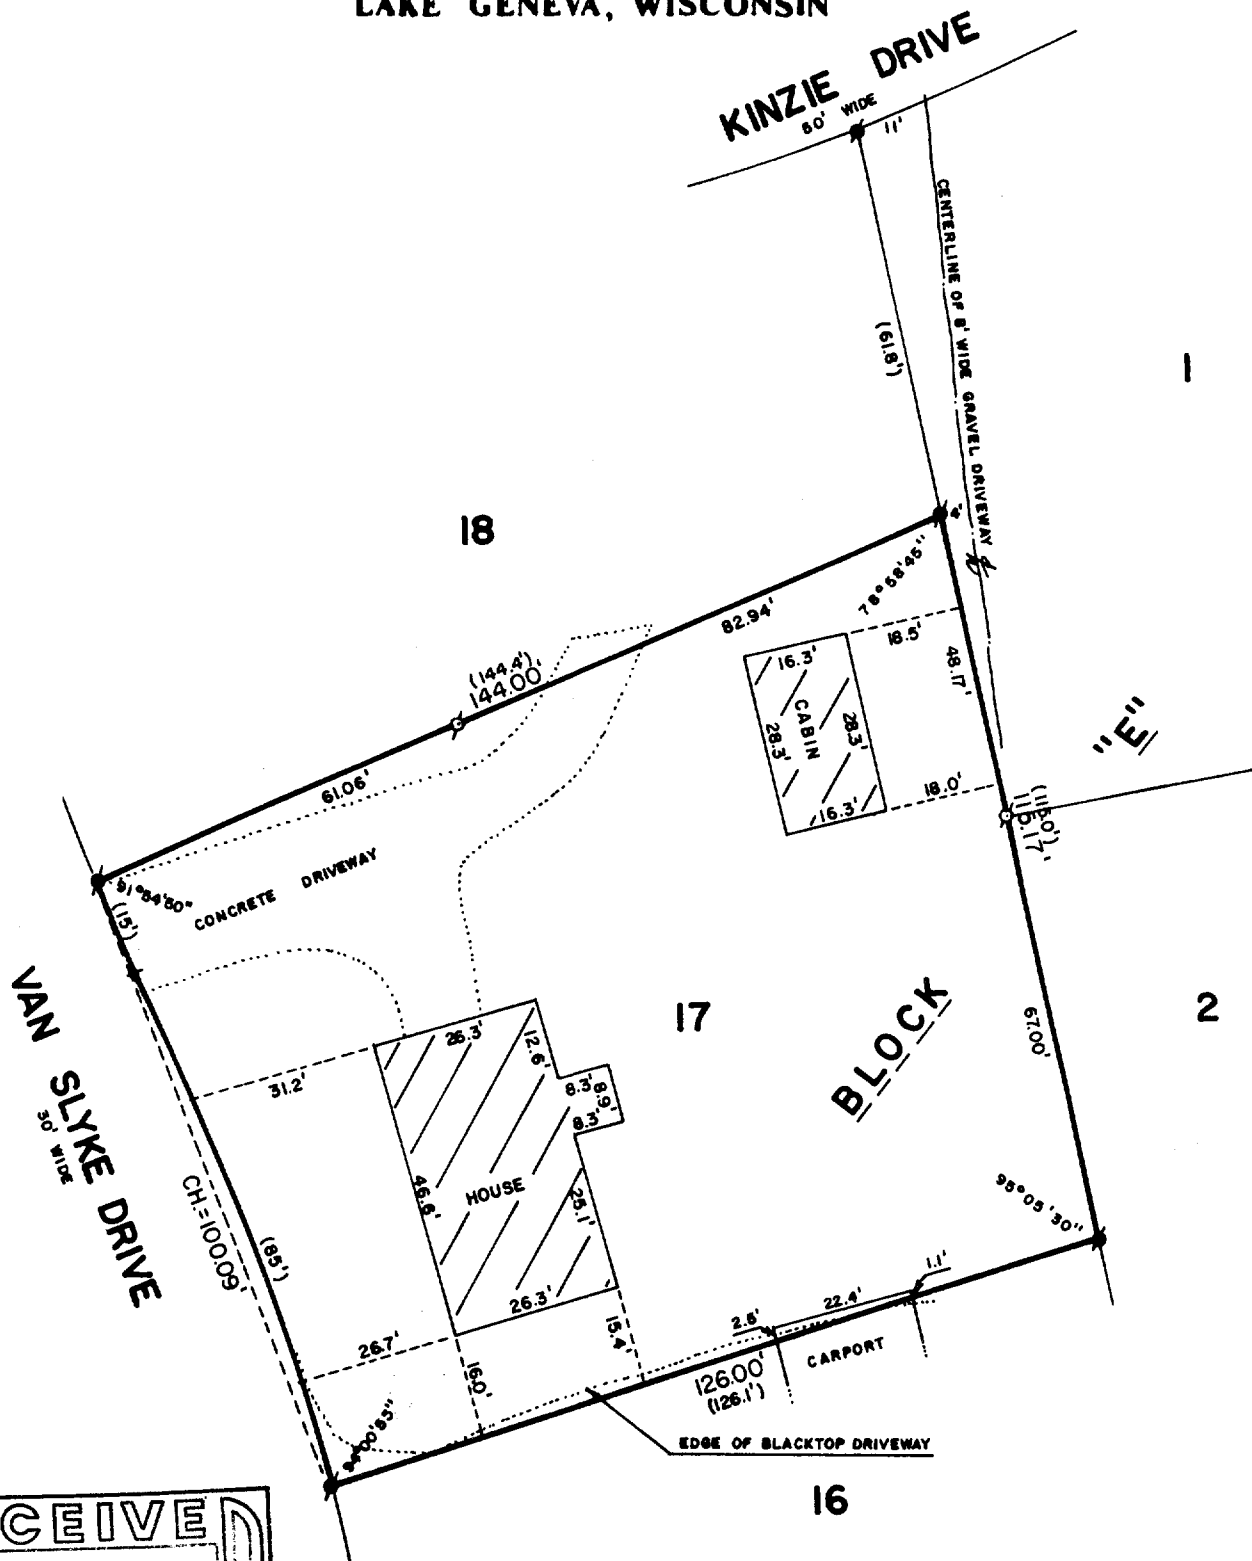

PLAT OF SURVEY OF

LOT 17, BLOCK "E" OF COUNTRY CLUB ESTATES
UNIT 3, LOCATED IN THE VILLAGE OF FONTANA-
ON-GENEVA LAKE, WALWORTH COUNTY, WISCONSIN.

ORDERED BY: LAKELAND REALTY
BOX 323
FONTANA, WISCONSIN 53125

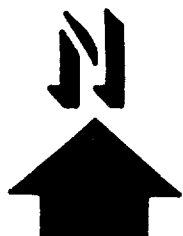

SCALE: 1"=30'

- ⊕ - IRON PIPE FOUND
- ⚓ - CONCRETE MONUMENT FOUND
- () - RECORDED AS

I, ROBERT M. BAERENWALD, DO HEREBY CERTIFY THAT I
HAVE SURVEYED THE PROPERTY HEREON DESCRIBED ACCORDING
TO THE OFFICIAL RECORDS AND THAT THE PLAT HEREON IS A
CORRECT REPRESENTATION OF THE PROPERTY LINES TO THE
BEST OF MY KNOWLEDGE AND RELIEF.

Robert M. Baerenwald
ROBERT M. BAERENWALD
WISCONSIN REGISTERED LAND SURVEYOR, S-1508

Oct. 29, 1986
DATE JOB NO. 0802

NOTE: THIS IS NOT A CERTIFIED COPY UNLESS SEALED.

Sc. 03-94

5-686