


GEORGE T. DUNHAM
SURVEYING & SUBDIVIDING
DELAVER, WISCONSIN



Scale - 1" = 10'
○ = Iron Pipe
● = Concrete Monument

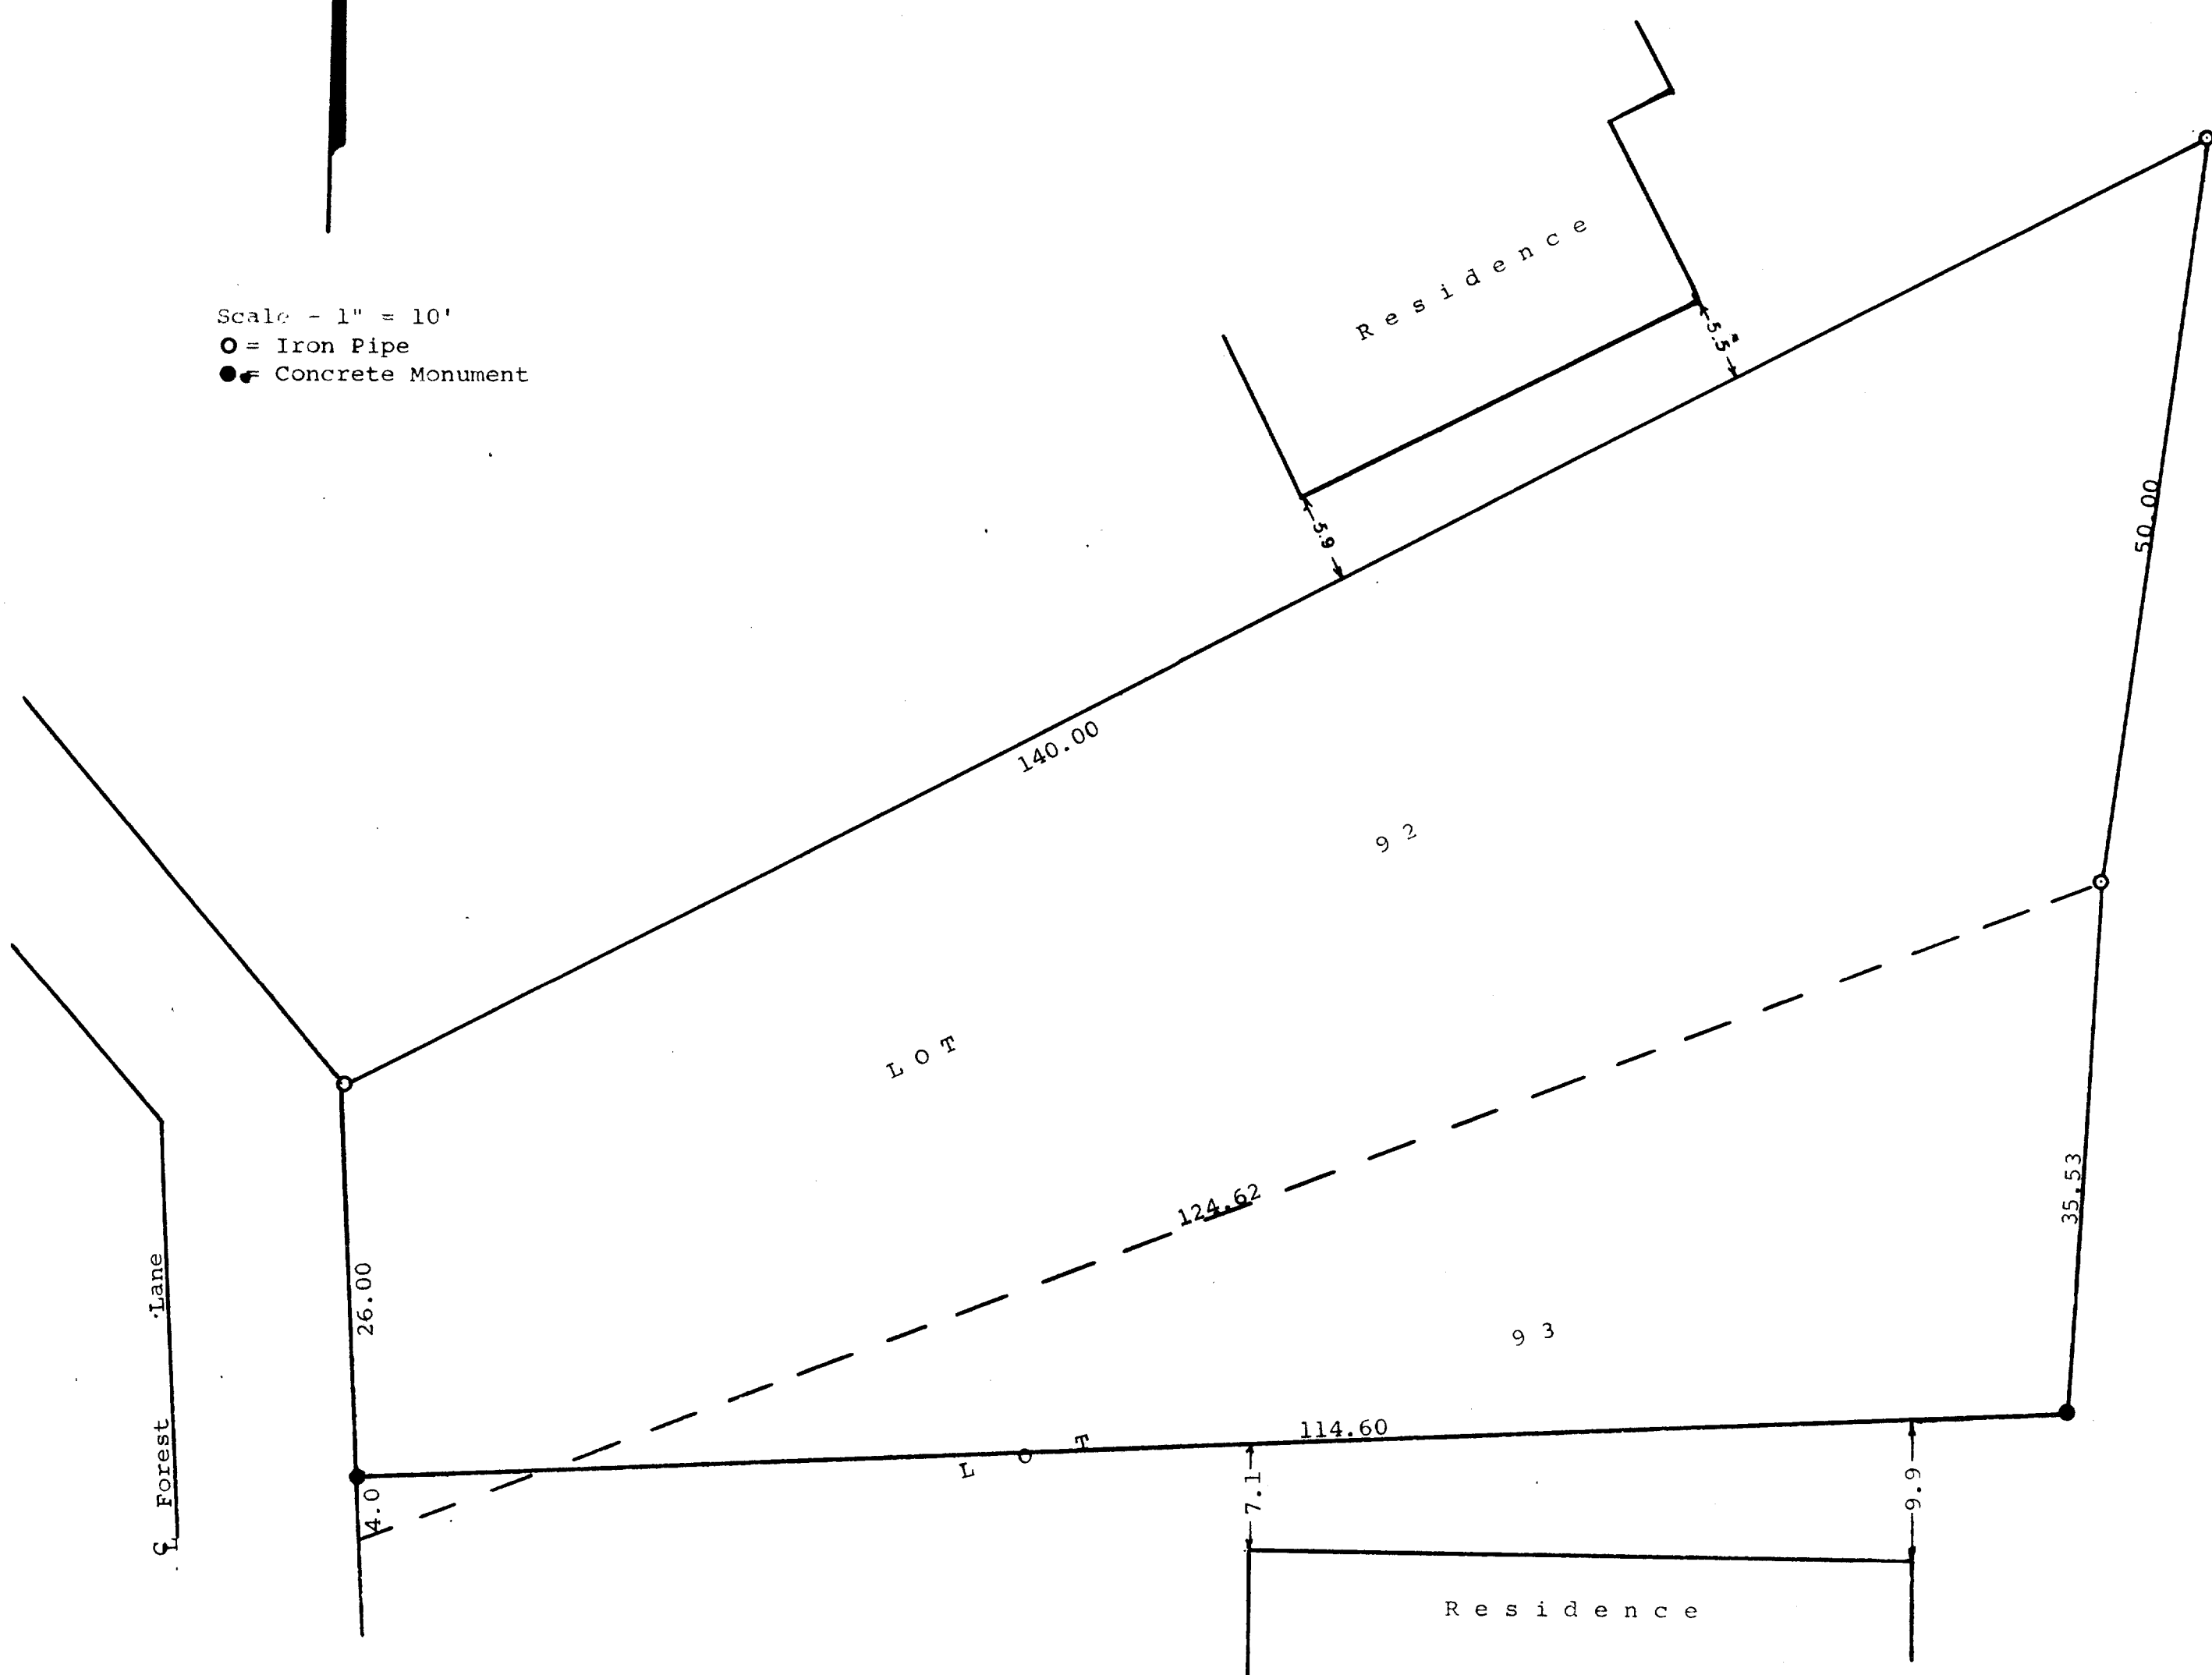

Plat of survey of parts of Lots 92 & 93 of Buena Vista
in the Village of Fontana, Walworth County, Wisconsin
October 1, 1964

George T. Dunham
George T. Dunham, Surveyor

SBU-66