


LOT 99

LOT 98

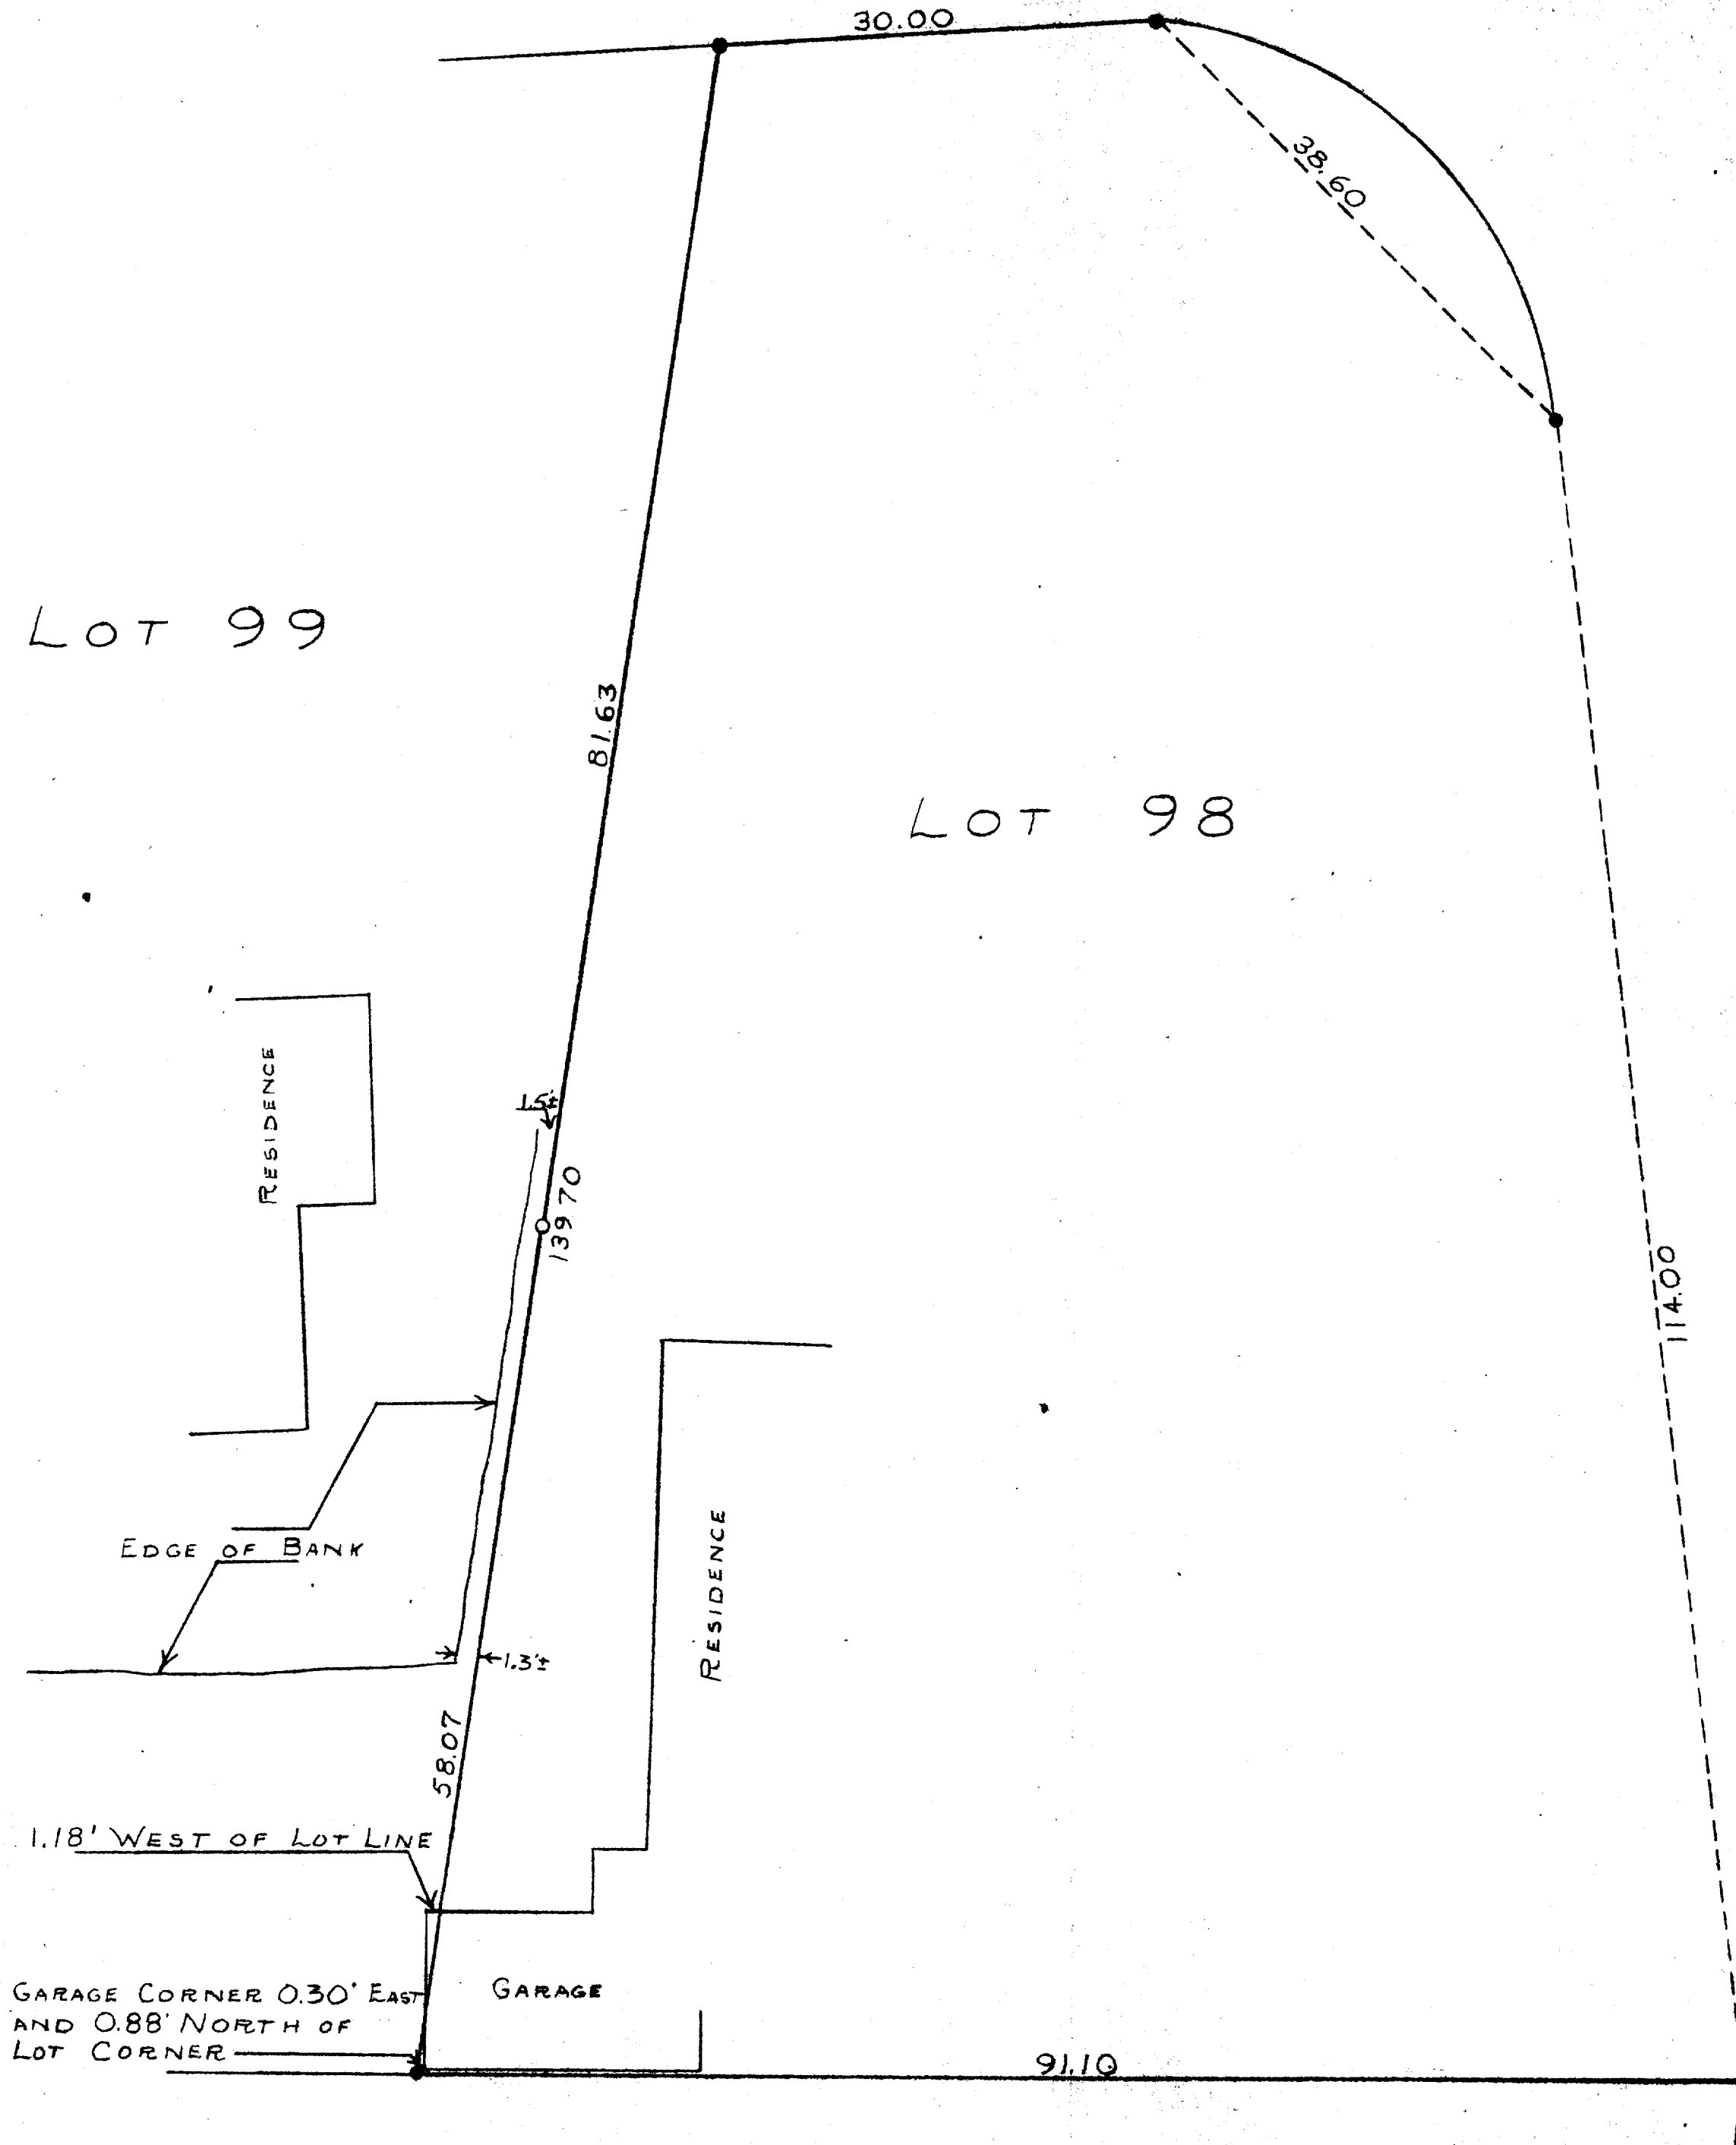

SCALE - 1" = 10'
• = CONC. MONU.
○ = IRON PIPE

PLAT OF SURVEY OF LOT 98 LOCATED IN COUNTRY CLUB
ESTATES UNIT NO. 2 OF FONTANA ON GENEVA LAKE,
WALWORTH COUNTY, WISCONSIN
OCTOBER, 1952

George T. Blumhagen
SURVEYOR

5-7

SC02-92