


GEORGE T. DUNHAM
SURVEYING & SUBDIVIDING
DELAVER, WISCONSIN

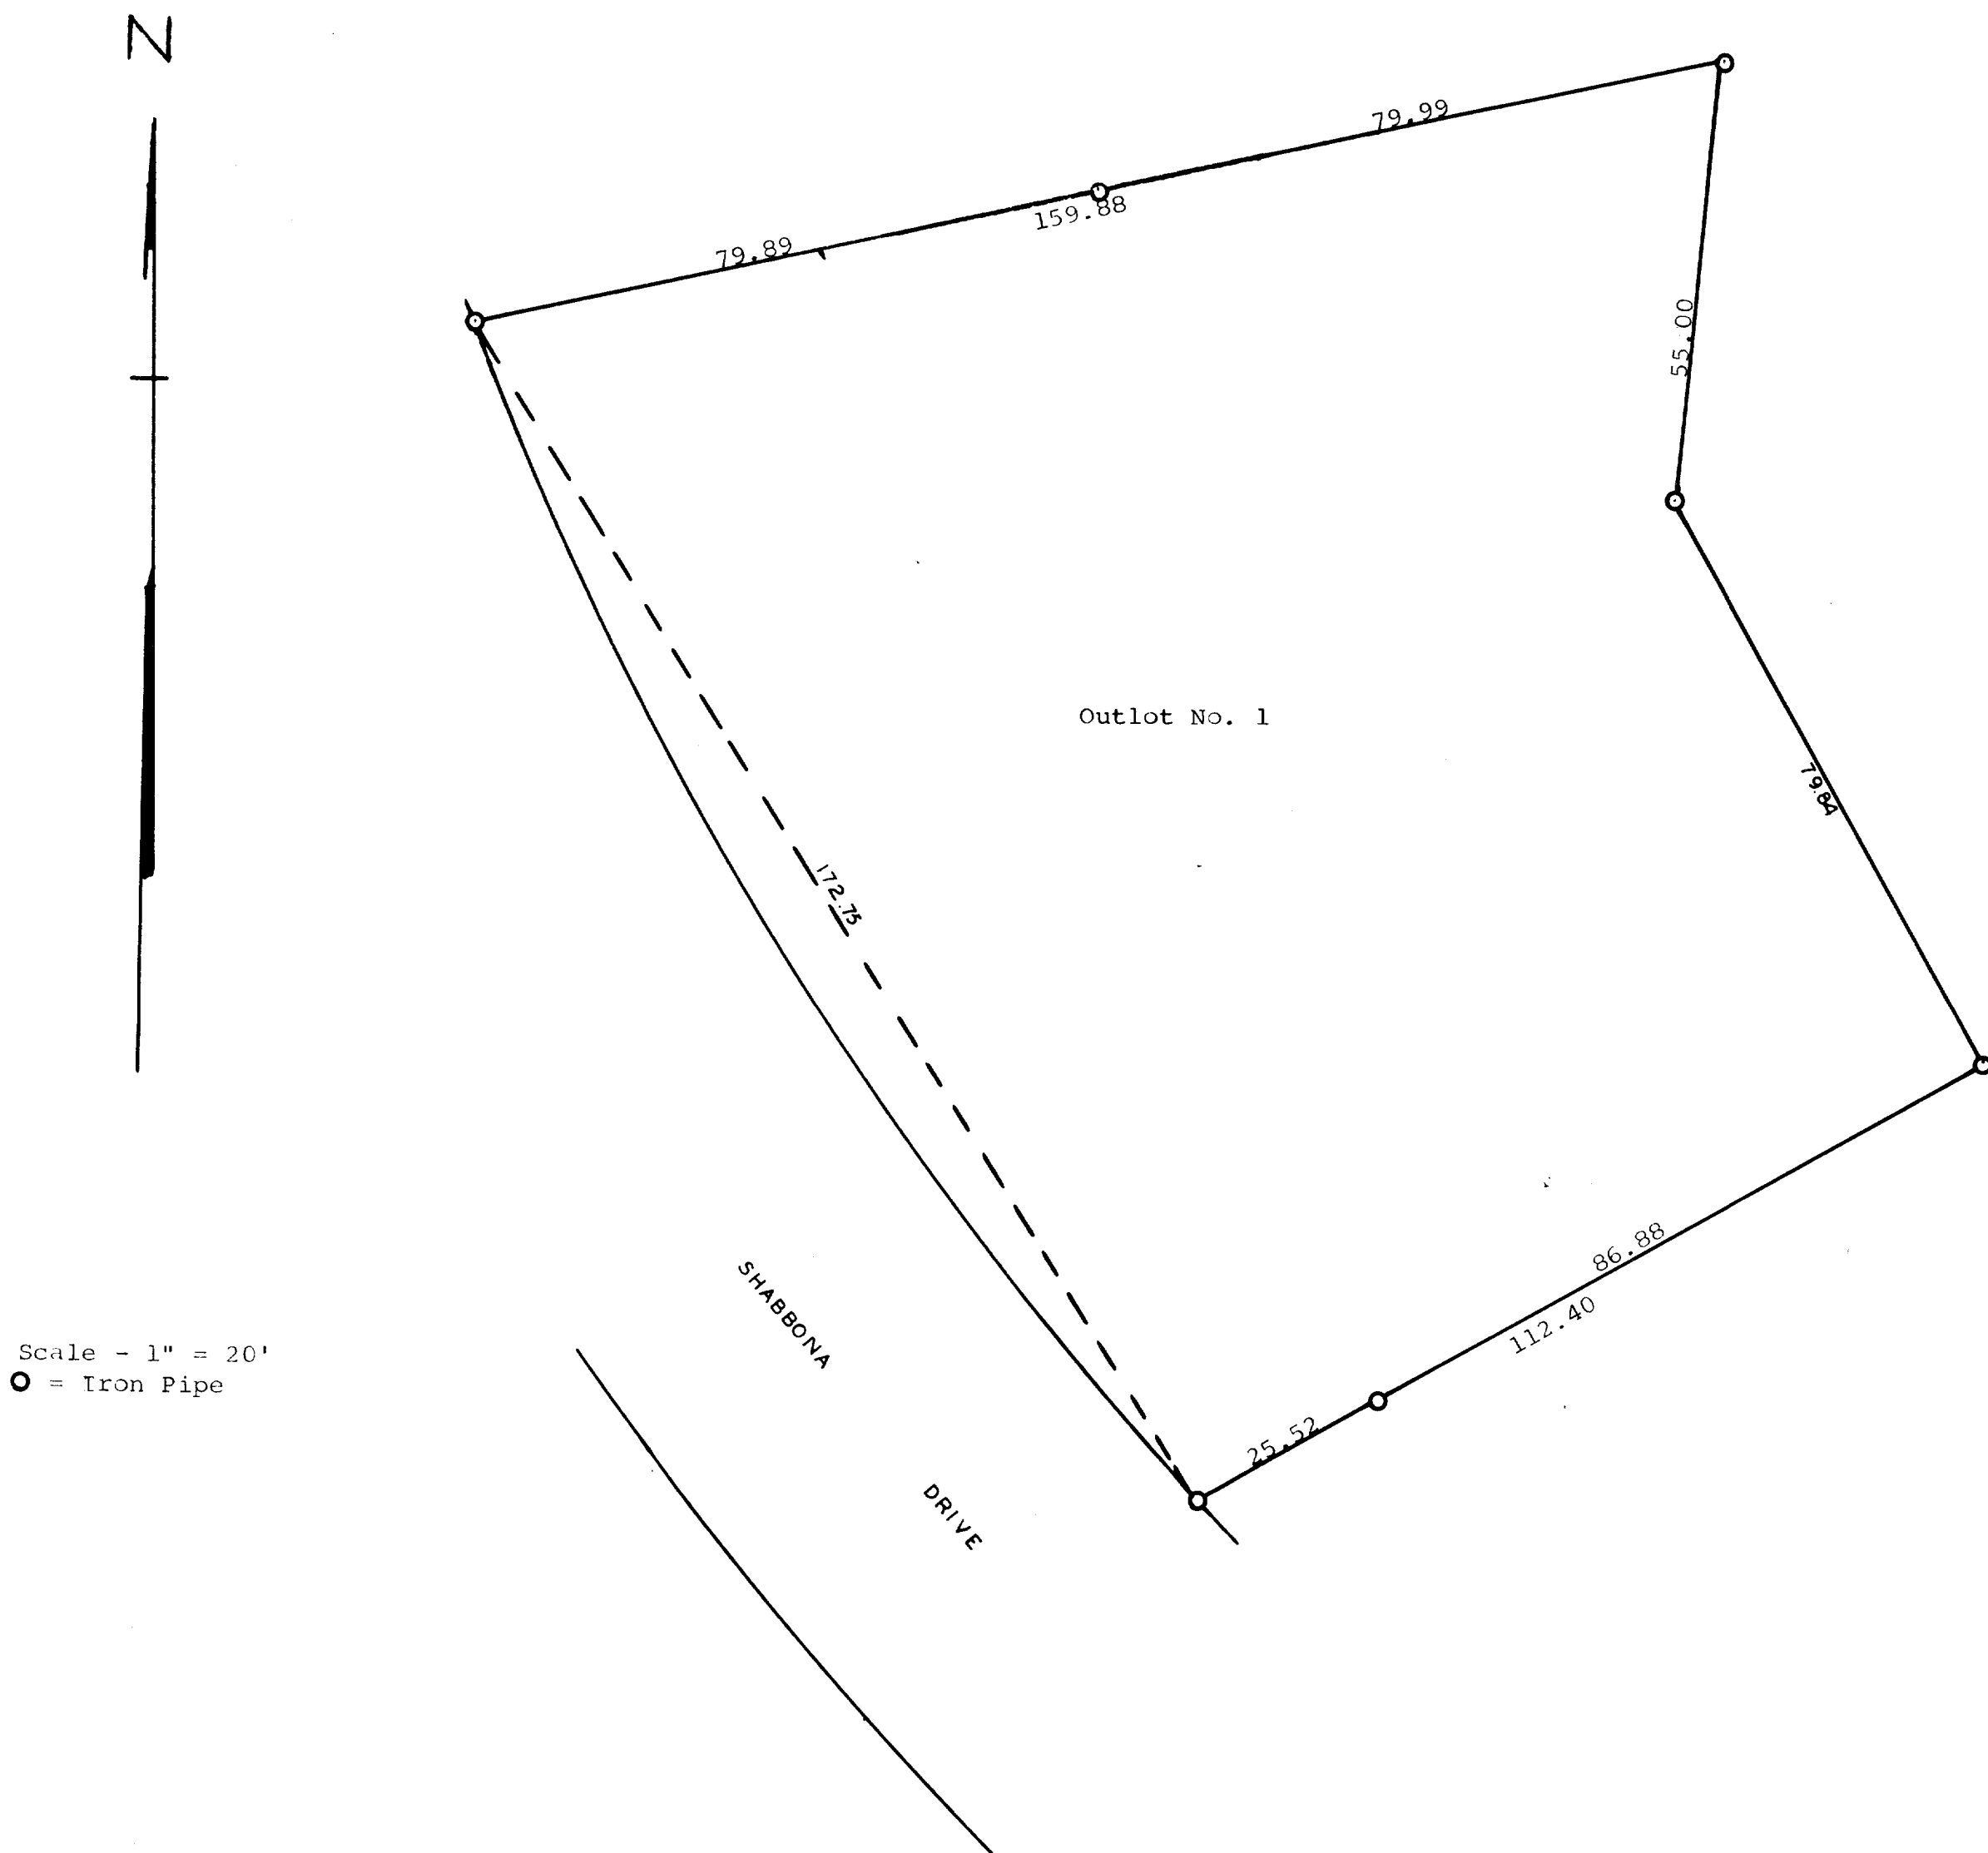

Scale - 1" = 20'
● = Iron Pipe

Plat of survey of Outlot No. 1 in Country Club
Estates Unit No. 3, Village of Fontana on Geneva
Lake,, Walworth County, Wisconsin.
November 4, 1964

George T. Dunham
George T. Dunham, Surveyor

5-70

SC03-51