

FARRIS, HANSEN & ASSOCIATES, INC.

7 RIDGEWAY COURT, P.O. BOX 487, ELKHORN, WISCONSIN

TEL. 414-723-2098

LOCATION: UNIT 9 OF ABBEY SPRINGS CONDOMINIUM 1
VILLAGE OF FONTANA-ON-GENEVA LAKE
WALWORTH COUNTY, WISCONSIN

WORK ORDERED BY: VISNER CONSTRUCTION


MAP LEGEND

- = IRON PIPE STAKE FOUND
- = IRON PIPE STAKE SET
- = IRON ROD STAKE FOUND
- = IRON ROD STAKE SET
- = CONCRETE MONUMENT FOUND
- (XXXXX) = RECORD DIMENSION

MAP SCALE IN FEET



N

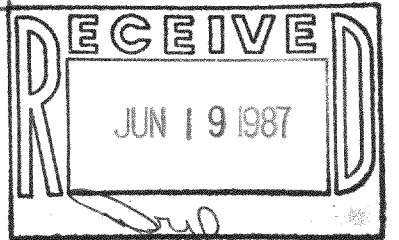

BOUNDARY OF AREA
FOR BUILDING LOCATION
SHOWN ON ORIG. CONDO. PLAT

UNIT 8

UNIT 9

UNIT 10

GOLF COURSE



I hereby certify that the above described property has been surveyed under my direction and that the above map is a true representation thereof and shows the size and location of the property, its exterior boundaries, the location of all visible structures and dimensions of all principal buildings thereon, to the best of my knowledge and belief.

DATED : MAY 20, 1987

Robert A. Farris

PROJ. NO. 2801