



ABELL
SURVEYING & MAPPING
 DELAVAN, WISCONSIN 53115
 414-728-6737

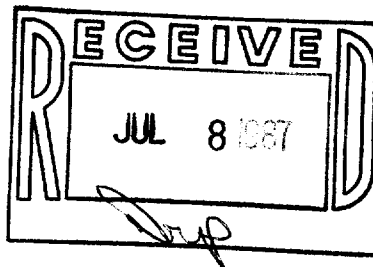

ORDERED BY: LAKELAND REALTY
 P.O. BOX 323
 FONTANA, WI 53125

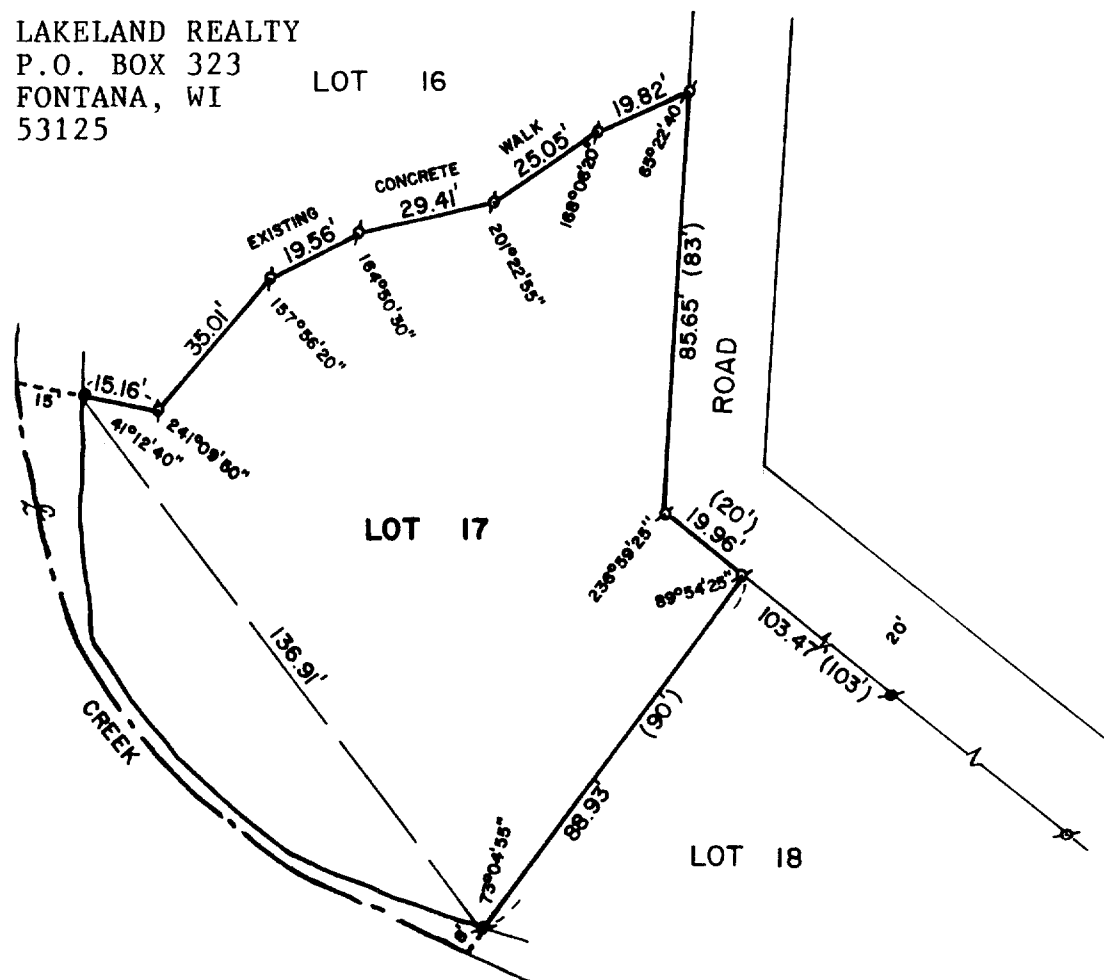

PLAT OF SURVEY OF

LOT 17 IN THE GARDENS, ACCORDING TO THE
 REVISED PLAT THEREOF RECORDED ON JUNE 9,
 1927 IN VOLUME 8 OF PLATS AT PAGE 121,
 AS DOCUMENT NO. 263978 AND BEING A PART
 OF SECTION 11, IN TOWN 1 NORTH, RANGE 16
 EAST, IN THE VILLAGE OF FONTANA-ON-GENEVA
 LAKE, WALWORTH COUNTY, WISCONSIN.



SCALE - 1"=40'

LEGEND

- ✕ - IRON PIPE FOUND
- - CONCRETE MONUMENT FOUND
- () - RECORDED AS
- - IRON ROD FOUND

I, DAVID F. ABELL, DO HEREBY CERTIFY
 THAT I HAVE SURVEYED THE PROPERTY
 HEREON DESCRIBED ACCORDING TO THE
 OFFICIAL RECORDS AND THAT THE PLAT
 HEREON IS A CORRECT REPRESENTATION
 OF THE PROPERTY LINES TO THE BEST OF
 MY KNOWLEDGE AND BELIEF.

David F. Abell

DAVID F. ABELL
 WISCONSIN REGISTERED LAND SURVEYOR, S-1596

May 28, 1987
 DATE JOB NUMBER - 87065
 NOTE: THIS IS NOT A CERTIFIED COPY UNLESS SEALED.