



WALWORTH COUNTY
SURVEYING & MAPPING
LAKE GENEVA, WISCONSIN

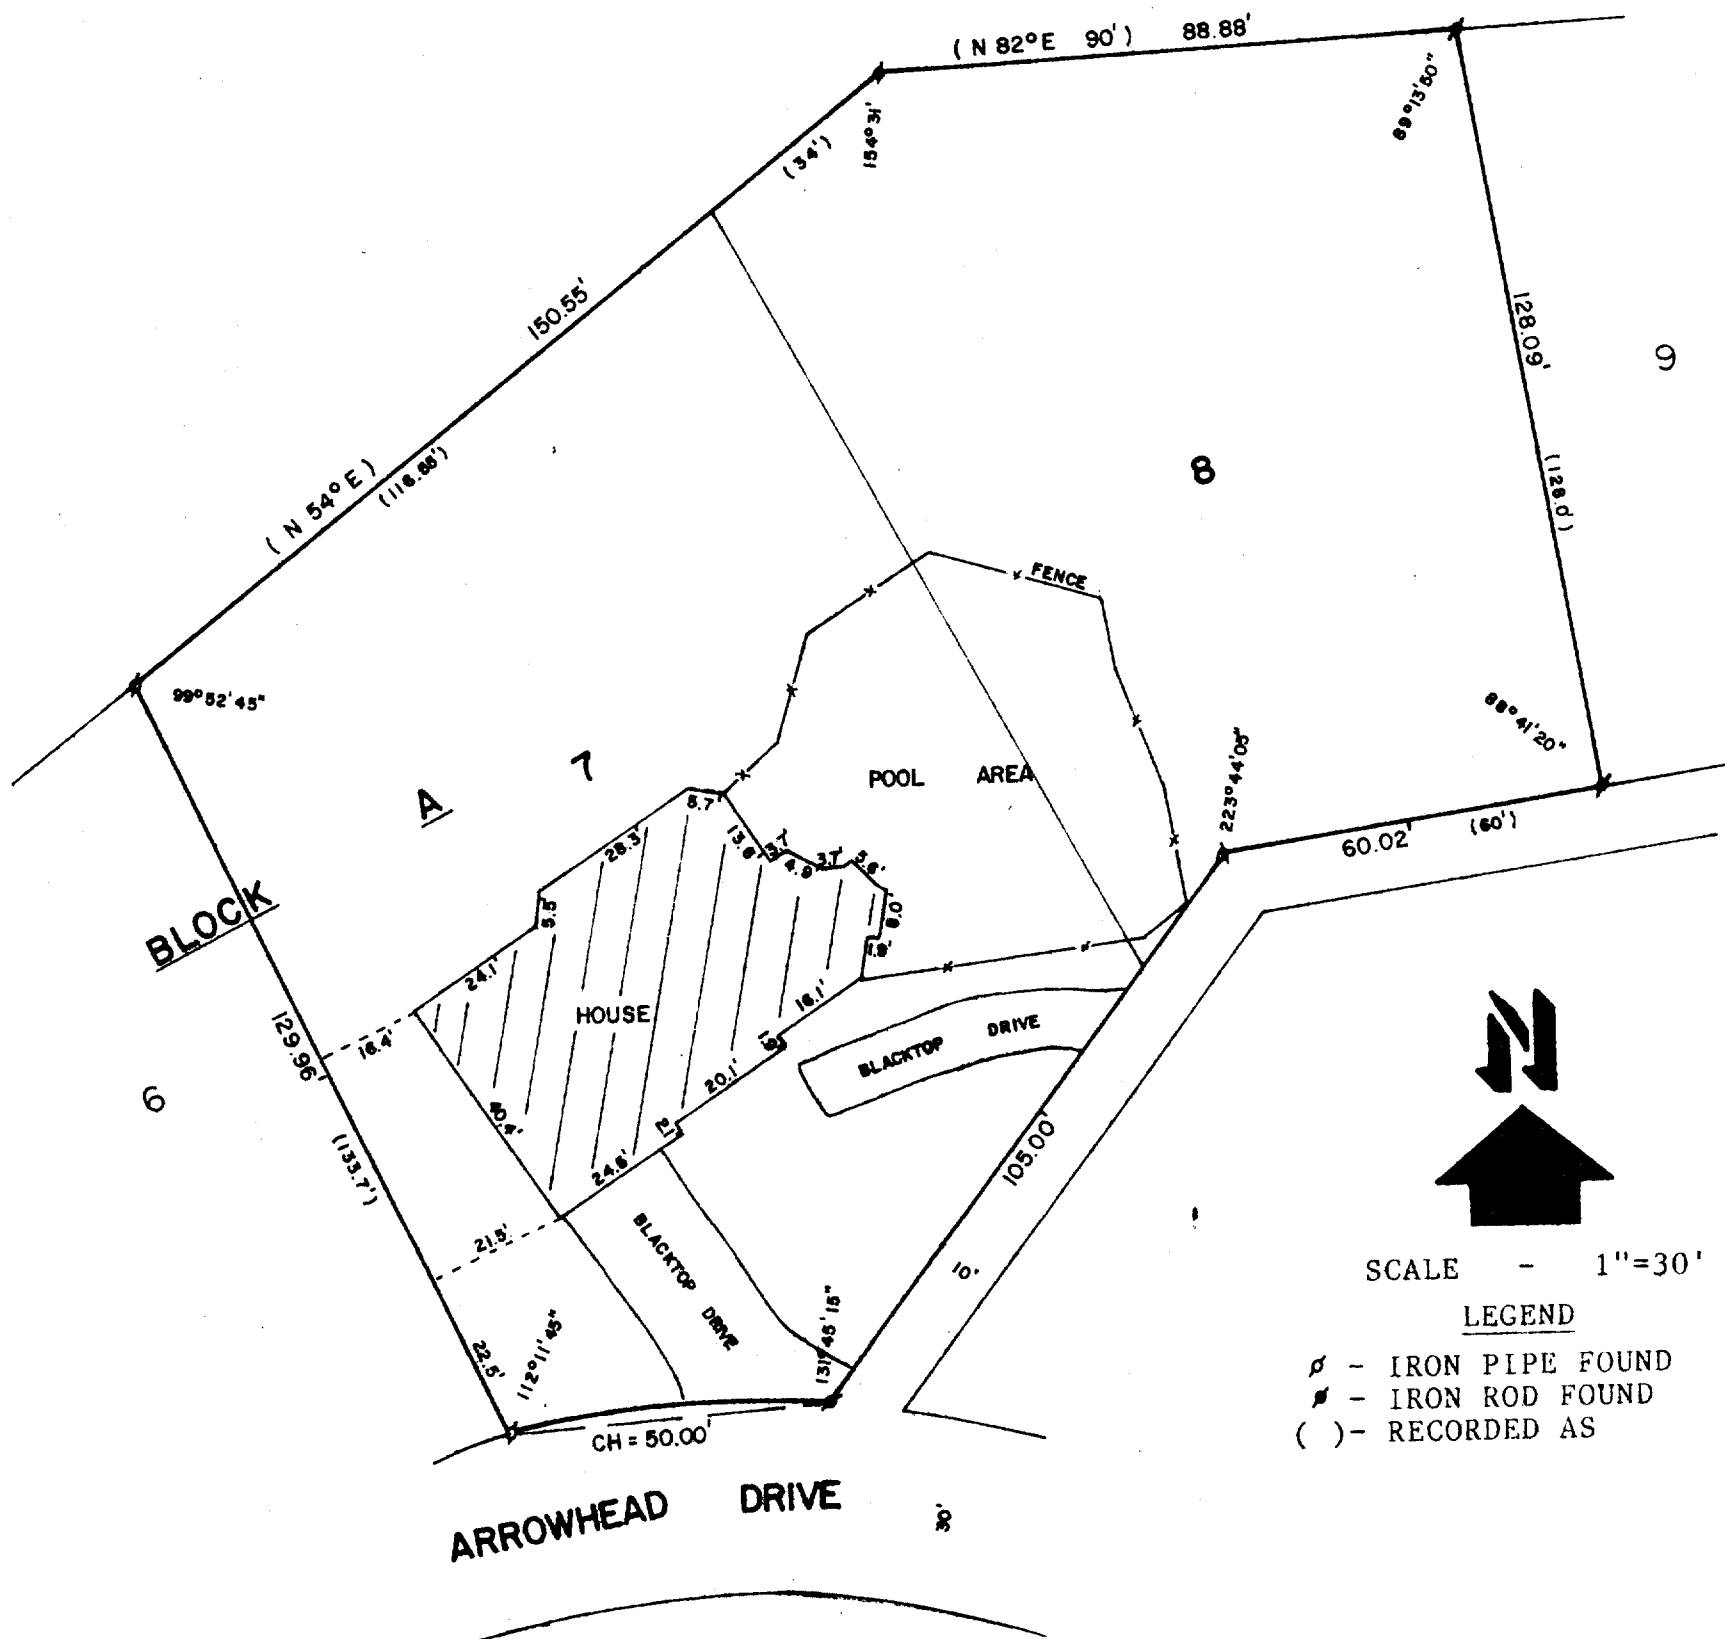

PLAT OF SURVEY OF

LOTS 7 AND 8, BLOCK A, UNIT 3, COUNTRY CLUB ESTATES,
VILLAGE OF FONTANA-ON-GENEVA LAKE, WALWORTH COUNTY,
WISCONSIN.

ORDERED BY: COLDWELL BANKER
838 MAIN ST.
LAKE GENEVA, WI. 53147

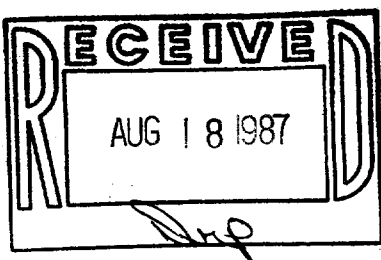

I, ROBERT M. BAERENWALD, DO HEREBY CERTIFY THAT
I HAVE SURVEYED THE PROPERTY HEREON DESCRIBED
ACCORDING TO THE OFFICIAL RECORDS AND THAT THE
PLAT HEREON IS A CORRECT REPRESENTATION OF THE
PROPERTY LINES TO THE BEST OF MY KNOWLEDGE AND
BELIEF.

Robert M. Baerenwald
ROBERT M. BAERENWALD
WISCONSIN REGISTERED LAND SURVEYOR, S-1508

DATE *July 15, 1987* JOB NUMBER - 1150
NOTE: THIS IS NOT A CERTIFIED COPY UNLESS SEALED.

5-737