


GENEVA LAKE



WALWORTH COUNTY
SURVEYING & MAPPING
LAKE GENEVA, WISCONSIN

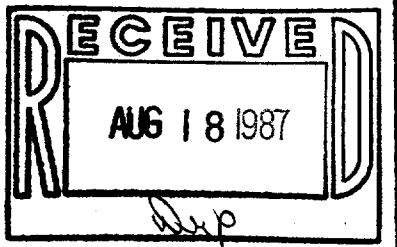

PLAT OF SURVEY OF

LAND LOCATED IN THE NORTH 1/2 OF FRACTIONAL SECTION 13, TOWN 1 NORTH, RANGE 16 EAST, VILLAGE OF PORTANA-ON-GENEVA LAKE, WALWORTH COUNTY, WISCONSIN, DESCRIBED AS FOLLOWS: COMMENCE AT THE EAST 1/4 CORNER OF SAID SECTION, THENCE N88°41' W 1434.73 FEET, RECORDED AS 1435 FEET TO THE POINT OF BEGINNING; THENCE NORTH 1°00' EAST 697.32 FEET TO A POINT ON A MEANDER LINE, WHICH POINT IS LOCATED SOUTH 1°00' WEST 35.74 FEET MORE OR LESS FROM THE SHORE OF GENEVA LAKE; THENCE SOUTH 80°23'30" WEST ALONG SAID MEANDER LINE 152.35 FEET TO A POINT, WHICH POINT IS LOCATED SOUTH 1°00' WEST 40.28 FEET MORE OR LESS FROM THE SHORE OF GENEVA LAKE; THENCE SOUTH 1°00' WEST 270.41 FEET; THENCE SOUTH 89°00' EAST 19.39 FEET, THENCE SOUTH 1°00' WEST 770.25 FEET TO THE EAST-WEST 1/4 SECTION LINE; THENCE SOUTH 89°00' EAST ALONG THE SAID EAST-WEST 1/4 SECTION LINE, 130.00 FEET TO THE POINT OF BEGINNING, ALSO ALL THE LAND BETWEEN THE ABOVE DESCRIBED MEANDER LINE AND THE SHORE OF GENEVA LAKE.

ORDERED BY: ASSURED REALTY
P. O. BOX 367
WILLIAMS BAY, WISCONSIN 53191

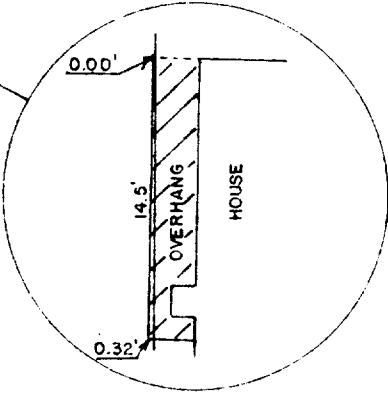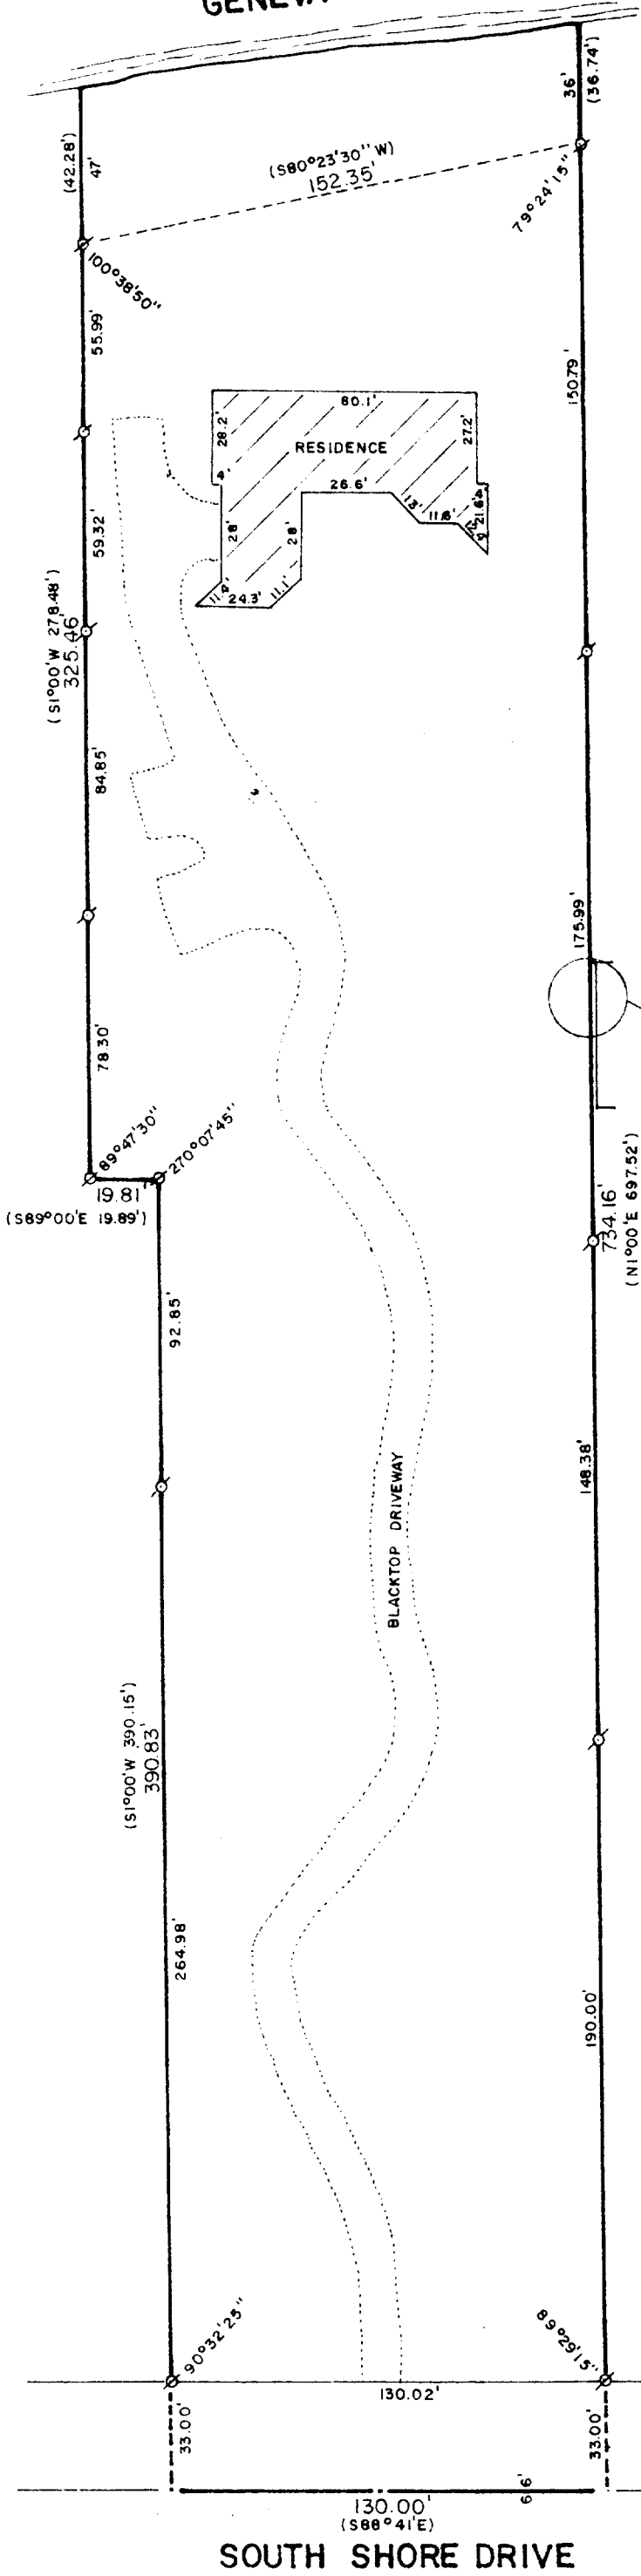

SCALE: 1"=50'

Ø - IRON PIPE FOUND
∅ - IRON ROD FOUND
() - RECORDED AS

I, ROBERT M. BAUMWALD, DO HEREBY CERTIFY THAT I HAVE SURVEYED THE ABOVE PROPERTY ACCORDING TO THE FIELD NOTES AND THAT THE PLAT HEREON IS A CORRECT REPRESENTATION OF THE PROPERTY LINES TO THE BEST OF MY KNOWLEDGE AND BELIEF.

Robert M. Baumwald
ROBERT M. BAUMWALD
WISCONSIN REGISTERED LAND SURVEYOR, 1-3508

DATE *July 30, 1987*
TOP 1/4 SECTION 13, T1N, R16E

EAST 1/4 CORNER
SECTION 13, T1N, R16E

SOUTH SHORE DRIVE