


DUNHAM SURVEYING, S.C.
SURVEYING & SUBDIVIDING
DELAVER, WISCONSIN 53115

N

Northeast corner of Unit 161

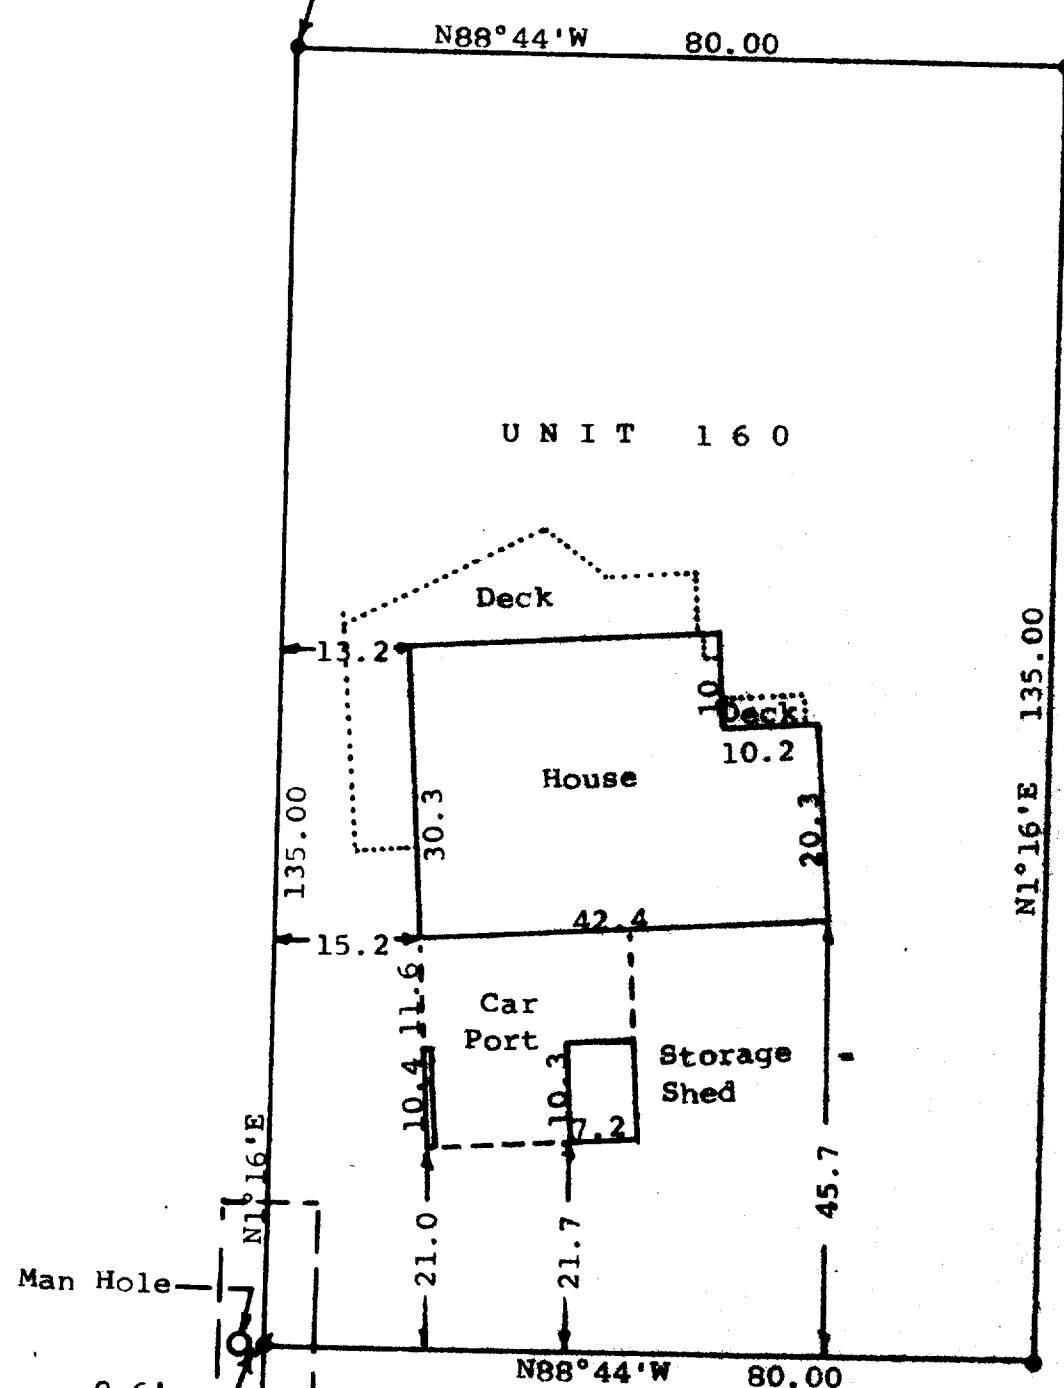

Scale - 1" = 20'
 o = 1" Iron Pipe Found
 p = 1/2" X 24" Iron Pipe Set
 Bearings used are those of record.
 Owner: Bernard J. Hickey, Jr.


STATE OF WISCONSIN)
COUNTY OF WALWORTH)

I, George T. Dunham, Surveyor, certify that I have surveyed the property described as follows:


Unit No. 160, Abbey Springs Condominium No. 5, located in the Village of Fontana-on-Geneva Lake, Walworth County, Wisconsin, together with and subject to an easement 10 feet in width for vehicular ingress and egress, the centerline of which is described as follows: Beginning at the southwest corner of Unit 209 of Abbey Springs; thence N1°16'E, 200.57 feet to the end of said easement.

and that the map shown hereon is a correct representation thereof and shows the size and location of the property, its exterior boundaries, the location of all visible structures and dimensions of all principal buildings thereon, boundary fences, apparent easements, roadways and visible encroachments, if any, and that I have surveyed the property hereon described according to the official records, to the best of my knowledge and belief.

July 1, 1987

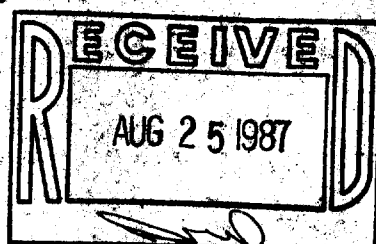

George T. Dunham
George T. Dunham, Surveyor

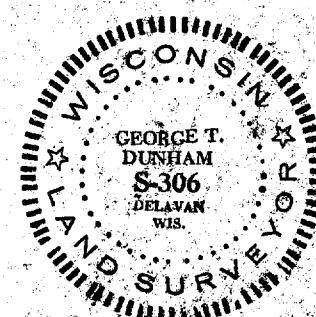

Southwest corner of Unit 209