


\$16,900.00

Plat of Survey


GARY L. MAJEWSKI
REGISTERED LAND SURVEYOR
EAGLE, WISCONSIN

SCALE
1" = 40'

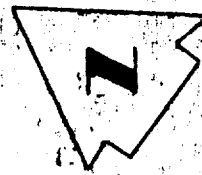

LEGAL DESCRIPTION: Lot 17, The Gardens, Village of Fontana,
Walworth County, Wis.

SG-00017B Tax Key

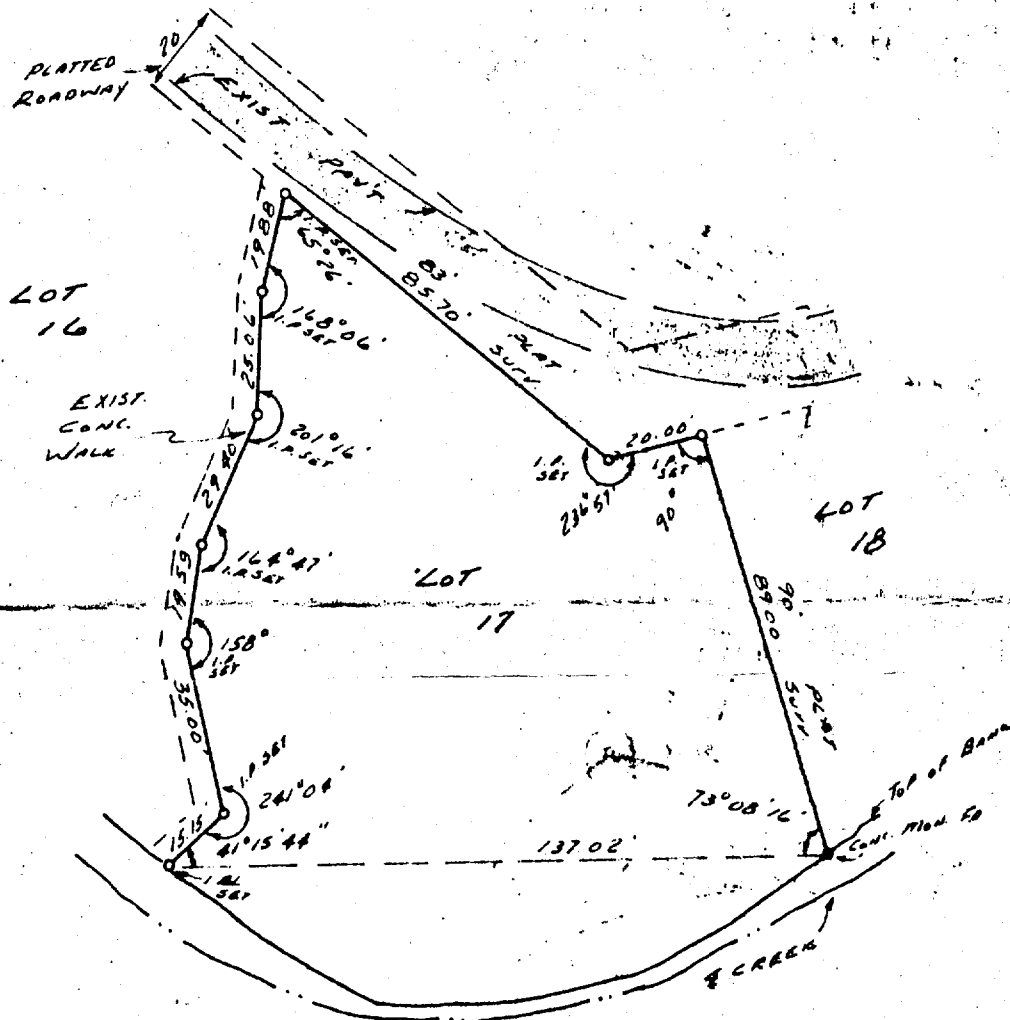

SURVEYOR'S CERTIFICATE

I have surveyed the above described property and the above map is a true representation thereof and shows the size and location of the property, its exterior boundaries, the location and dimensions of all visible structures thereon, fences, apparent easements and roadways and visible encroachments, if any.

This survey is made for the exclusive use of the present owners of the property, and also those who purchase, mortgage, or guarantee the title thereto within one (1) year from date hereof; and as to them I warrant the accuracy of said survey and map.


STATE OF WISCONSIN
COUNTY OF WAUKESHA } SS.

I, GARY L. MAJEWSKI, DO HEREBY CERTIFY THAT I HAVE MADE THIS SURVEY AND THAT THE ABOVE PLAT OF SURVEY IS A CORRECT REPRESENTATION THEREOF.

SG-17B

DATED THIS 6th DAY OF November 1979

PLAT NO. Walworth 2 BOOK Wal. Co. 1 PAGE 19

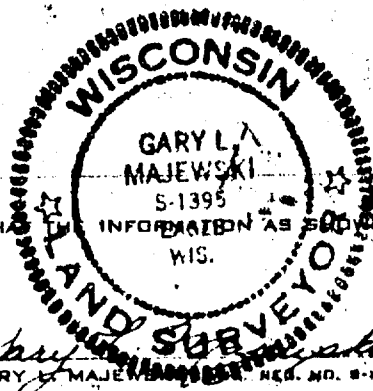

DOROTHY BEGG KAUFMAN