


DUNHAM SURVEYING, S.C.
SURVEYING & SUBDIVIDING
DELAVER, WISCONSIN 53115

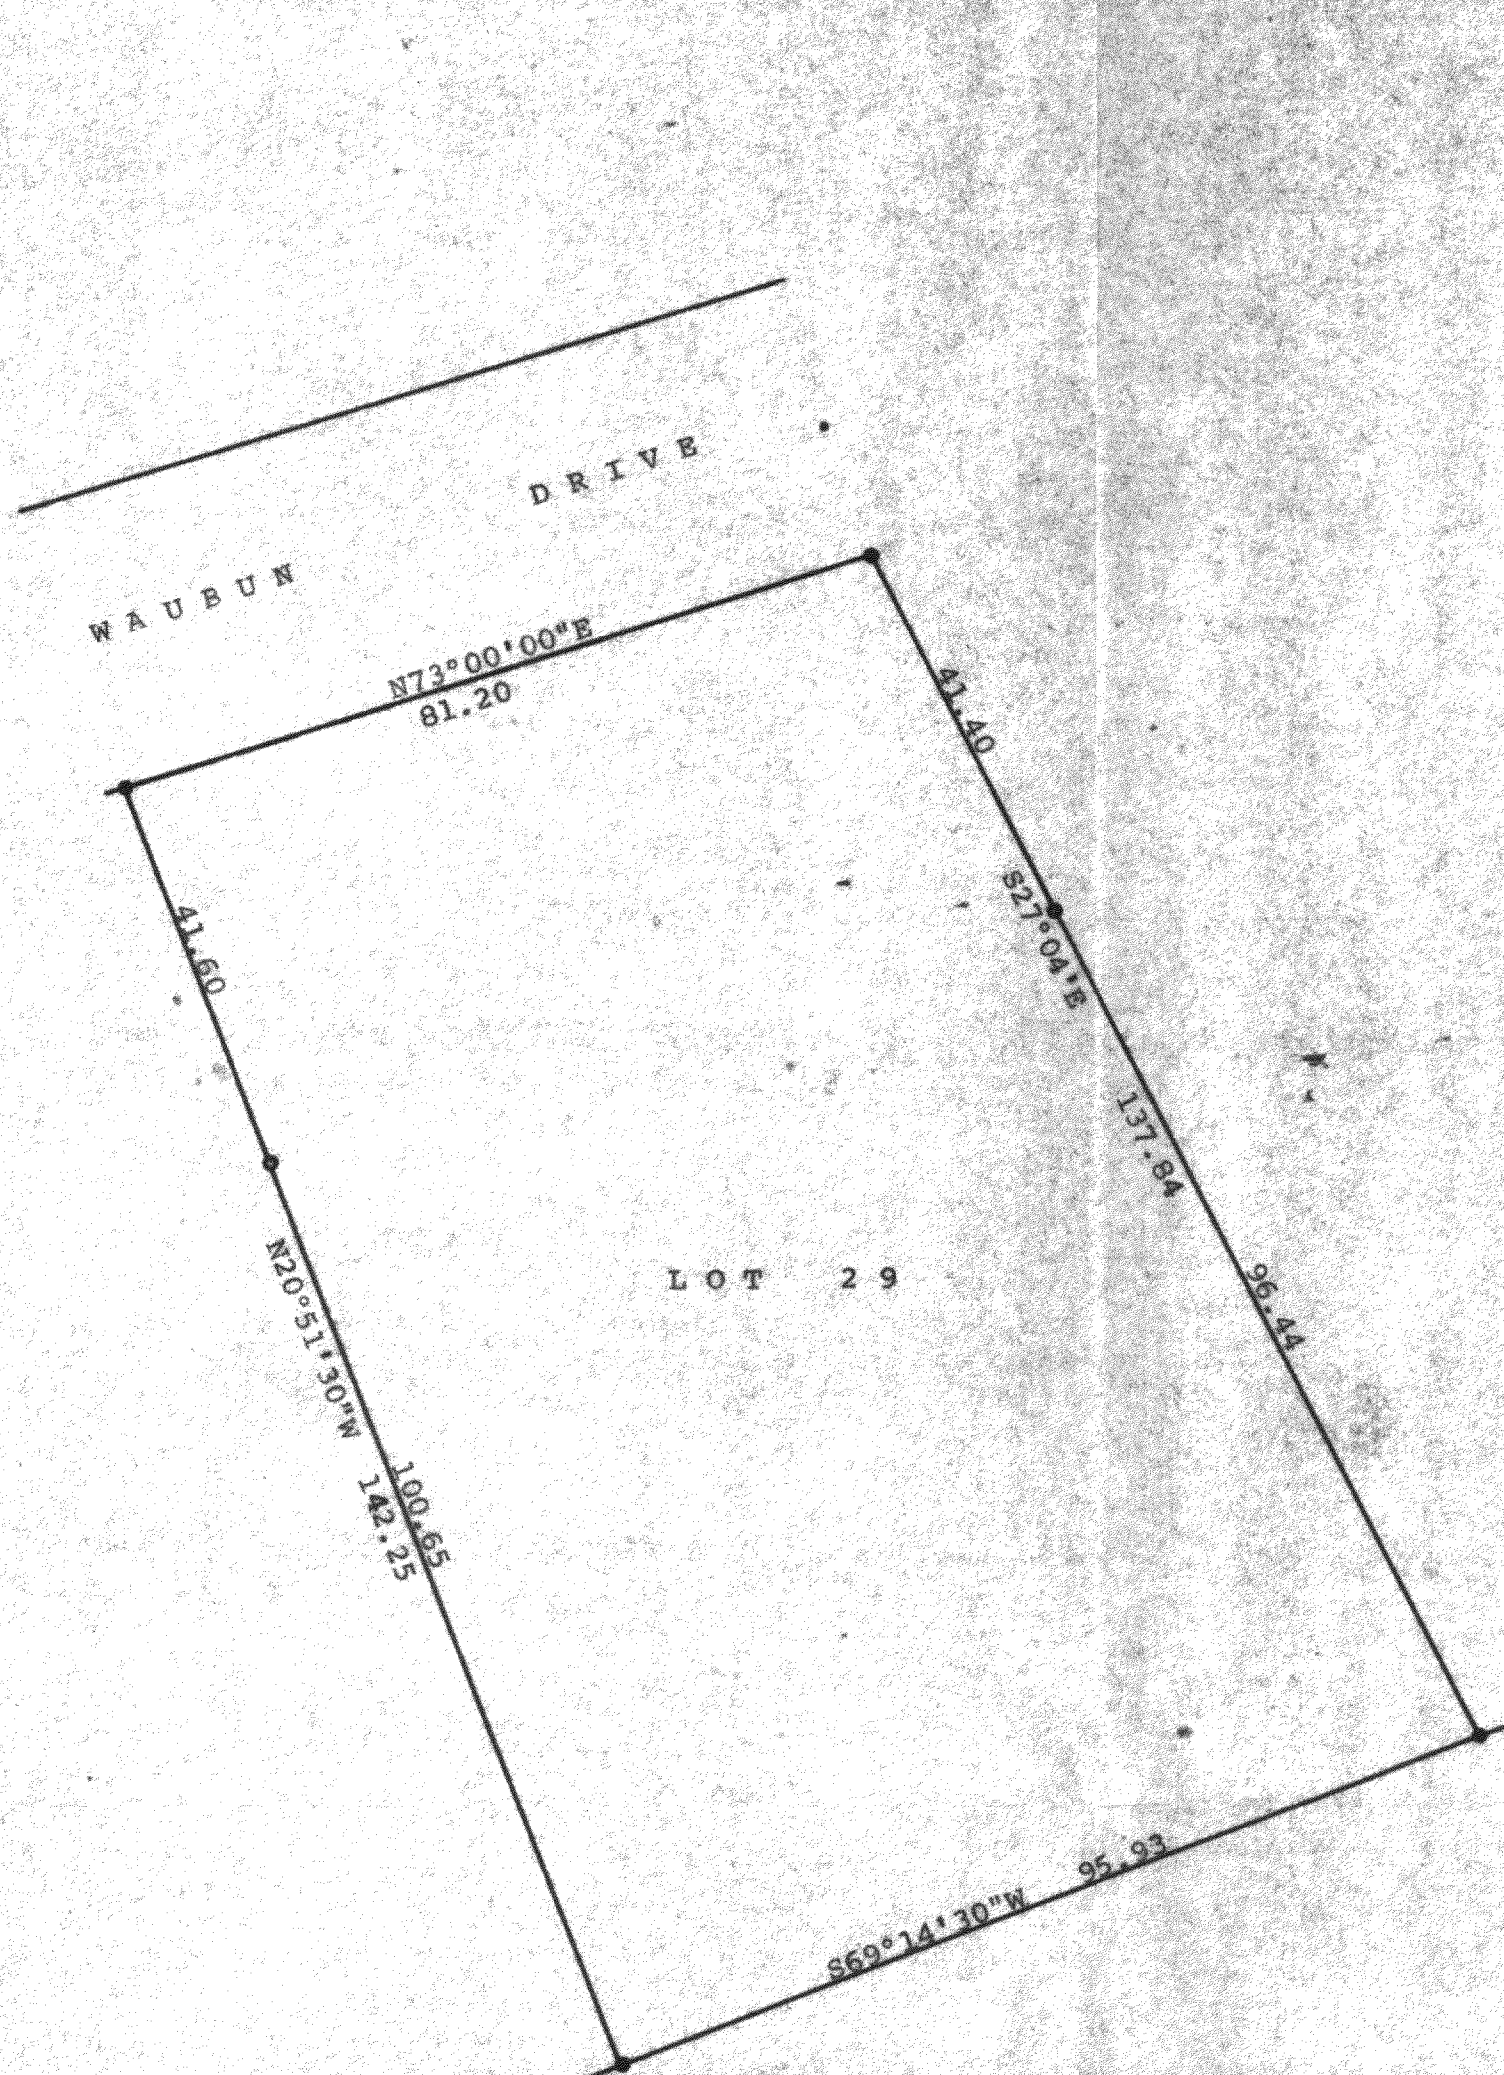


Scale - 1" = 20'
• = Concrete Monument Found
o = 1/2" X 24" Iron Pipe Set
Bearings referenced to the northerly line of
Lot 29 with the assumed bearing of N73°00'00"E
Survey ordered by: Century 21 Geneva Lake
503 Center
Lake Geneva, WI 53147

STATE OF WISCONSIN)
COUNTY OF WALWORTH) SS

I, George T. Dunham, Surveyor, certify that I have surveyed the
property described as follows:

Lot 29 in Country Club Estates Unit No. 2, a subdivision located
in the Village of Pontana-on-Geneva Lake, Walworth County, Wisconsin,
and that the map shown hereon is a correct representation thereof and shows
the size and location of the property, its exterior boundaries, the location
of all visible structures and dimensions of all principal buildings thereon,
boundary fences, apparent easements, roadways and visible encroachments, if
any, and that I have surveyed the property hereon described, according to the
official records, to the best of my knowledge and belief.
October 19, 1987

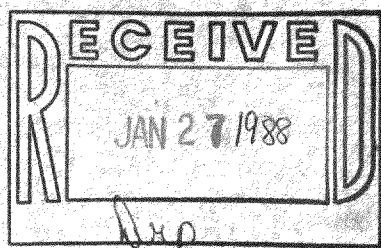

George T. Dunham
George T. Dunham, Surveyor

