


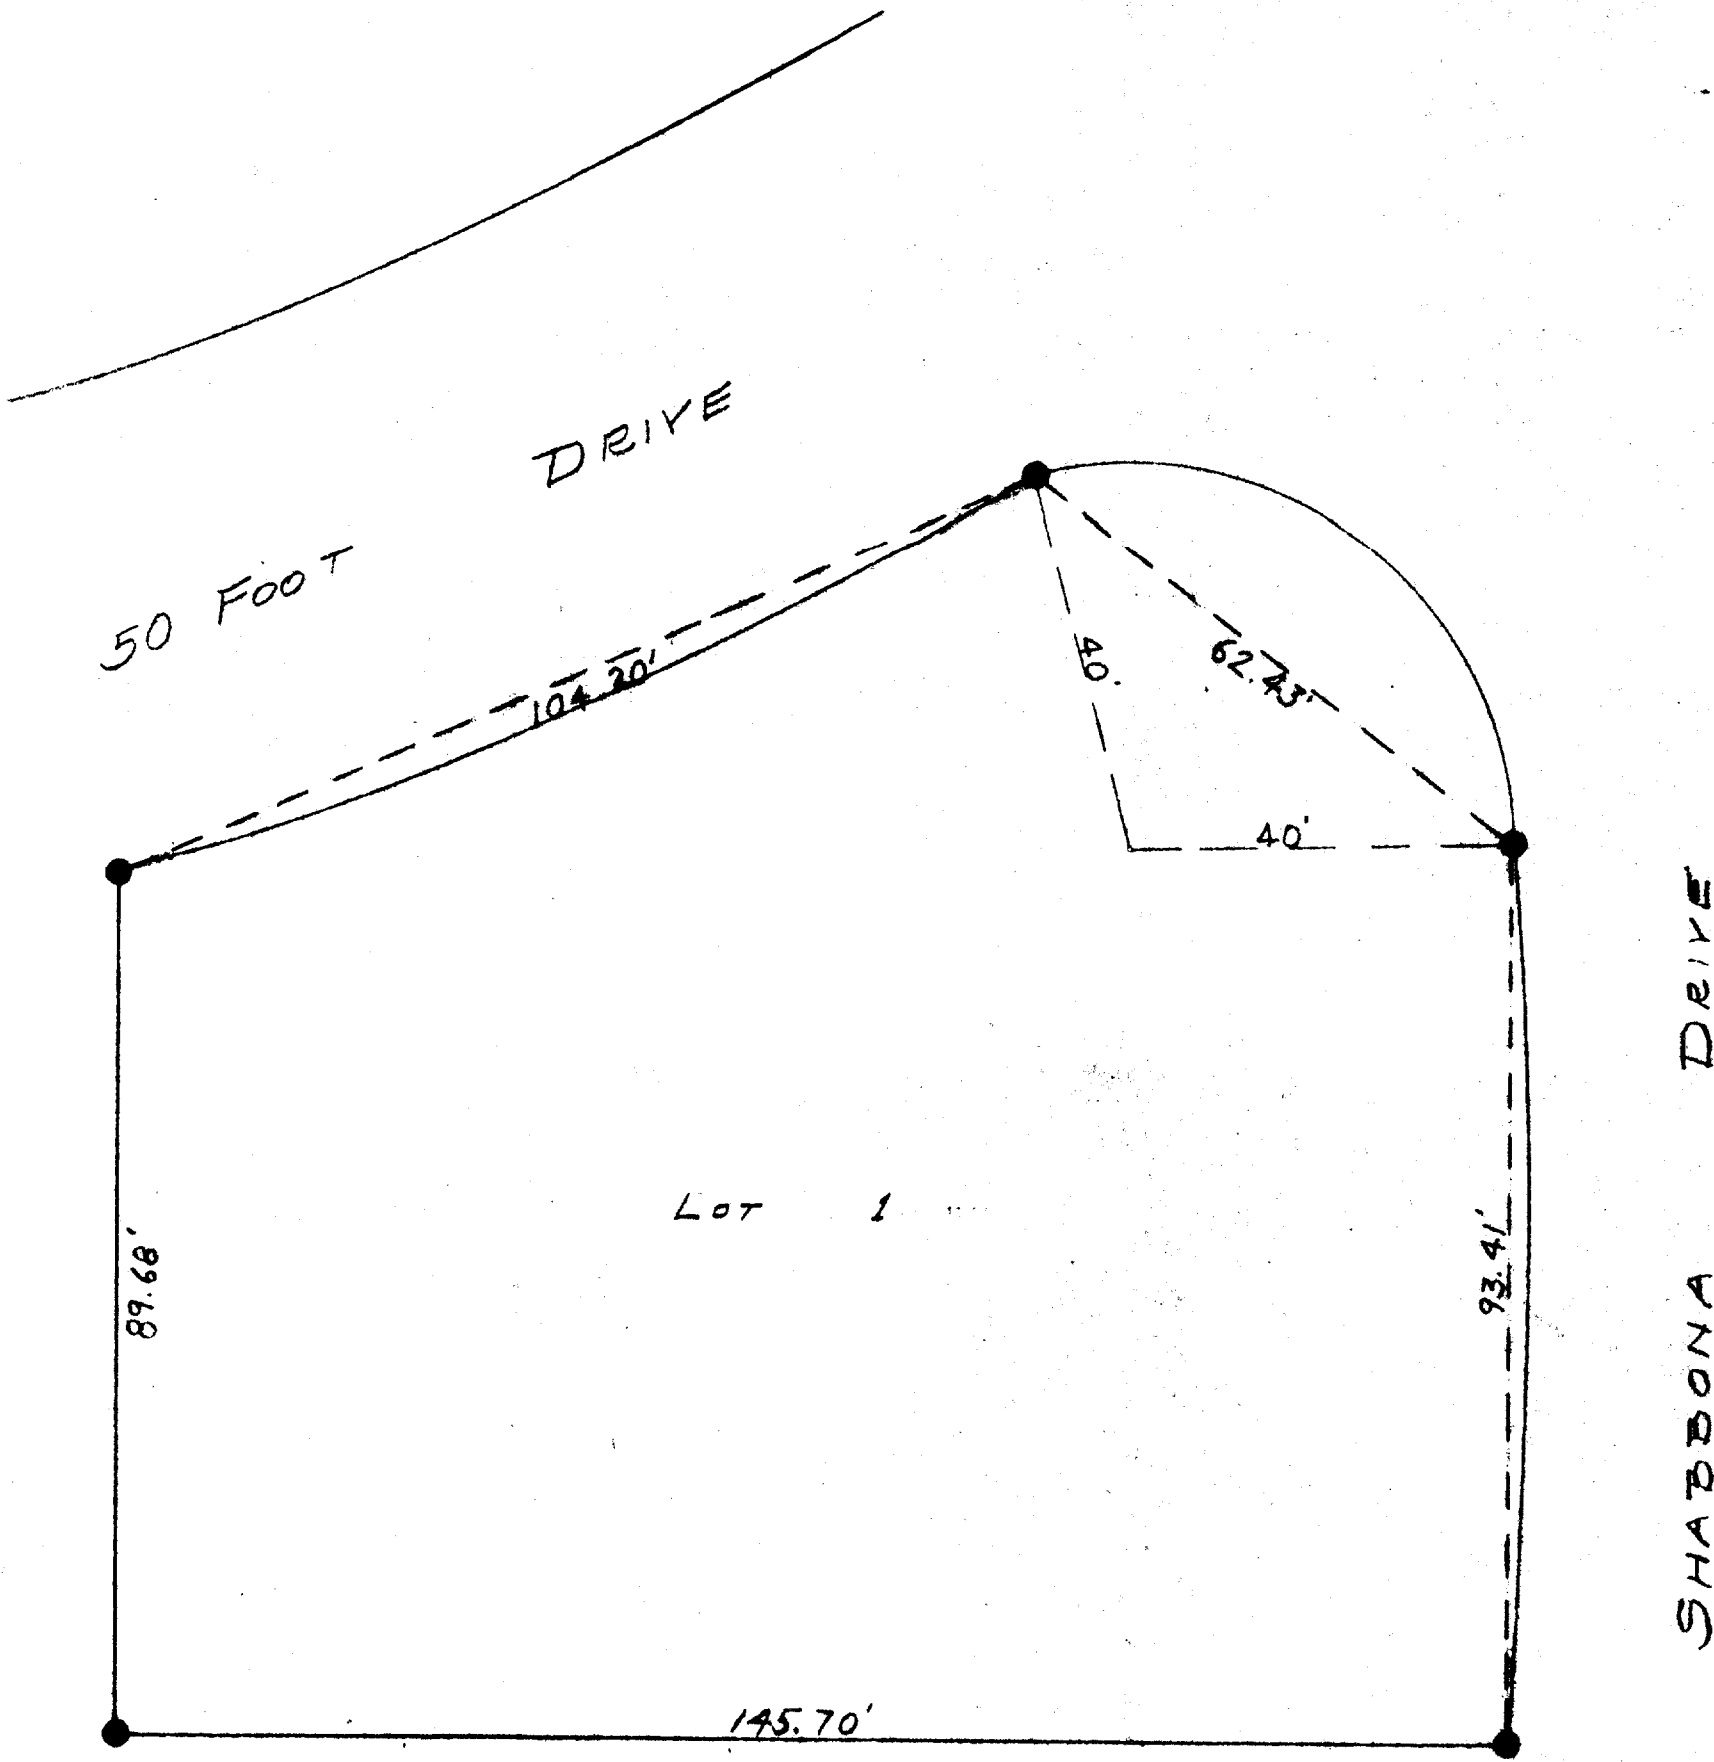

PLAT OF SURVEY OF LOT 1 UNIT
 2 OF COUNTRY CLUB ESTATES WALWORTH
 COUNTY, WISCONSIN
 OCTOBER 1, 1951

Lloyd Jensen
 COUNTY SURVEYOR

SCOR-1

5-80J