


GEORGE T. DUNHAM
SURVEYING & SUBDIVIDING
DELAVER, WISCONSIN

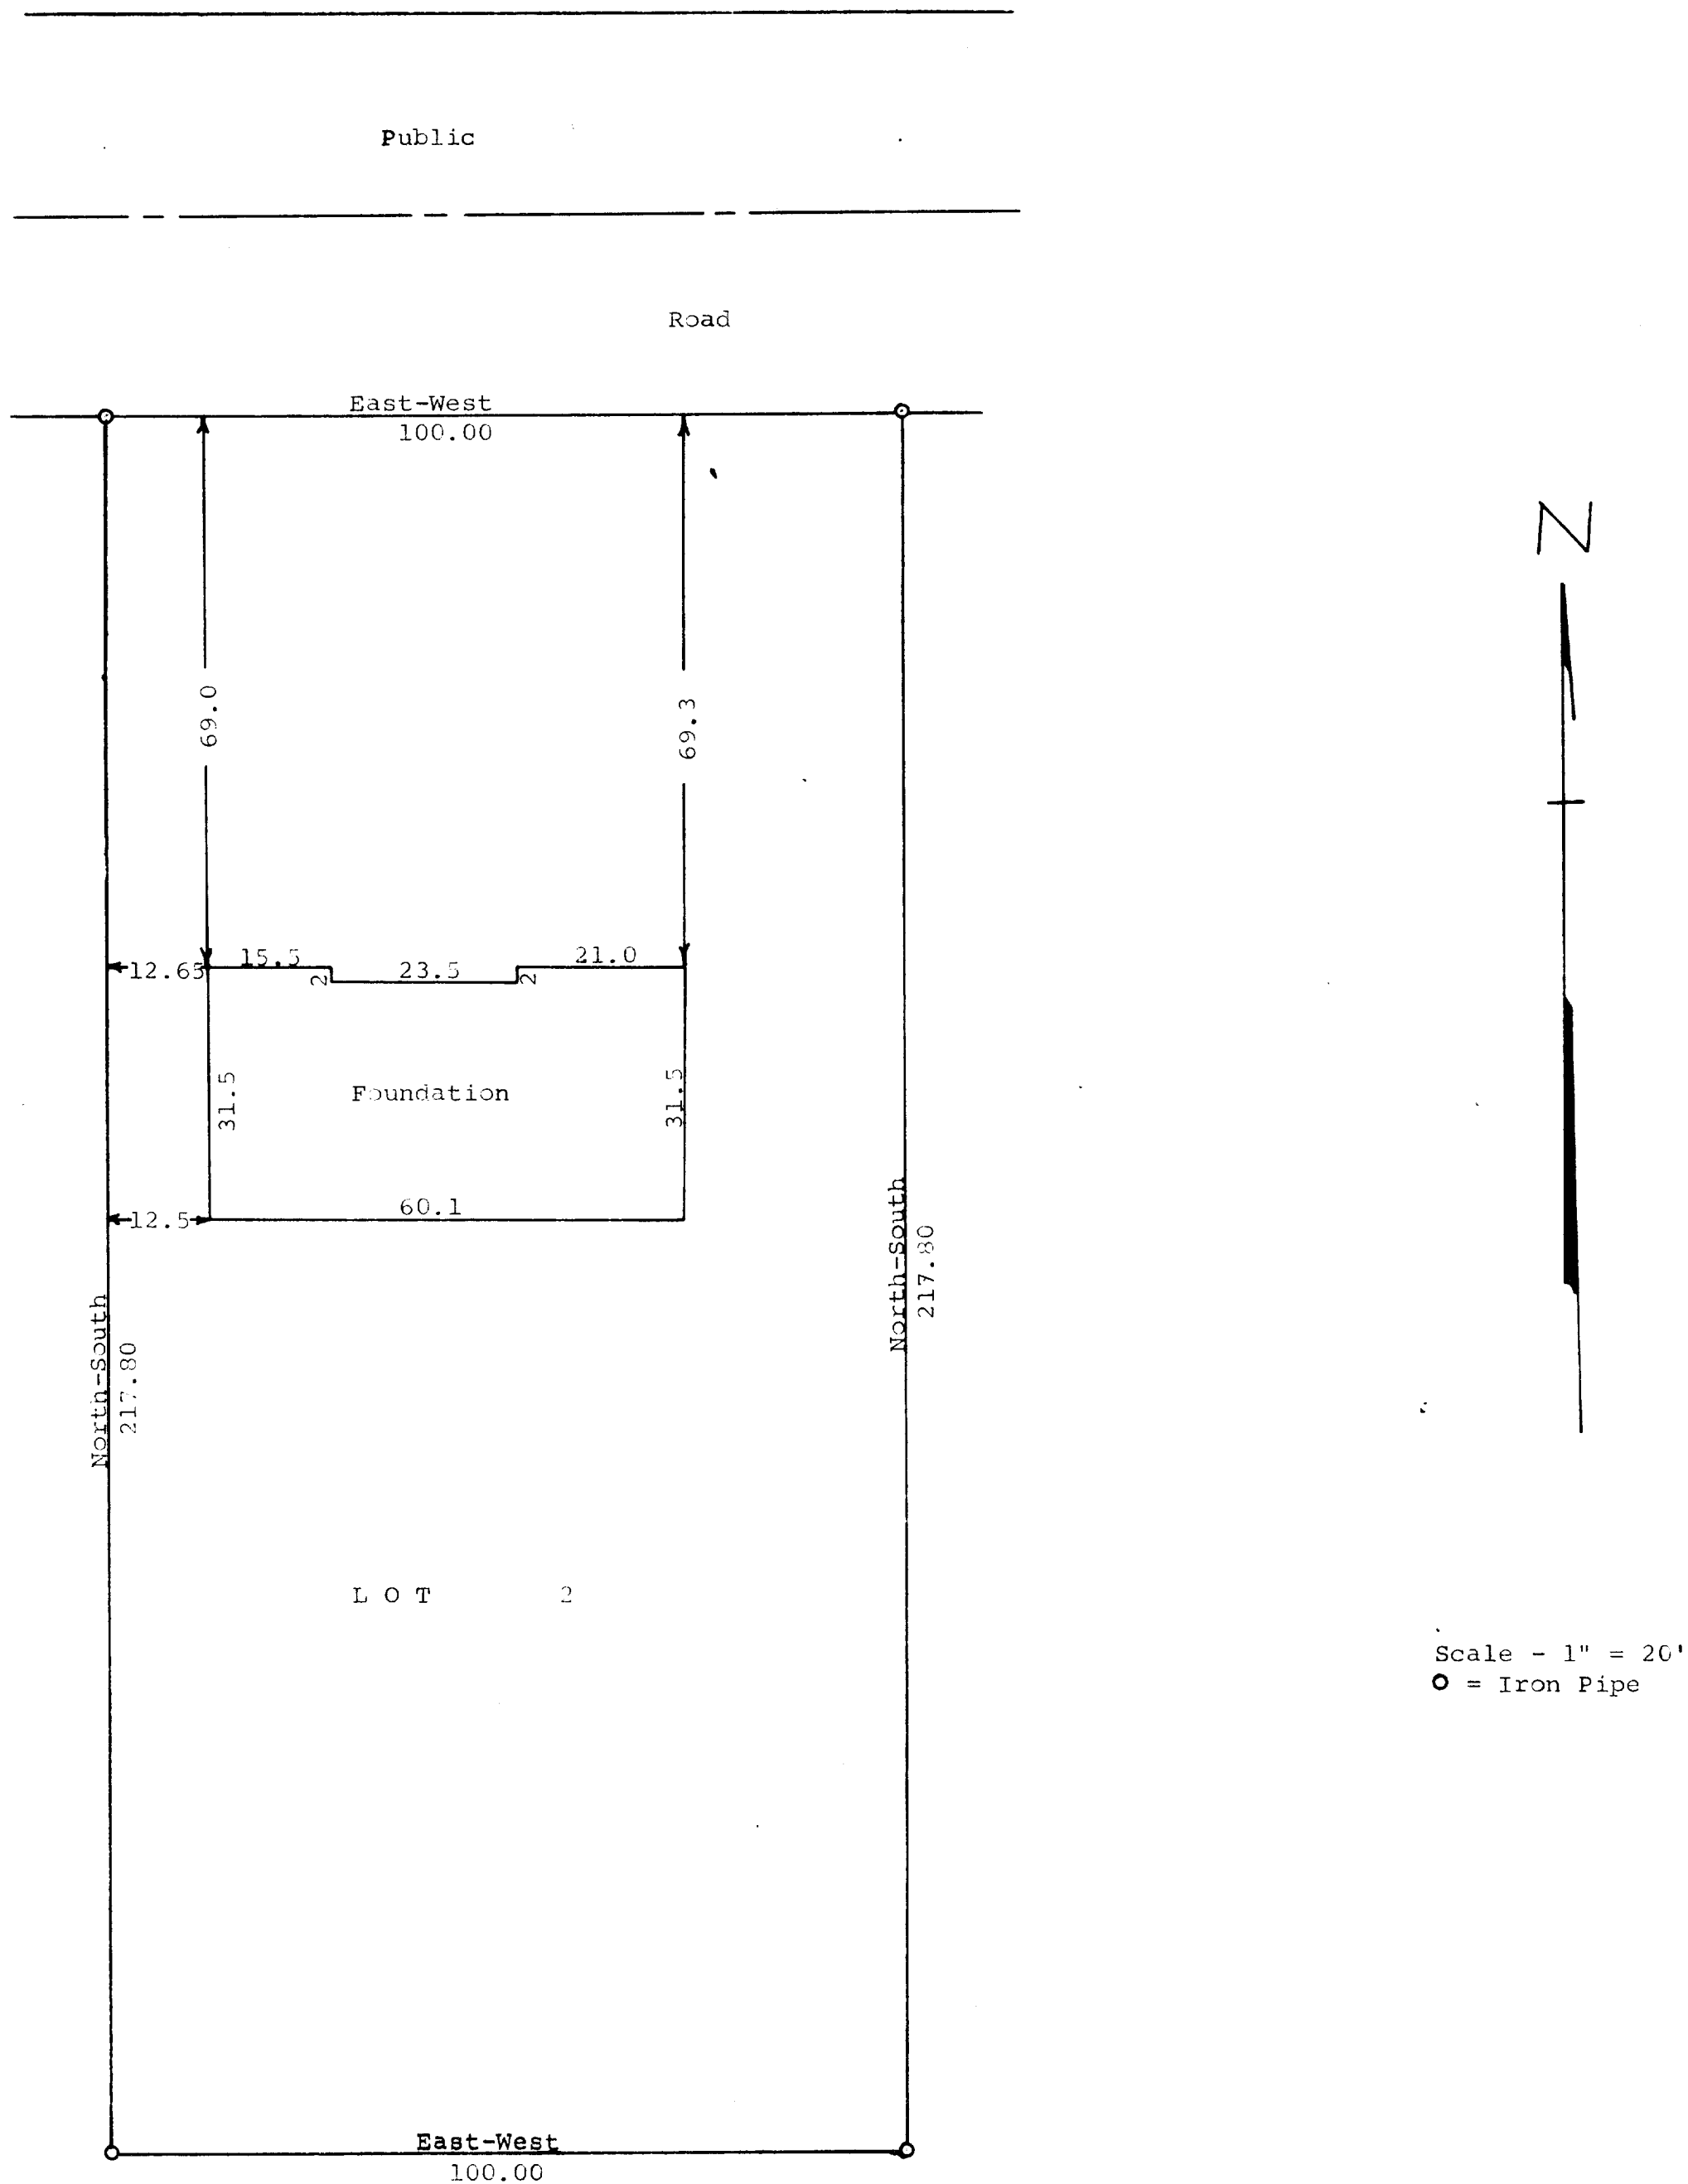

STATE OF WISCONSIN)
WALWORTH COUNTY) SS

I, George T. Dunham, Surveyor, certify that I have surveyed
the property described as follows,

Lot 2, Block 4 in Brookwood Subdivision located in Govt Lot
4 and in the NW $\frac{1}{4}$ of the SW $\frac{1}{4}$ of Section 18, T 1 N, R 17 E,
Village of Fontana, Walworth County, Wisconsin

and said survey was made at the request of FIRST FEDERAL SAVINGS & LOAN
ASSOCIATION and the above plat is an accurate survey and a true representation
thereof and correctly shows the exterior boundary lines and location of
the foundation built thereon and the correct measurements thereof.
February 15, 1966

George T. Dunham
George T. Dunham, Wis Land Surveyor No. S-306