



ABELL
SURVEYING & MAPPING
DELAVAN, WISCONSIN 53115
414-728-6737

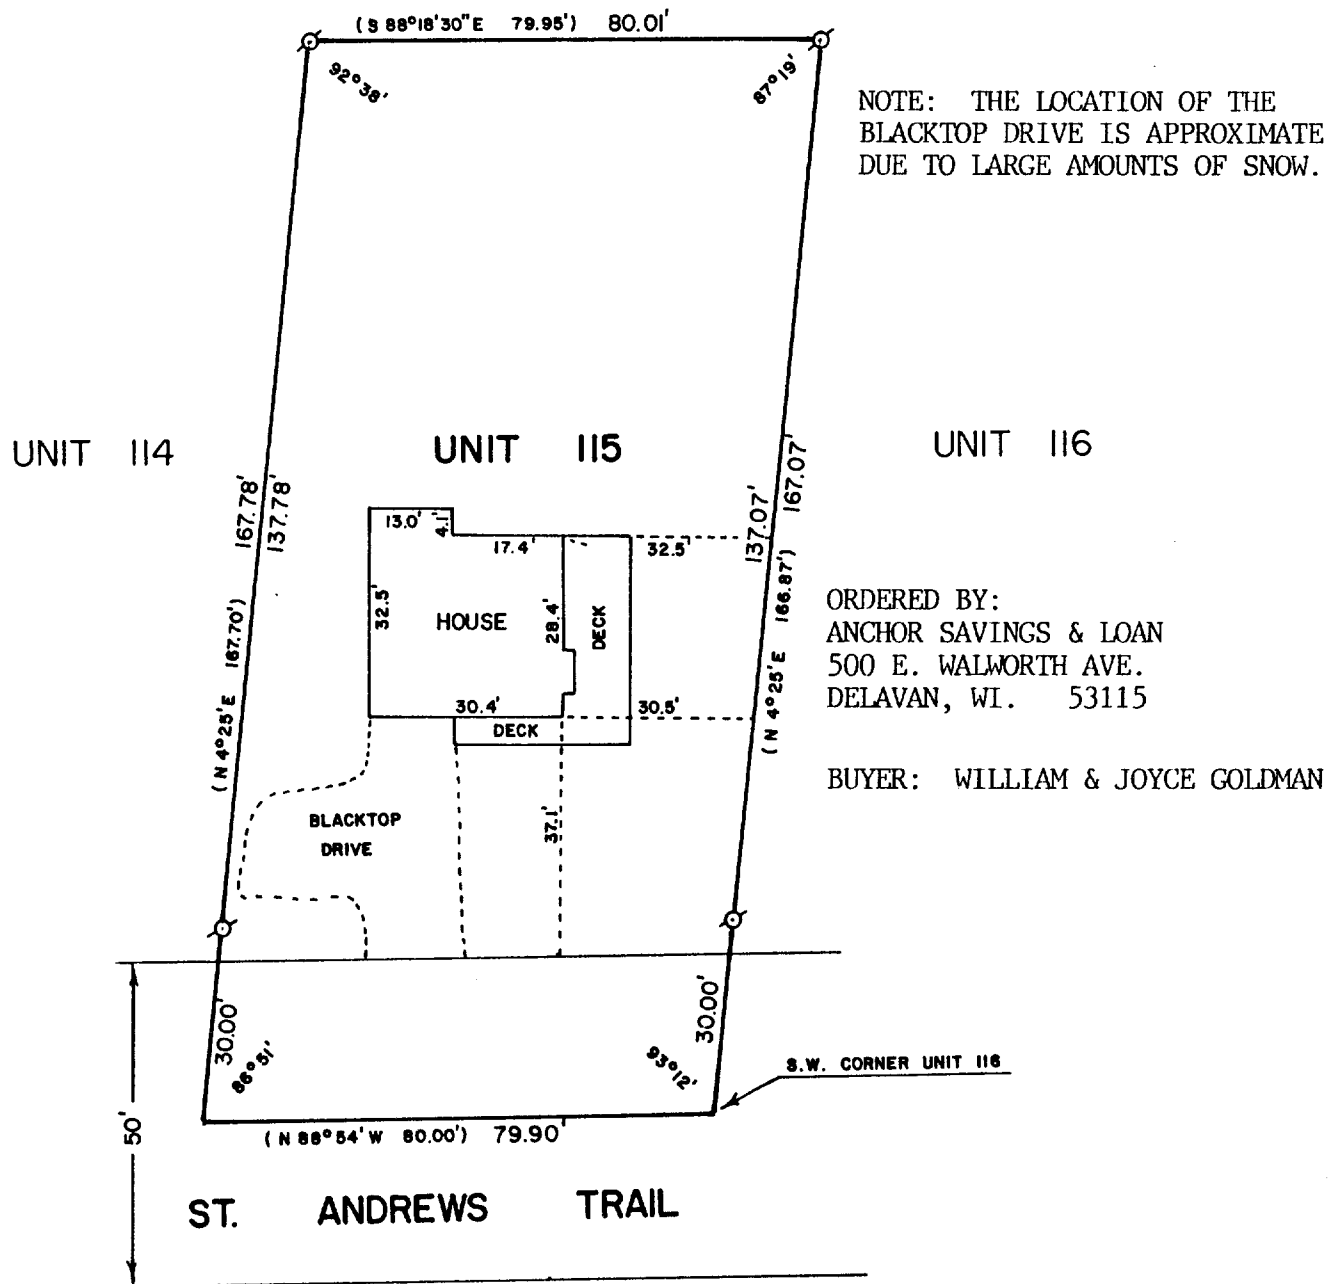

A PARCEL OF LAND LOCATED IN THE SOUTHWEST 1/4 OF THE SOUTHWEST 1/4 OF SECTION 18, TOWN 1 NORTH, RANGE 17 EAST, VILLAGE OF FONTANA-ON-GENEVA LAKE, WALWORTH COUNTY, WISCONSIN, BEING MORE PARTICULARLY DESCRIBED AS FOLLOWS:
BEGINNING AT THE SOUTHWEST CORNER OF UNIT 116 OF ABBEY SPRINGS; THENCE N 88°54' W 80.00 FEET; THENCE N 4°25' E 167.70 FEET; THENCE S 88°18'30" E 79.95 FEET; THENCE S 4°25' W 166.87 FEET TO THE PLACE OF BEGINNING, CONTAINING 0.3067 ACRES MORE OR LESS.

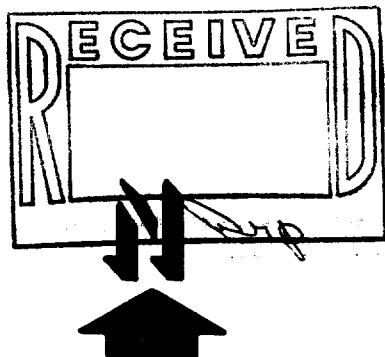

SCALE - 1"=30'

LEGEND
⊙ - IRON PIPE FOUND
() - RECORDED AS

I, DAVID F. ABELL, DO HEREBY CERTIFY THAT I HAVE SURVEYED THE PROPERTY HEREON DESCRIBED ACCORDING TO THE OFFICIAL RECORDS AND THAT THE PLAT HEREON IS A CORRECT REPRESENTATION OF THE PROPERTY LINES TO THE BEST OF MY KNOWLEDGE AND BELIEF.

David F. Abell
DAVID F. ABELL
WISCONSIN REGISTERED LAND SURVEYOR, S-1596

February 1, 1988
DATE JOB NUMBER - 88012
NOTE: THIS IS NOT A CERTIFIED COPY UNLESS SEALED. 5-814