


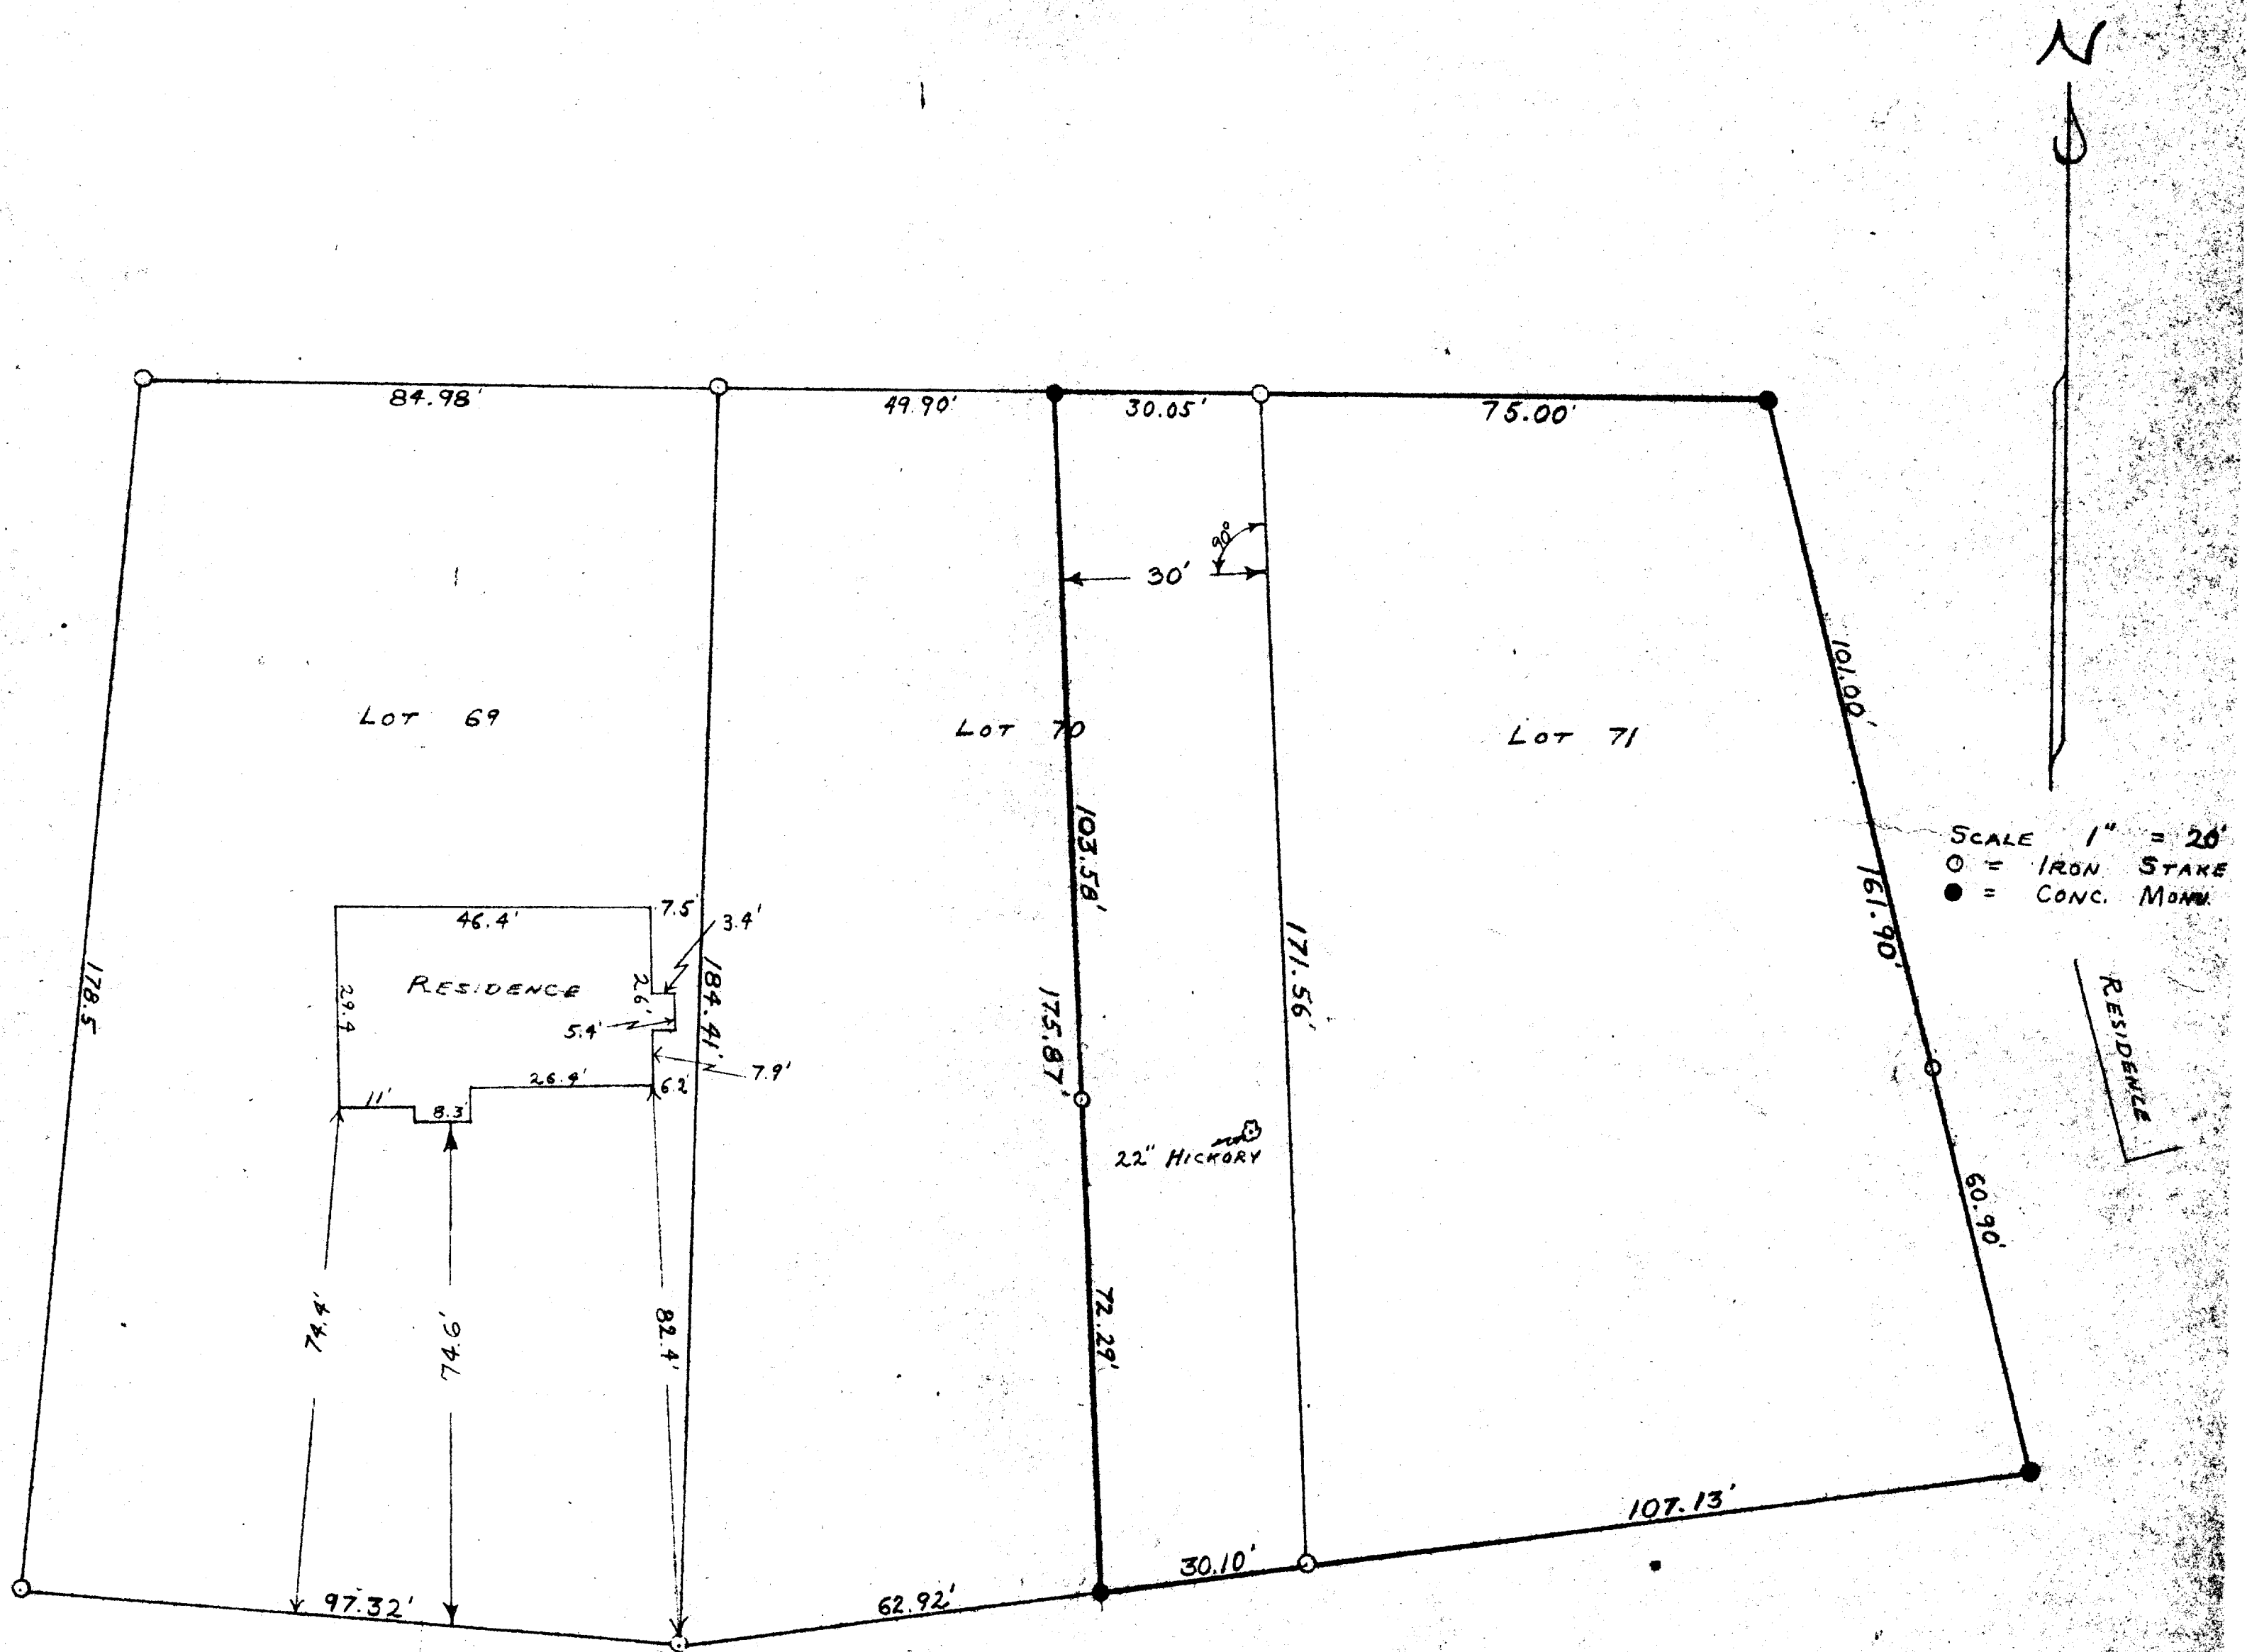

PLAT OF SURVEY OF LOTS 69 THROUGH 71 INCLUSIVE OF UNIT 2 OF COUNTRY CLUB ESTATES WALWORTH COUNTY, WISCONSIN
NOVEMBER 6, 1951

Lloyd L. Jensen
COUNTY SURVEYOR

5-85

SC02-64 SC02-66
" 65 " 67