


**ABELL
SURVEYING & MAPPING
DELAVER, WISCONSIN 53115
414-728-6737**

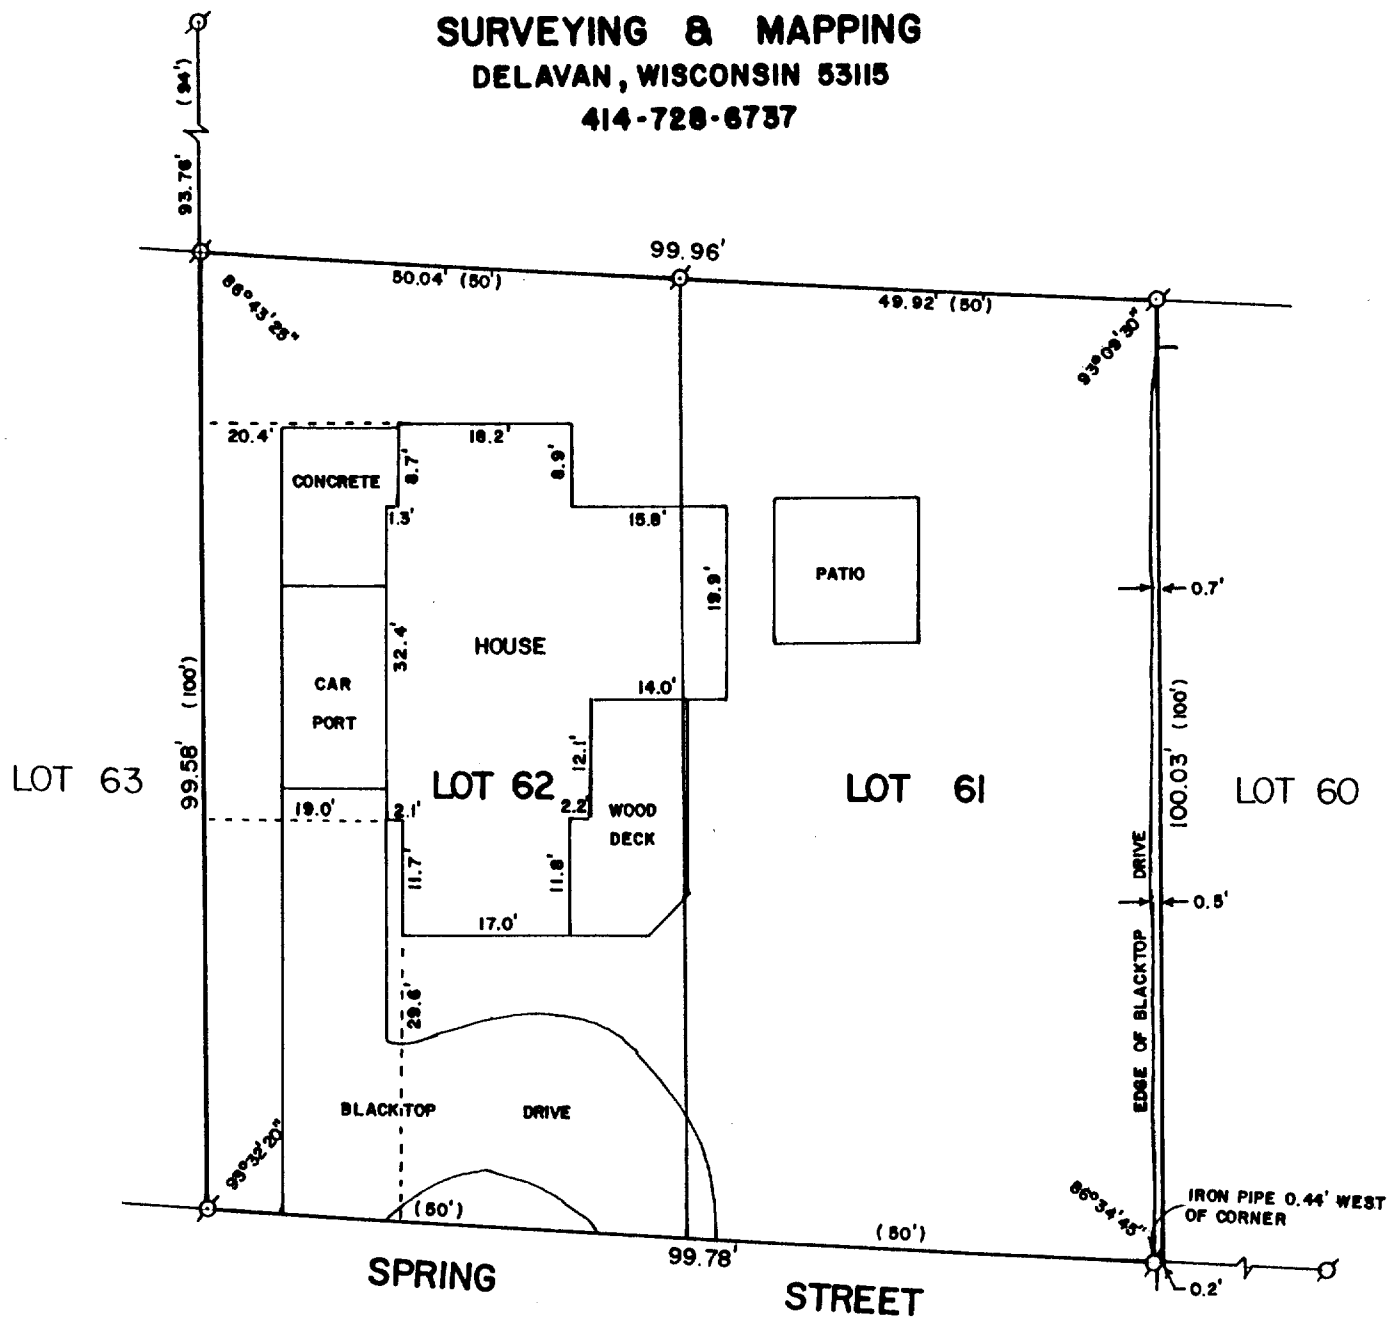


PLAT OF SURVEY OF

LOTS 61 AND 62, BUENA VISTA, A SUBDIVISION LOCATED
IN THE VILLAGE OF FONTANA-ON-GENEVA LAKE, WALWORTH
COUNTY, WISCONSIN.

ORDERED BY: ANCHOR SAVINGS
P.O. BOX 508
LAKE GENEVA, WI. 53147

OWNER: KENNETH & ELIZABETH SHAY

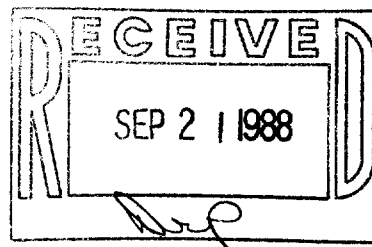

SCALE - 1"=20'

LEGEND

Ø - IRON PIPE FOUND
() - RECORDED AS

I, DAVID F. ABELL, DO HEREBY CERTIFY
THAT I HAVE SURVEYED THE PROPERTY
HEREON DESCRIBED ACCORDING TO THE
OFFICIAL RECORDS AND THAT THE PLAT
HEREON IS A CORRECT REPRESENTATION
OF THE PROPERTY LINES TO THE BEST OF
MY KNOWLEDGE AND BELIEF.

David F. Abell

DAVID F. ABELL
WISCONSIN REGISTERED LAND SURVEYOR, S-1596

August 12, 1988
DATE JOB NUMBER - 88169

NOTE: THIS IS NOT A CERTIFIED COPY UNLESS SEALED. 5-862