


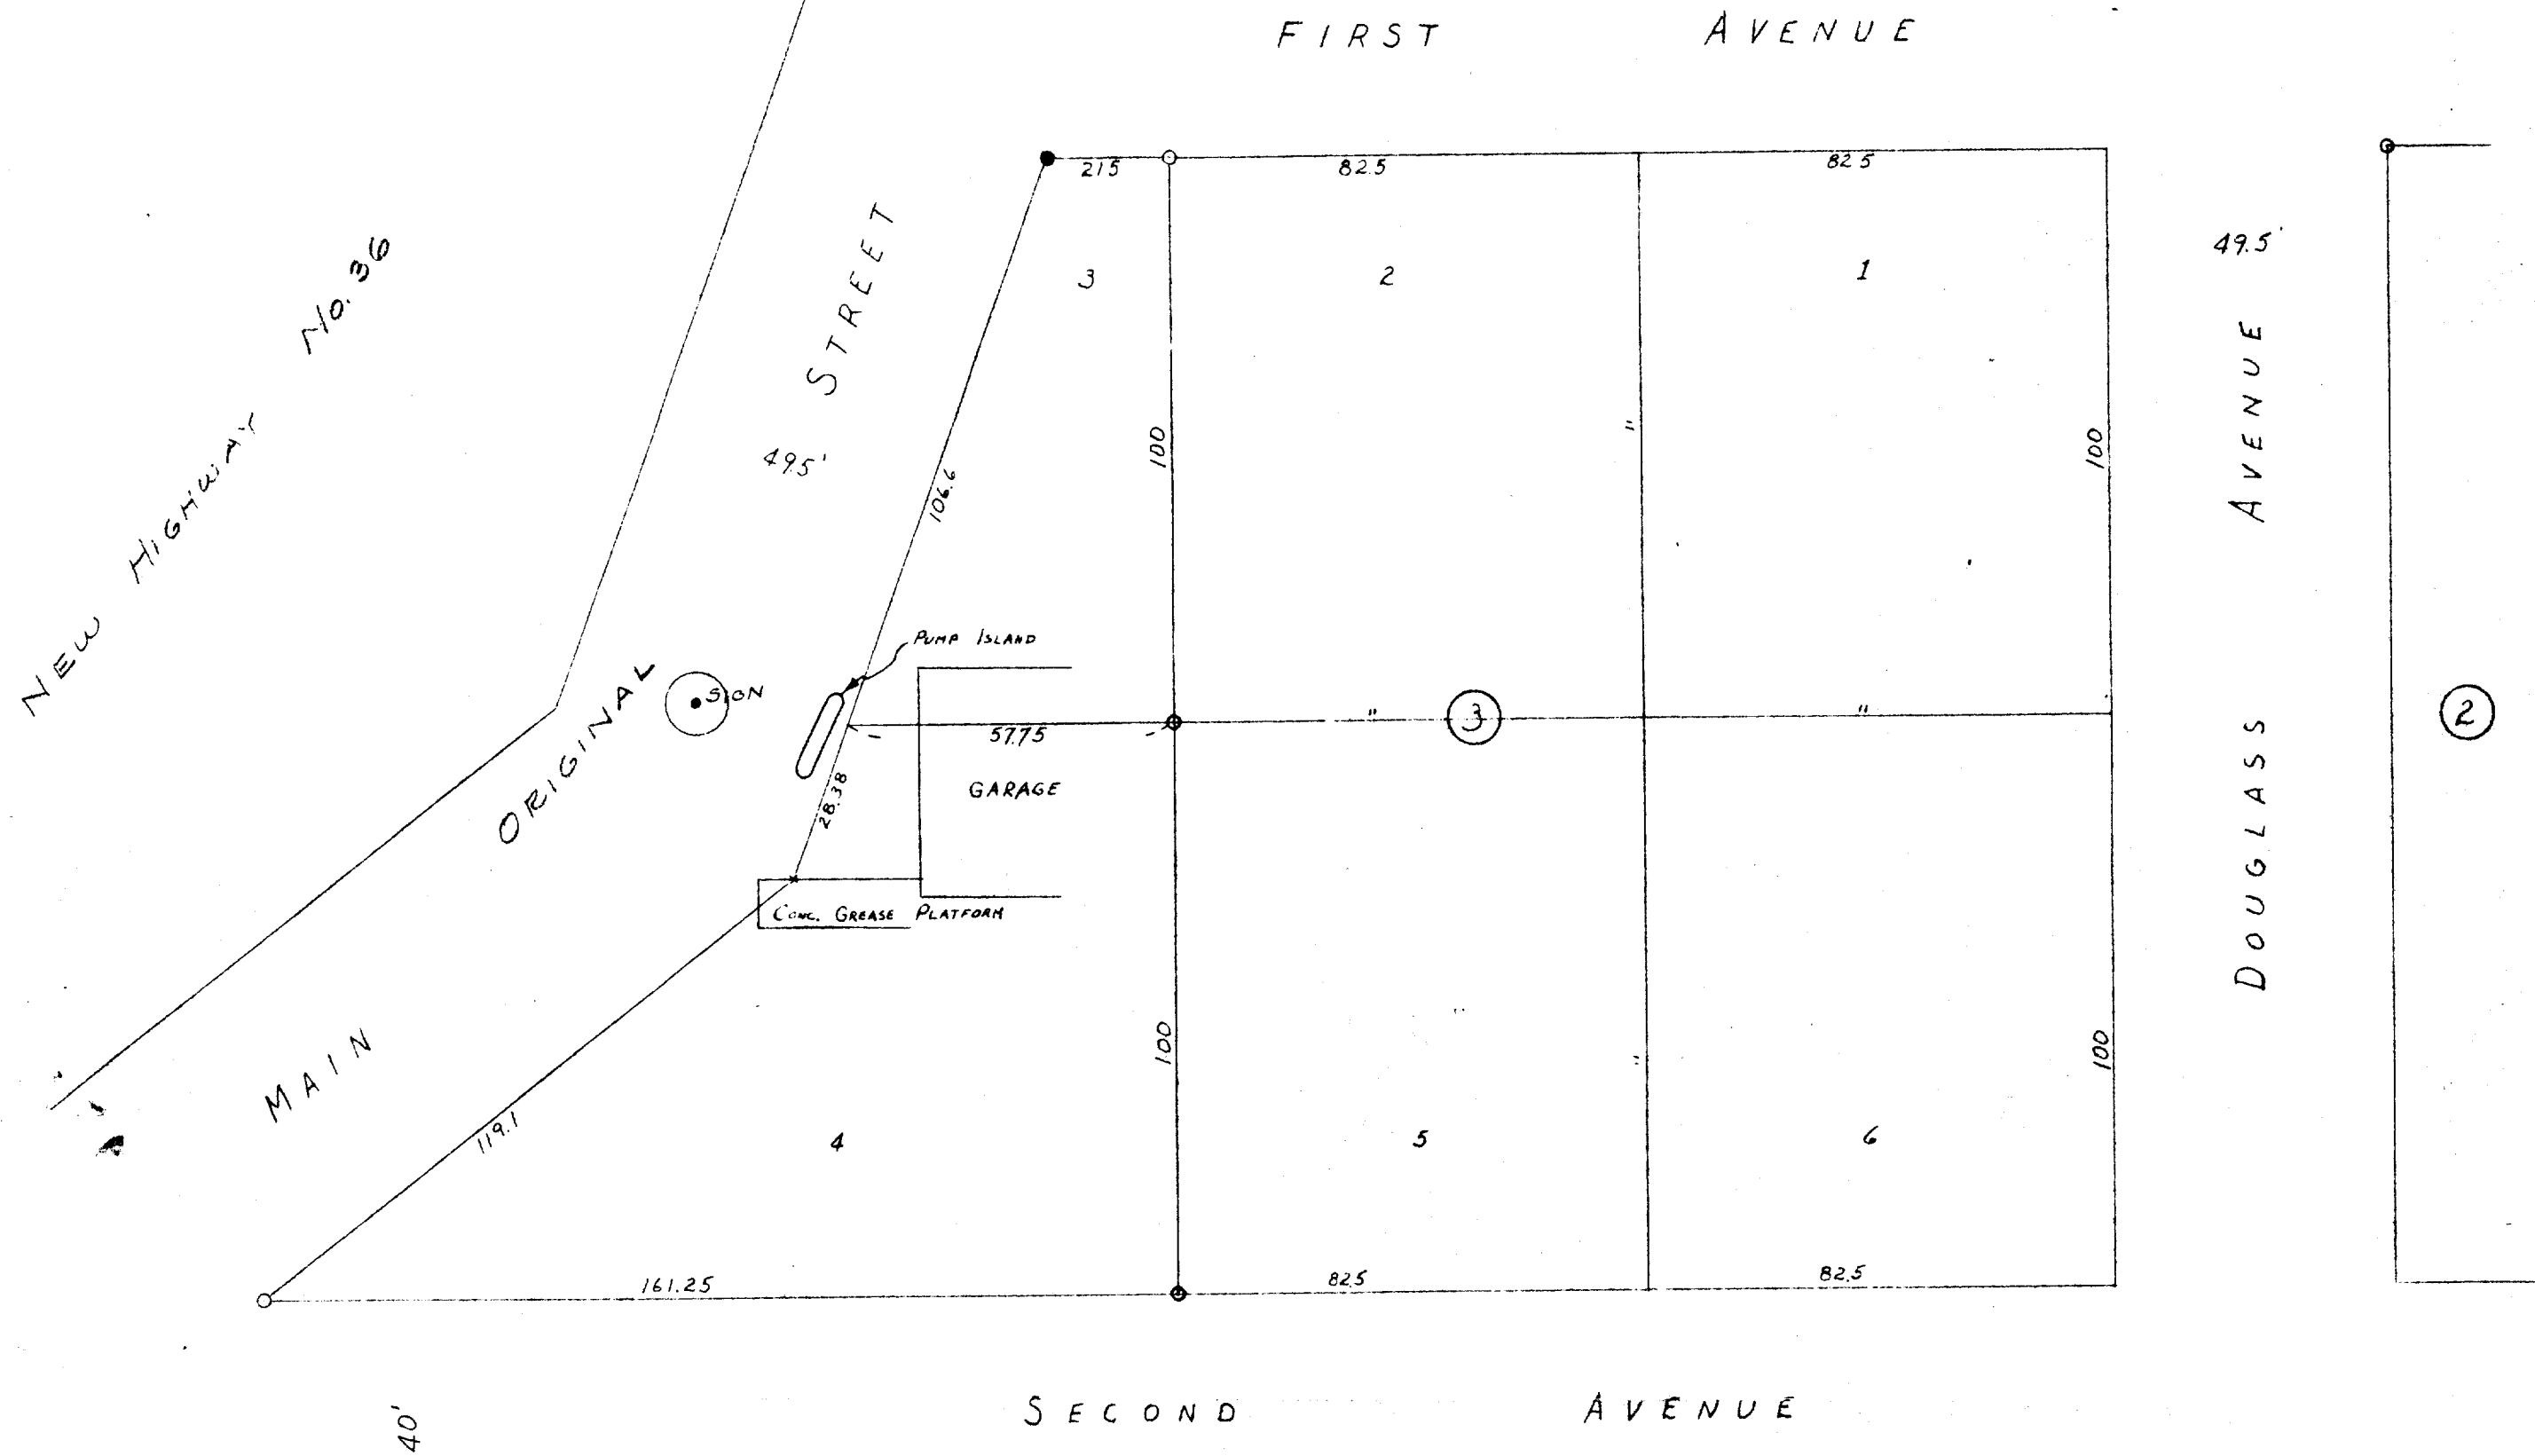

PLAT OF SURVEY OF PART OF THE WEST LINE OF BLOCKS 3
OF FONTANA-ON-GENEYA LAKE, WALWORTH COUNTY, WIS.

MARCH 1953

Lloyd L. Jensen
WALWORTH COUNTY SURVEYOR

LEGEND

- O - IRON PIPE
- - CONCRETE MONUMENT
- X - CROSS IN CONCRETE

SCALE 1" = 30'