
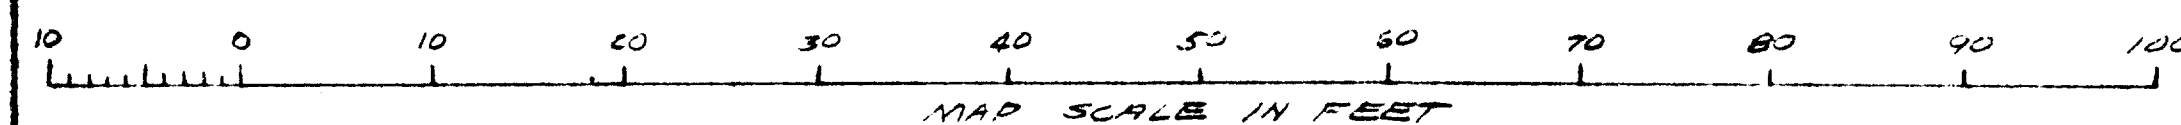


COMPUTER COORDINATE FILE			
POINT	DESIGNED	NORTH	EAST
10 SN	1005.45	1499.23/	
11 SN	1042.13	1707.84/	
101 FP	1122.83	1309.03/	
102 FP	1130.86	1472.93/	
103 FP	1080.94	1474.86/	
104 FP	1030.96	1476.80/	
105 FP	1033.73	1403.04/	
106 FP	1015.45	1300.84/	
200 COR26/27	1070.45	1512.17/	
700 RES COR	1007.85	1552.48/	
701 RES COR	1034.05	1556.60/	
702 RES COR	1059.44	1558.95/	
703 RESCOR	1070.39	1369.11/	
704 RES COR	1067.98	1561.35/	
705 RES COR	1003.81	1396.56/	
706 RES COR	1011.72	1396.56/	
707 RES COR	1064.41	1591.08/	
708 RES COR	1085.52	1587.11/	
709 MH	1058.63	1690.41/	
800 BOLT VAL	1069.80	1580.55/	
801 CENTER	1076.19	1162.15/	

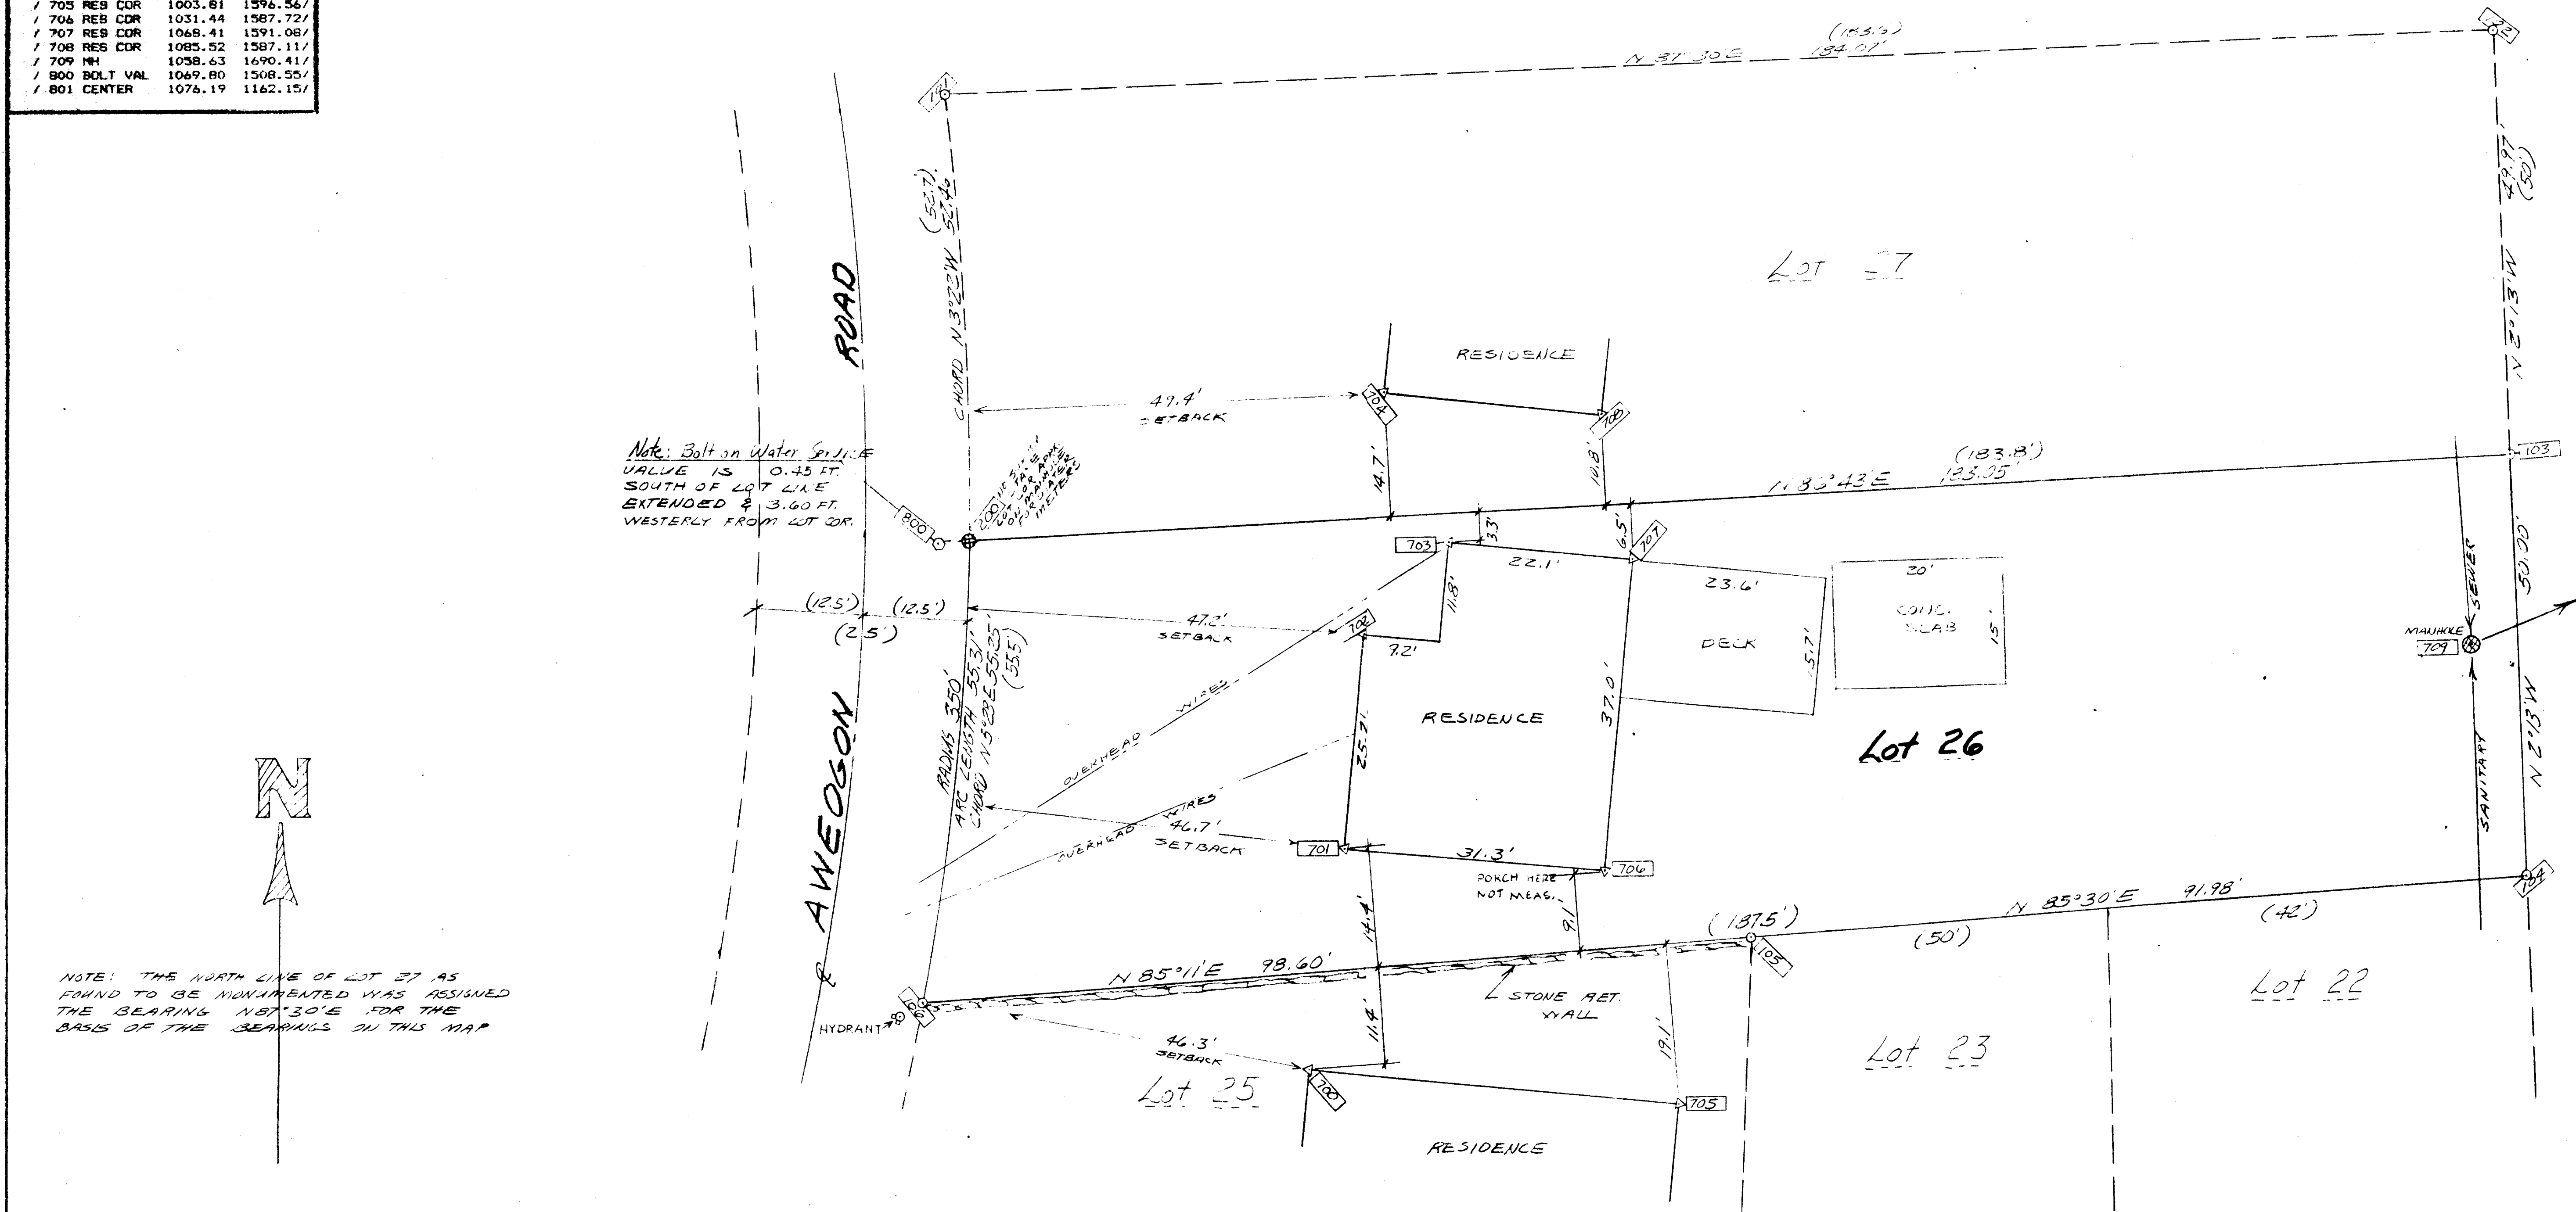

0 = IRON PIPE SURVEY STAKE FOUND
(xxx) = ORIG. SUB. PLAT DIMENSION
xxx = DIMENSIONAL MEAS. OR CALC. FROM MEAS. FOR THIS SURVEY
[] = COMPUTER COORDINATE FILE POINT REFERENCE NUMBER

☐ = COMPUTER COORDINATE FILE POINT REFERENCE NUMBER

 = COMPUTER COORDINATE FILE POINT REFERENCE NUMBER

Farris, Hansen & Associates, Inc.

7 RIDGEWAY COURT, P. O. BOX 4237, ELMHORN, ILLINOIS 60120	TEL. 414-723-2098	
7 RIDGEWAY COURT, P. O. BOX 4237, ELMHORN, ILLINOIS 60120		

7 RIDGEWAY COURT, P.O. BOX 437, ELKHORN, WISCONSIN

TEL. 414-723-2098

NOTE: COPIES OF THIS MAP TO WHICH THE FOLLOWING CERTIFICATE WILL APPLY ARE BLUE LINE PRINTS SHOWING SURVEYOR'S SEAL AND SIGNATURE IN BLACK INK. COPIES BY ANY OTHER MEANS MAY HAVE ALTERATIONS WHICH DO NOT REPRESENT THE SURVEYOR'S WORK PRODUCT.

Plat of Survey of Lot 26 of the Subdivision of Block 6 of
Indian Hills Subdivision in Sec. 14, T. 1N, R. 16, Wauworth County, Wt.
for

Herman L. Larson Jr. as ordered by Visner Construction

I HEREBY CERTIFY THIS PLAT OF SURVEY TO BE A TRUE AND ACCURATE REPRESENTATION OF THE LOT LINES AND BUILDINGS THEREON TO THE BEST OF MY PROFESSIONAL KNOWLEDGE AND BELIEF.

DATED JULY 12, 1988

PROJECT NO. 3055