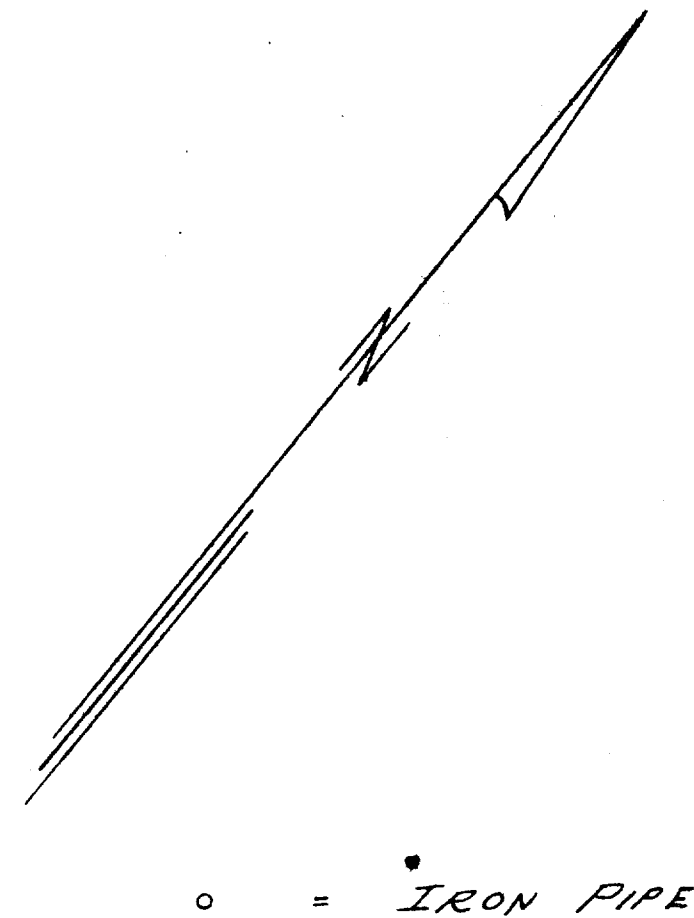
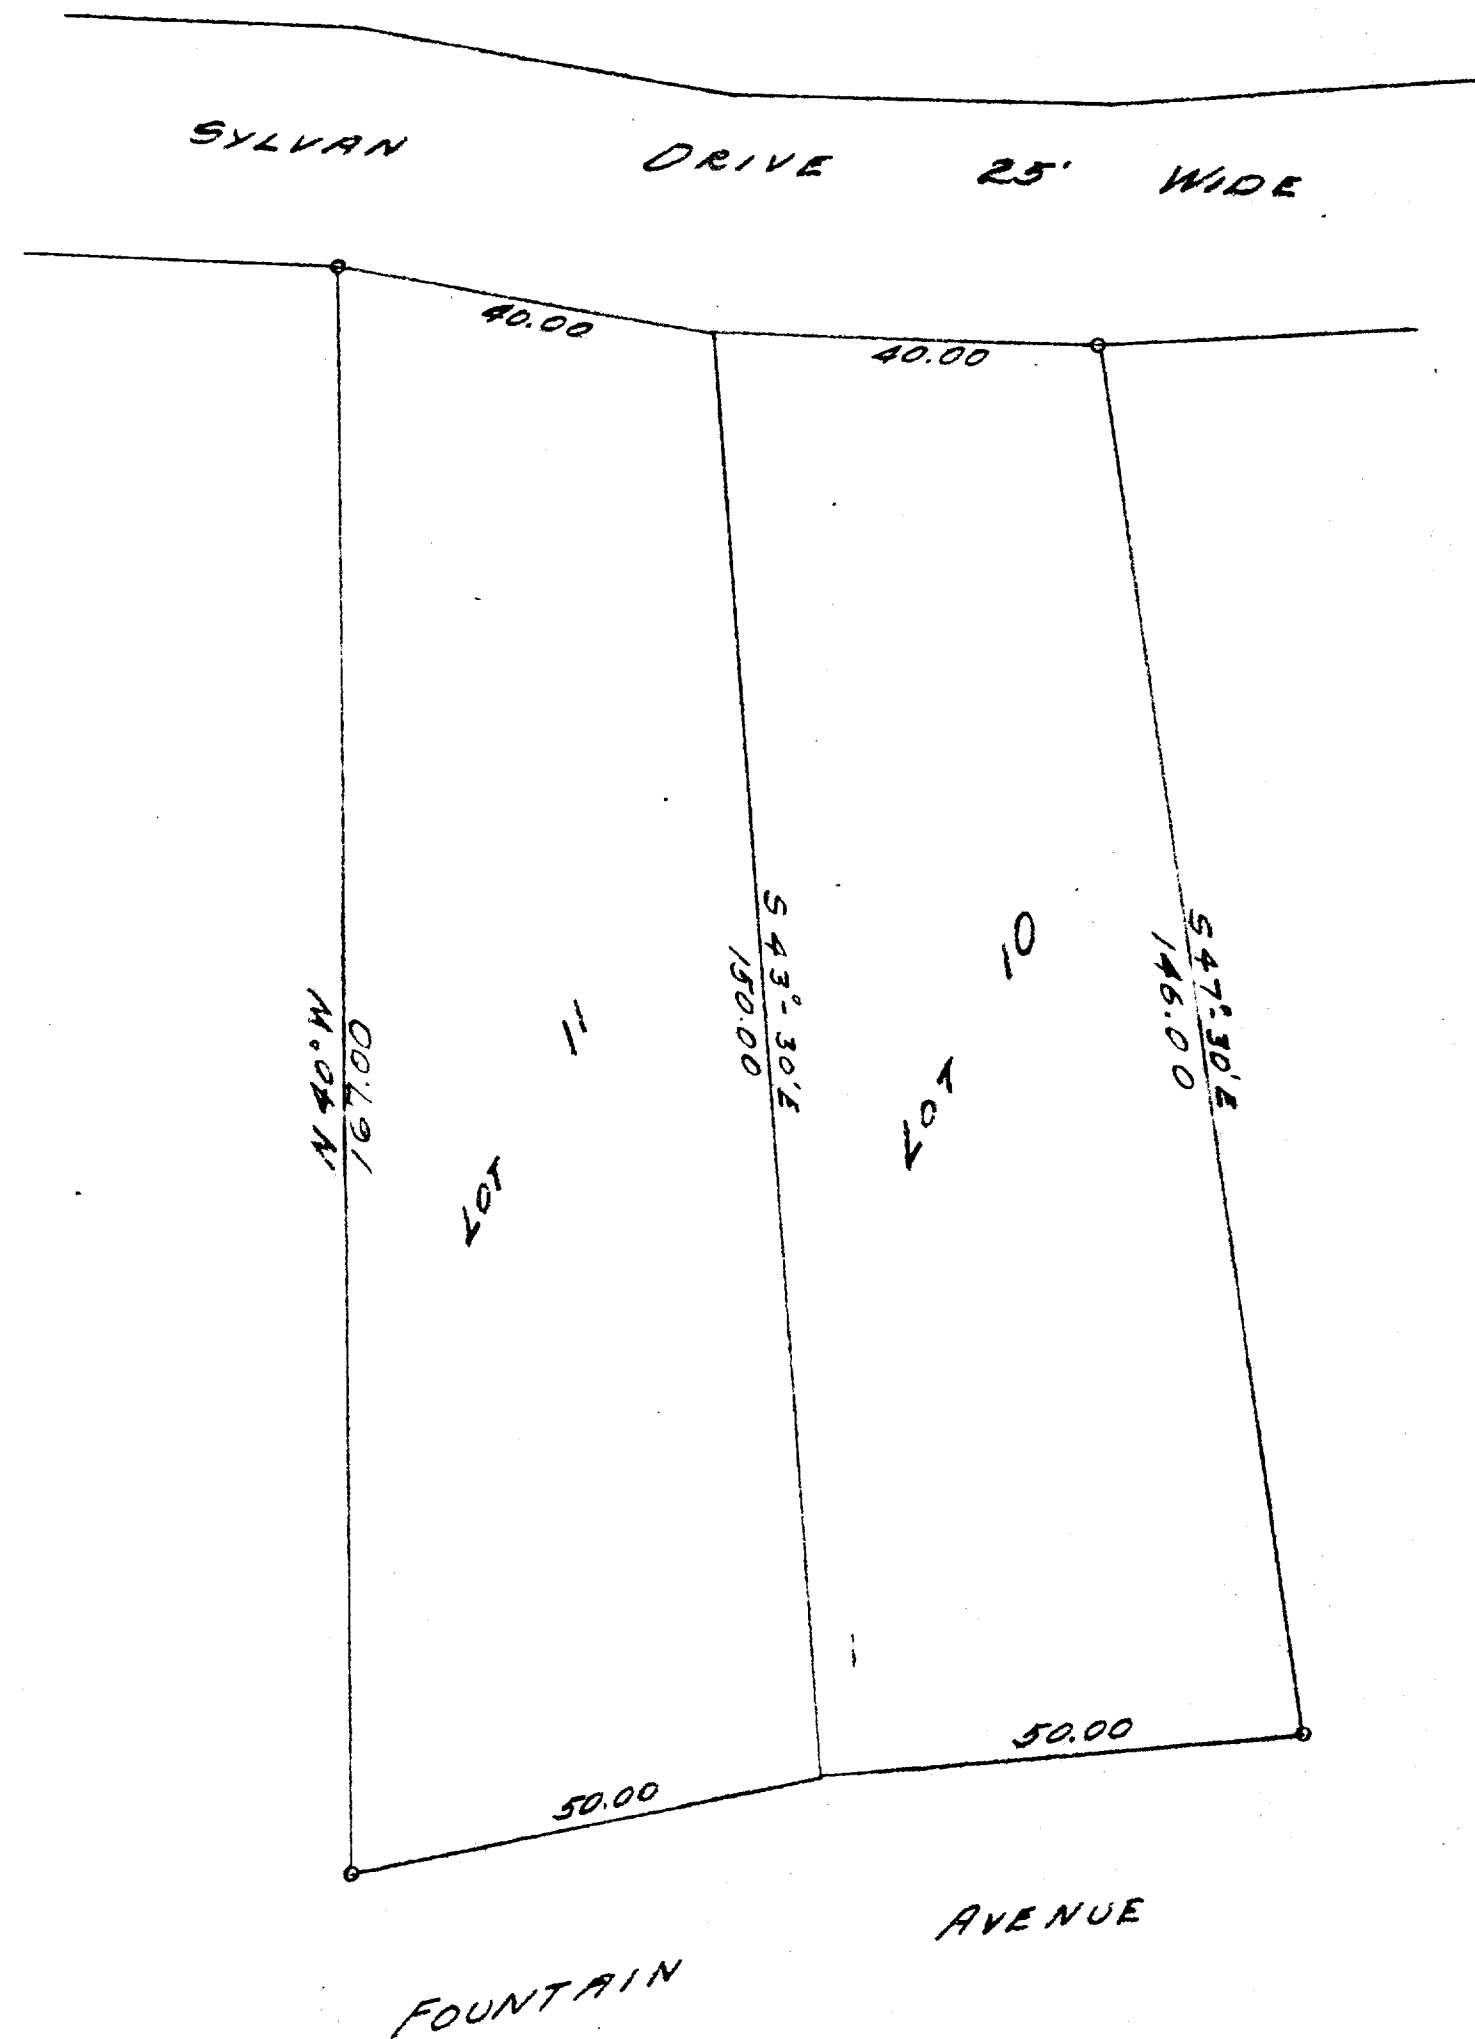


PLAT OF SURVEY OF LOT 10 AND LOT 11 BUENA VISTA SUBDIVISION VILLAGE OF FONTANA WALWORTH CO, WISCONSIN	
<i>Lloyd L. Jensen</i> SURVEYOR	DATE <u>JUNE 1953</u>
SCALE 1" = 20'	

5-89 J