

7 RIDGEWAY COURT, P.O. BOX 417, ELKHORN, WISCONSIN


TEL. 414-723-2098

LOCATION: PLAT OF SURVEY OF
LOT 8, BLOCK 3, ASSESSOR'S PLAT #1
VILLAGE OF FONTANA, WALWORTH CO., WIS.
EXCEPTING THEREFROM LANDS DESCRIBED
IN VOL 221 PG 492 DOC # 333774


MAP LEGEND

- - IRON PIPE STAKE FOUND
 - - IRON PIPE STAKE SET
 - - IRON ROD STAKE FOUND
 - - IRON ROD STAKE SET
 - - CONCRETE MONUMENT FOUND
 - (XXXXX) - RECORD DIMENSION
- = pole & GUY WIRE
- — — — — OVERHEAD WIRES


MAP SCALE IN FEET

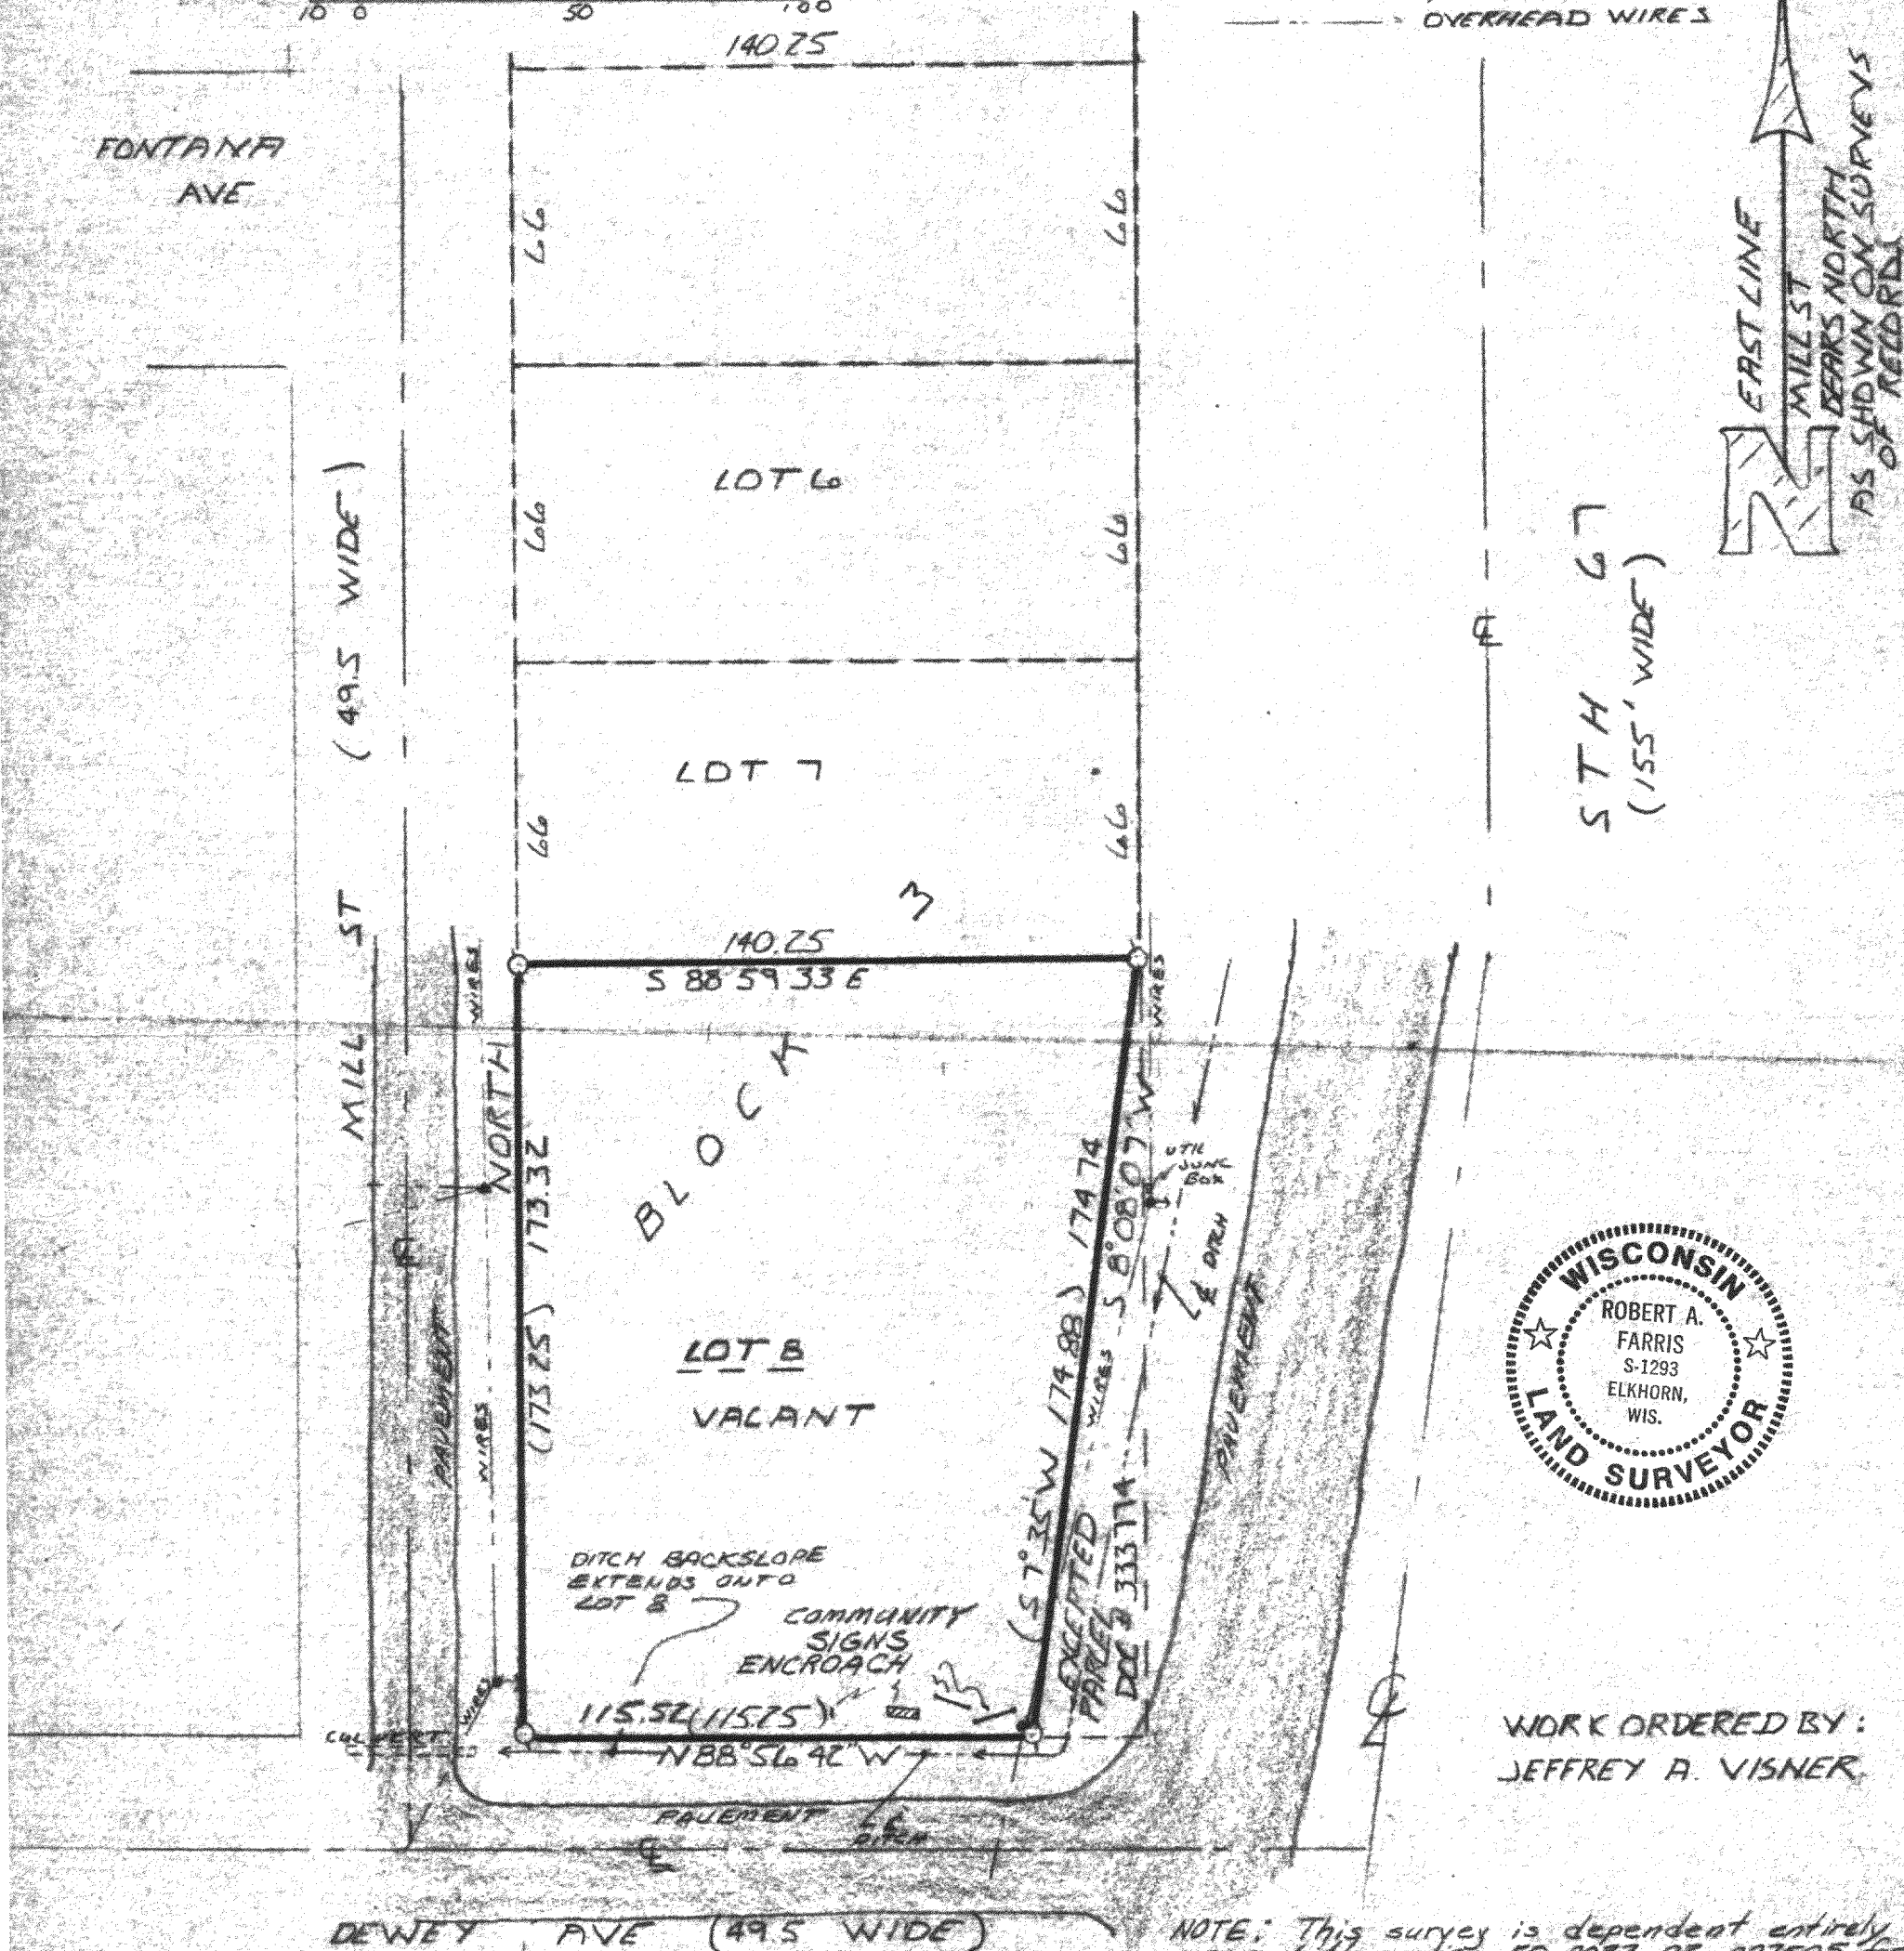

WORK ORDERED BY:
JEFFREY A. VISNER

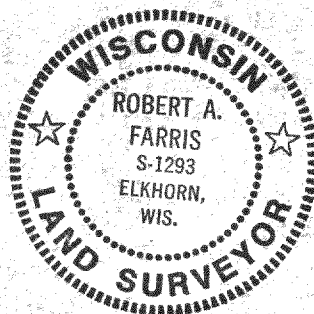

NOTE: This survey is dependent entirely upon title policy 50 0087 02 007505 for the purpose of disclosing all matters of record affecting title to this parcel. This policy was provided to the surveyor for the purpose of defining his contract.

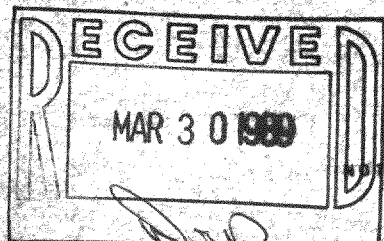

NOTE: COPIES OF THIS MAP TO WHICH THE FOLLOWING CERTIFICATE WILL APPLY ARE BLUE LINE PRINTS SHOWING SURVEYOR'S SEAL AND SIGNATURE IN BLACK INK. COPIES BY ANY OTHER MEANS MAY HAVE ALTERATIONS WHICH DO NOT REPRESENT THE SURVEYOR'S WORK PRODUCT.

I hereby certify that the above described property has been surveyed under my direction and that the above map is a true representation thereof and shows the size and location of the property, its exterior boundaries, the location of all visible structures and dimensions of all principal buildings thereon, boundary fences, apparent easements, roadways and visible encroachments, if any. This survey is made for the use of the present owners of the property, and also those who purchase, mortgage, or guarantee the title thereto within one year from the date hereof.

5-936

DATED: 12-28-88

Robert C. Farris

PROJ. NO. 2387

STFV-203