

Farris, Hansen & Associates, Inc.

7 RIDGEWAY COURT, P.O. BOX 437, ELKHORN, WISCONSIN

TEL. 414-723-2098



LOCATION: UNIT 597 ABBEY SPRINGS CONDOMINIUM 13
SECTION 13, T. 1 N., R. 16 E., VILLAGE OF
FONTANA, WALWORTH CO., WISCONSIN
WORK ORDERED BY:
KEN KUBIESA

MAP LEGEND


- Ø = IRON PIPE STAKE FOUND
- = IRON PIPE STAKE SET
- = IRON ROD STAKE FOUND
- = IRON ROD STAKE SET
- = CONCRETE MONUMENT FOUND

(XXXXX) = RECORD DIMENSION


MAP SCALE IN FEET

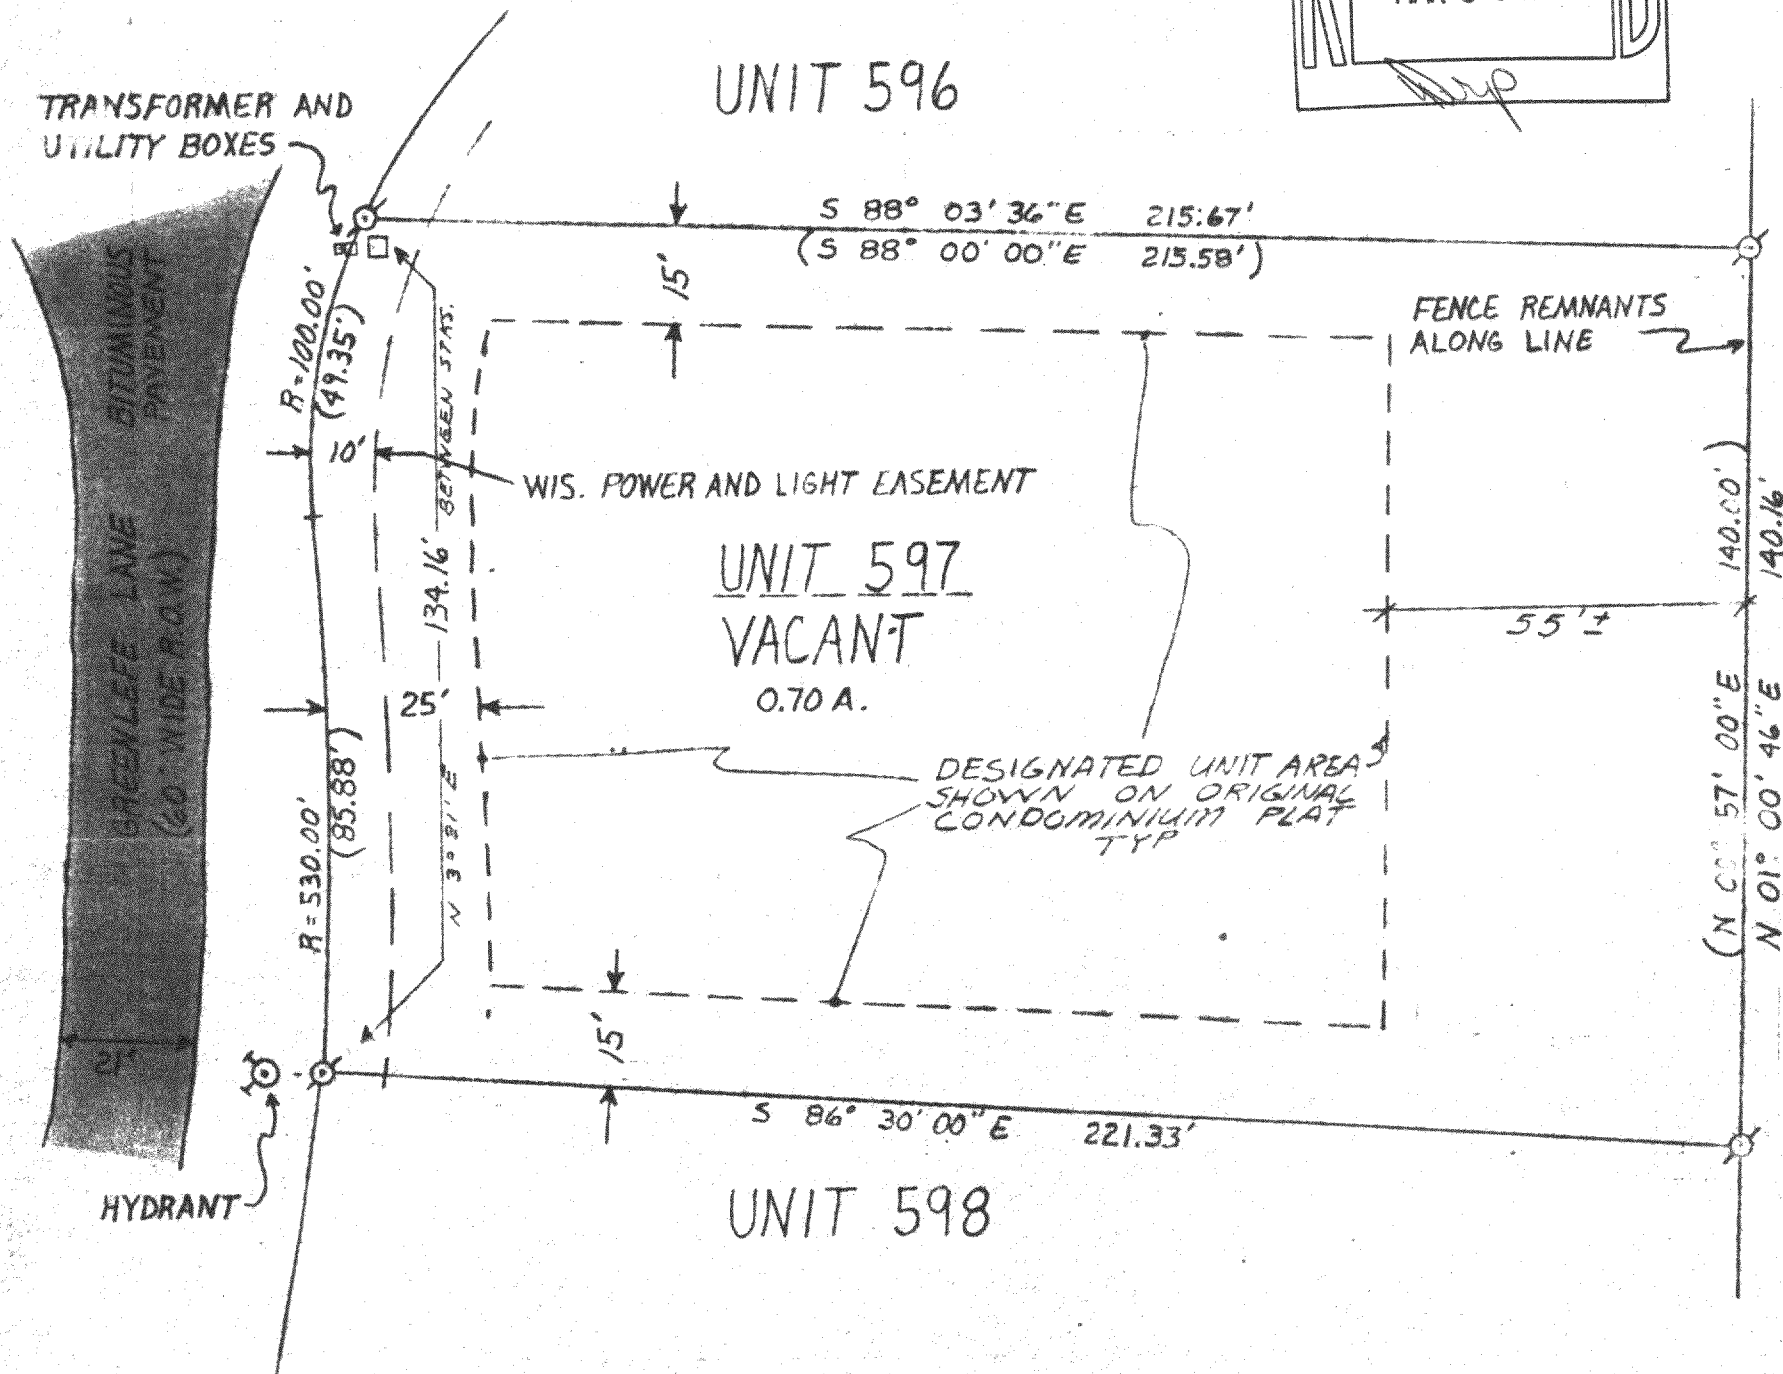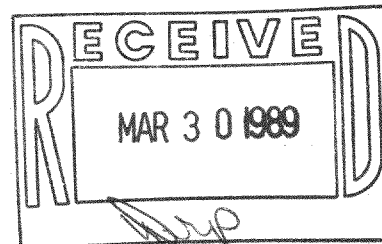

OUTLOT 75
ASSESSORS PLAT NO. 1 (AMENDED)

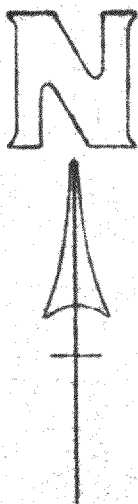

NOTE: SOUTH LINE UNIT 597
BEARING BASIS THIS PLAT
AS RECORDED S 86° 30' E

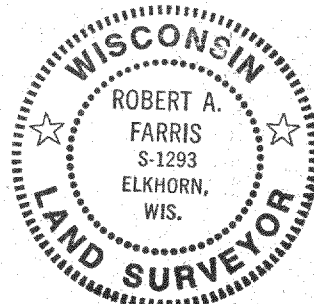

NOTE: COPIES OF THIS MAP TO WHICH THE FOLLOWING CERTIFICATE WILL APPLY ARE BLUE LINE PRINTS SHOWING SURVEYOR'S SEAL AND SIGNATURE IN BLACK INK. COPIES BY ANY OTHER MEANS MAY HAVE ALTERATIONS WHICH DO NOT REPRESENT THE SURVEYOR'S WORK PRODUCT.

I hereby certify that the above described property has been surveyed under my direction and that the above map is a true representation thereof and shows the size and location of the property, its exterior boundaries, the location of all visible structures and dimensions of all principal buildings thereon, boundary fences, apparent easements, roadways and visible encroachments, if any. This survey is made for the use of the present owners of the property, and also those who purchase, mortgage, or guarantee the title thereto within one year from the date hereof.

DATED: JAN 18, 1989

Robert A. Farris

PROJ. NO. 3159

5-937

SCDB13-597