


ENGINEERING, SURVEYING AND LAND PLANNING
715 W. WALWORTH ST. - P.O. BOX 487 - ELKHORN, WI 53121
OFFICE: 414/723-2000

RECEIVED
MAR 30 1989
PAGE OF *[Signature]*

This Drawing Revised This 30th Day of Jan. 1989 to show Additions/ Improvements Constructed Since the June 1980 Survey. The boundary lines were not remeasured in 1989.

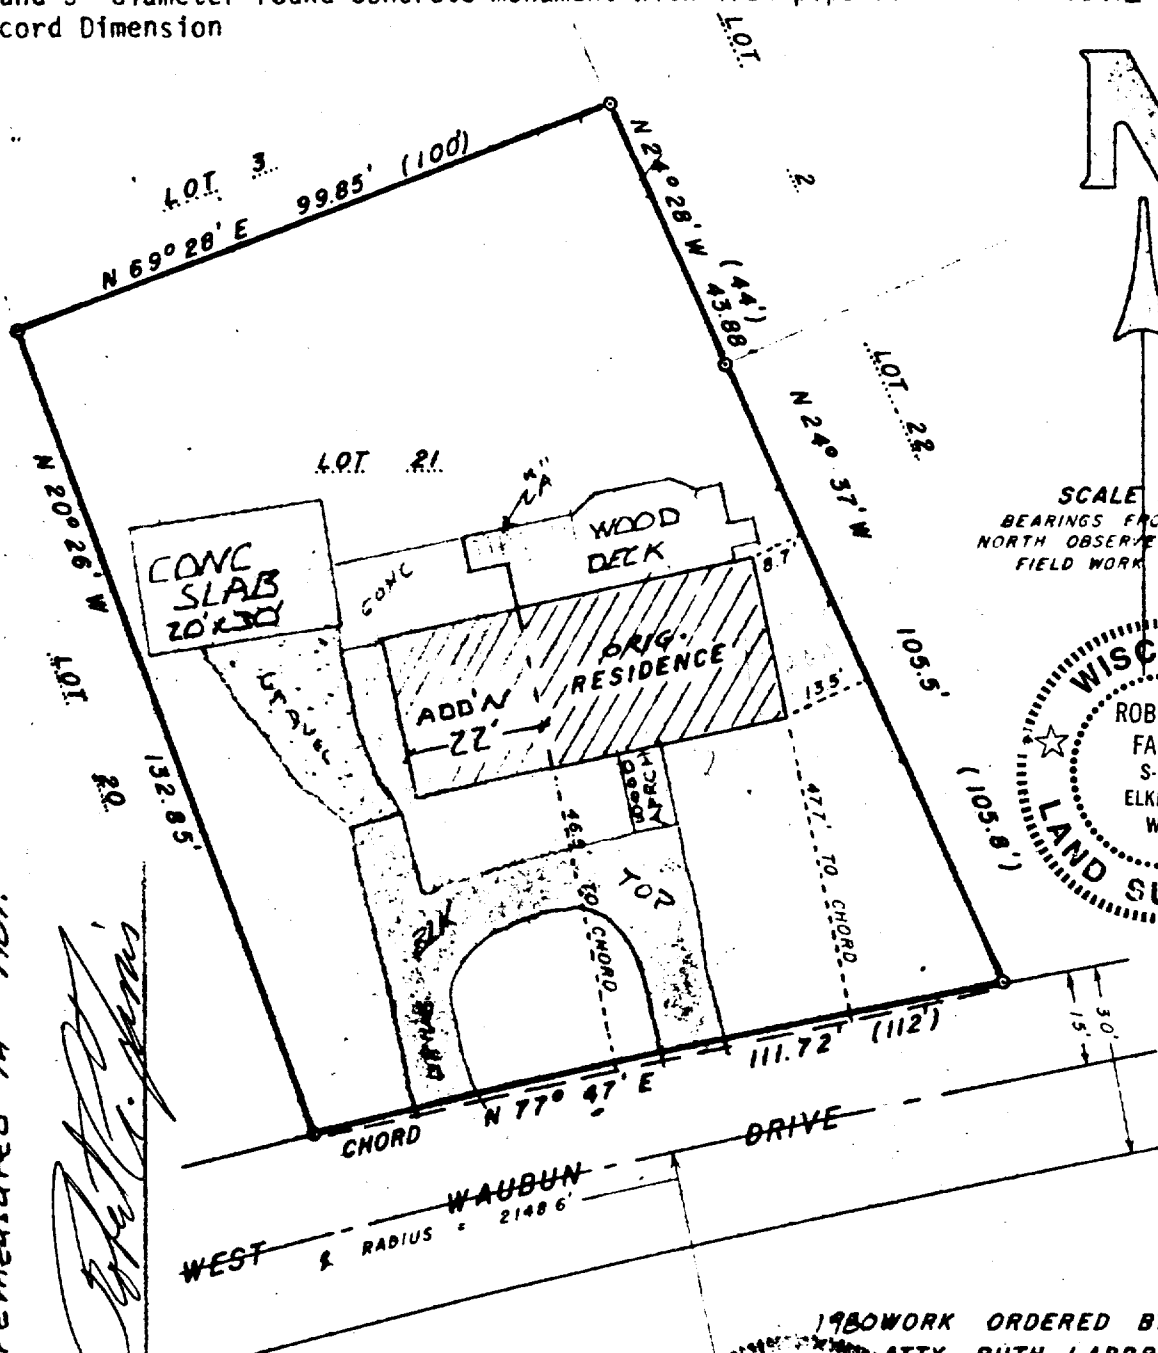

Dated this 16th day of June, 1980

Robert A. Farris

5-938

DRAWING NUMBER

1706

1980 WORK ORDERED BY:

ATTY. RUTH LAPPRE

1959 Improvements Added
ORDERED BY THE
RAILROAD AGENCY FOR
GEORGE HENNERLEY