



KOLB LAND CONSULTING, INC.

LAND SURVEYING • SUBDIVIDING • LAND PLANNING

929 WILLIAMS STREET

LAKE GENEVA, WISCONSIN 53147

414-248-3697

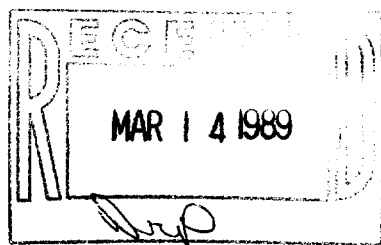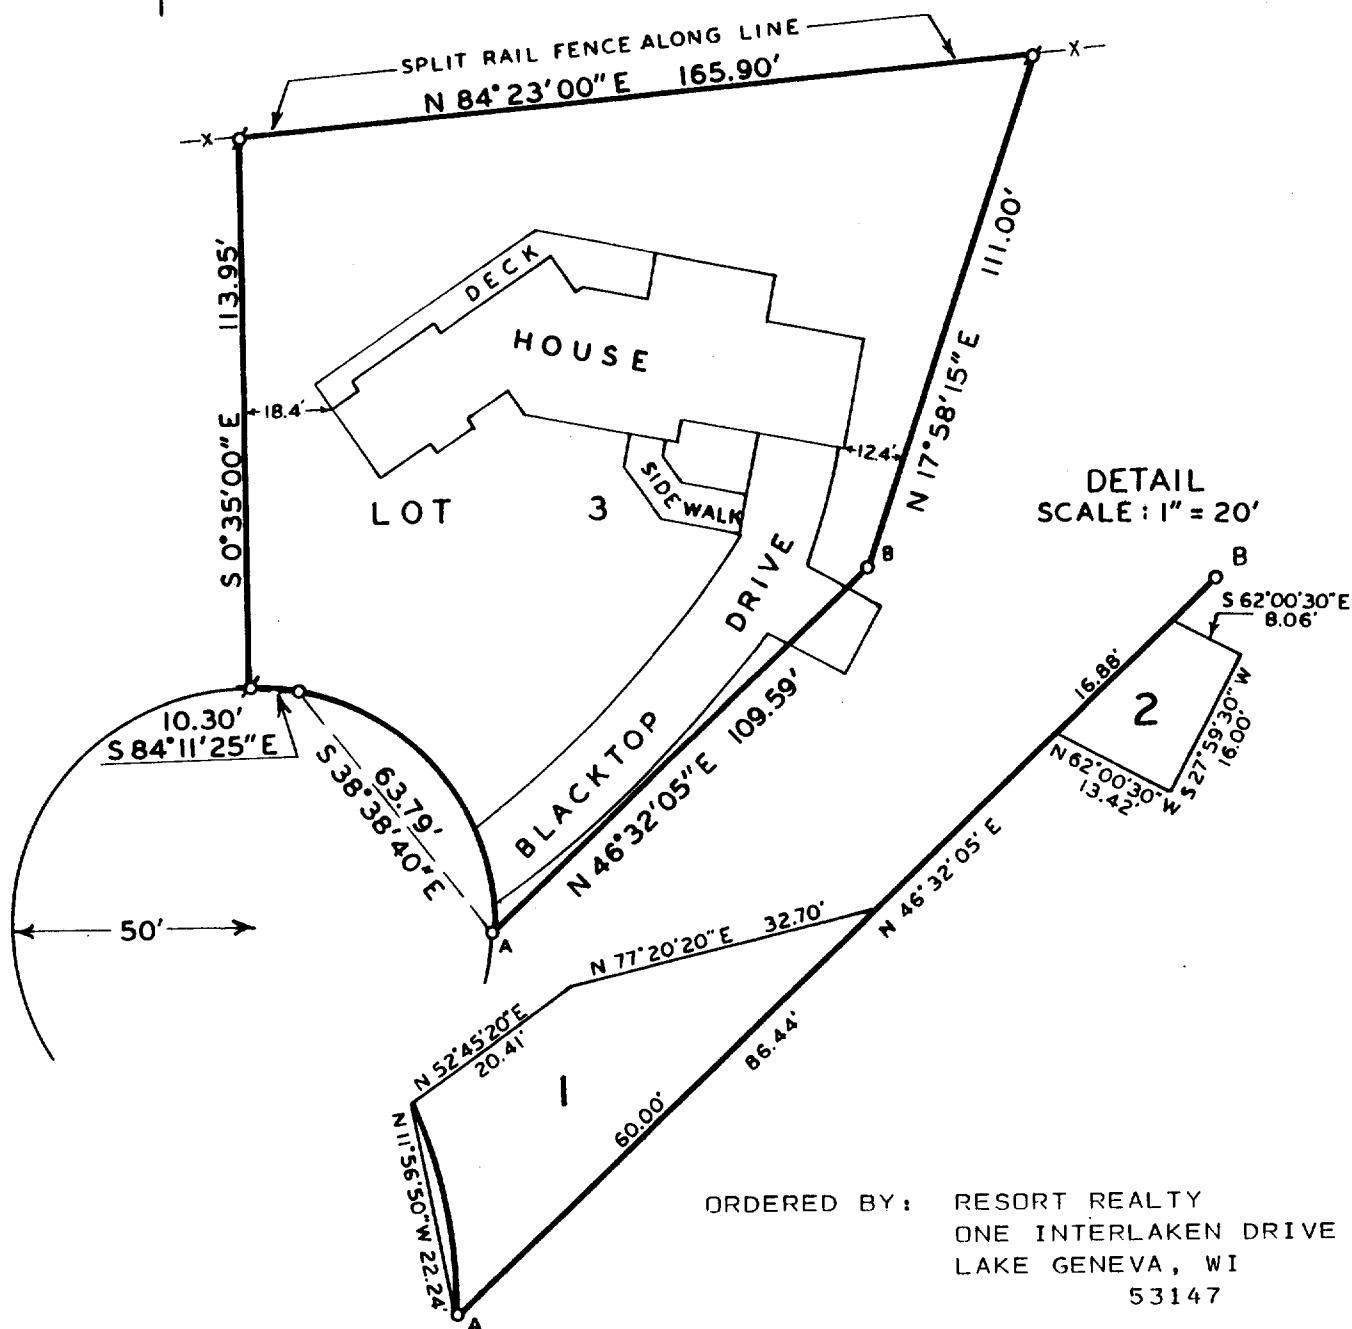

SCALE : 1" = 40'

LEGEND

- ⊕ - IRON PIPE FOUND
○ - IRON PIPE SET

I HEREBY CERTIFY THAT I HAVE SURVEYED THE ABOVE DESCRIBED PROPERTY AND THAT THE ABOVE MAP IS A TRUE REPRESENTATION THEREOF AND SHOWS THE SIZE AND LOCATION OF THE PROPERTY, ITS EXTERIOR BOUNDARIES, THE LOCATION OF ALL VISIBLE STRUCTURES AND DIMENSIONS OF ALL PRINCIPAL BUILDINGS THEREON, BOUNDARY FENCES, APPARENT EASEMENTS, ROADWAYS AND VISIBLE ENCROACHMENTS, IF ANY, TO THE BEST OF MY KNOWLEDGE AND BELIEF.

THIS SURVEY IS MADE FOR THE USE OF THE PRESENT OWNERS OF THE PROPERTY, AND ALSO THOSE WHO PURCHASE, MORTGAGE, OR GUARANTEE THE TITLE THERETO WITHIN ONE (1) YEAR FROM DATE HEREOF.

SURVEY NOT VALID UNLESS SURVEYOR'S SIGNATURE IS IN RED.

HAROLD H. KOLB

WISCONSIN REGISTERED LAND SURVEYOR, S-187

DATE APRIL 27, 1988

REVISED _____

REVISED _____

5-946

KOLB LAND CONSULTING, INC.
 LAND SURVEYING • SUBDIVIDING • LAND PLANNING

929 WILLIAMS STREET

LAKE GENEVA, WISCONSIN 53147

414-248-3697

EASEMENTS

1. FOR LOT 4 ACROSS LOT 3:
 BEGINNING AT THE SOUTHEAST CORNER OF SAID LOT 3; THENCE 22.42 FEET
 ALONG THE ARC OF A 50.00 FOOT RADIUS CURVE TO THE LEFT, THE CHORD
 BEARING N 11°56'50" W 22.24 FEET; THENCE N 52°45'20" E 20.41 FEET;
 THENCE N 77°20'20" E 32.70 FEET; THENCE S 46°32'05" W 60.00 FEET TO
 THE PLACE OF BEGINNING.
2. FOR LOT 3 ACROSS LOT 4:
 COMMENCING AT THE SOUTHEAST CORNER OF SAID LOT 3; THENCE N 46°32'05" E
 86.44 FEET TO THE PLACE OF BEGINNING; THENCE CONTINUE N 46°32'05" E
 16.88 FEET; THENCE S 62°00'30" E 8.06 FEET; THENCE S 27°59'30" W
 16.00 FEET; THENCE N 62°00'30" W 13.42 FEET TO THE PLACE OF BEGINNING.

HAROLD H. KOLB

WISCONSIN REGISTERED LAND SURVEYOR, S-187

DATE APRIL 27, 1988

REVISED

REVISED