



WALWORTH COUNTY
SURVEYING & MAPPING
LAKE GENEVA, WISCONSIN

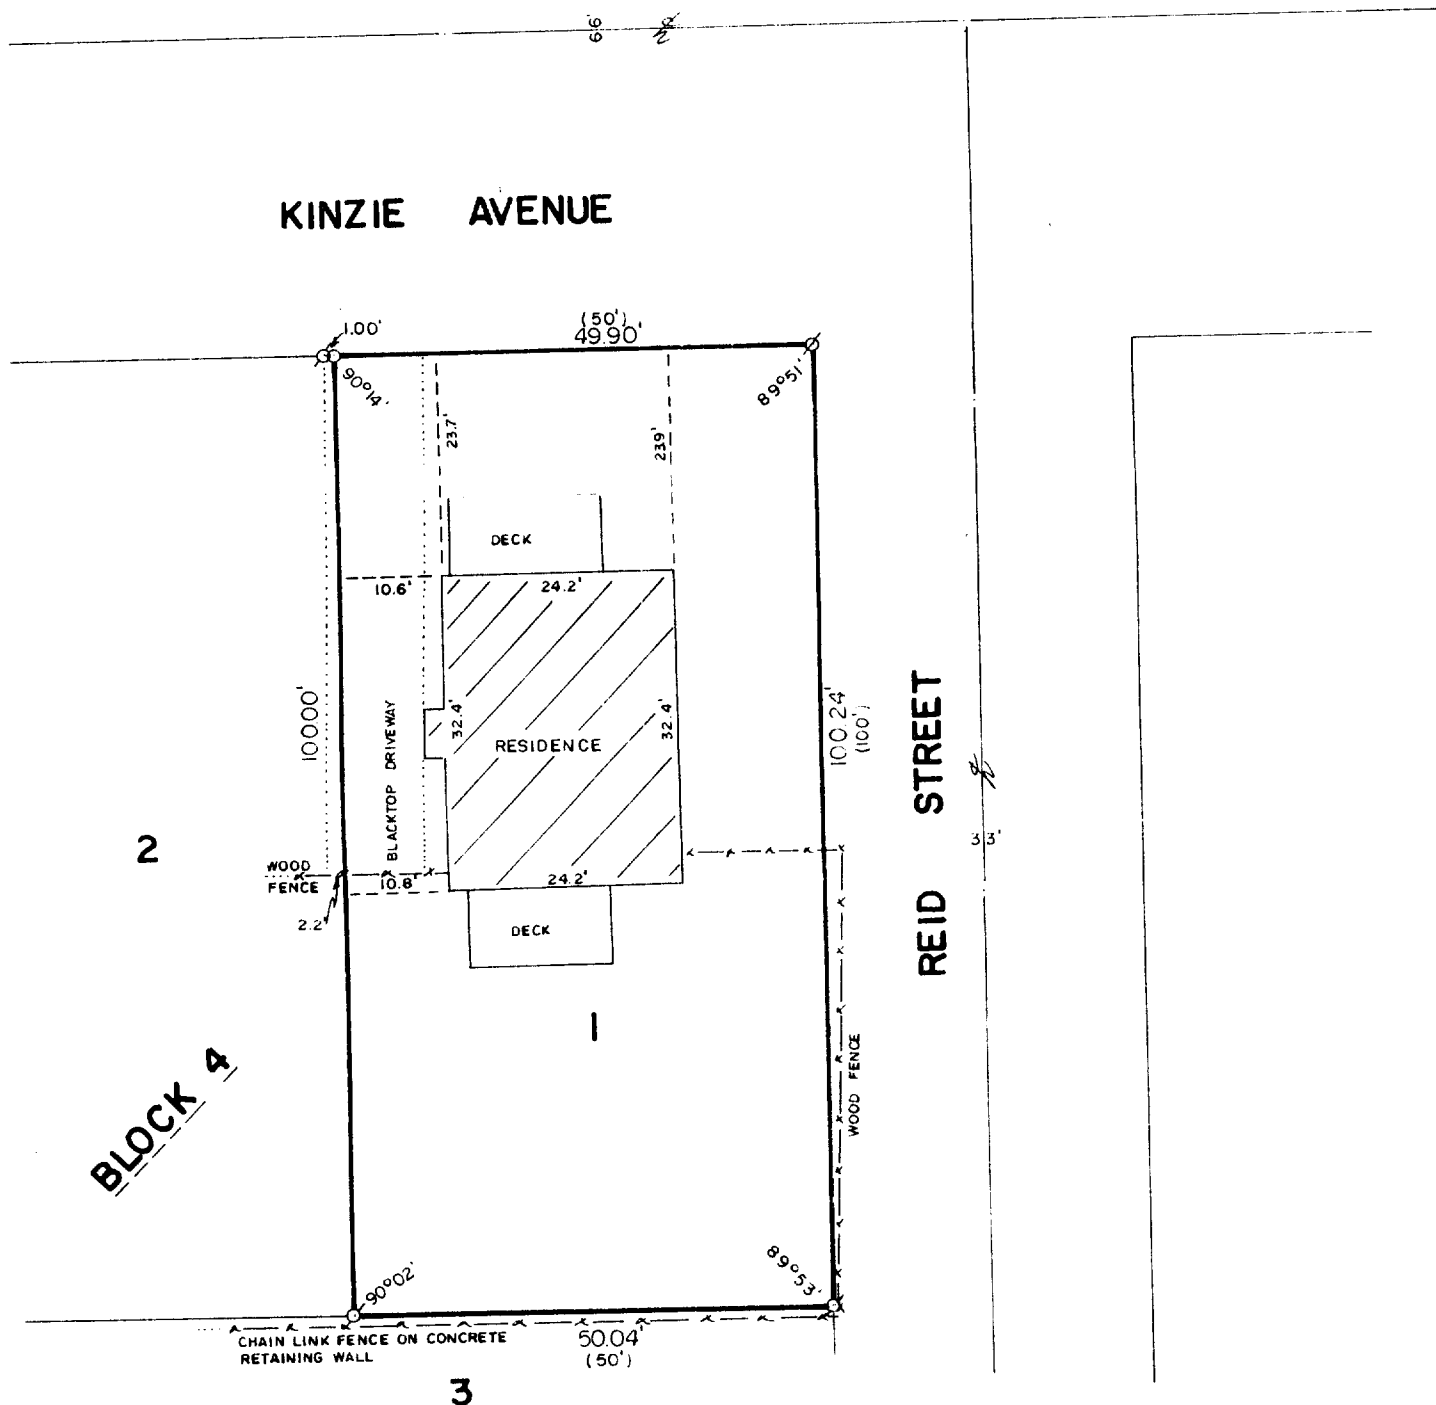

STATE OF WISCONSIN

TOP 1, BLOCK 4 OF S.W. REID'S ADDITION TO
REID'S SUBDIVISION IN THE VILLAGE OF
PONTIAC-WILSON, LAKE GENEVA, WISCONSIN
WISCONSIN

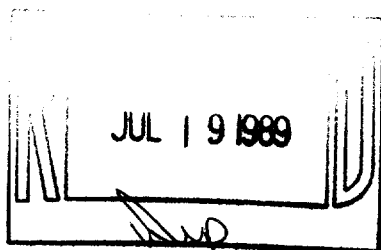

WALWORTH COUNTY
RECORDING OFFICE
LAKE GENEVA, WISCONSIN
JUL 19 1989



SCALE: 1" = 20'

Ø - IRON PIER FOUND
Ø - IRON ROD FOUND
○ - IRON ROD PLACED
(HARD COPY)

I HEREBY CERTIFY THAT I HAVE SURVEYED THE ABOVE DESCRIBED PROPERTY AND THAT THE ABOVE
MAP IS A TRUE REPRESENTATION THEREOF AND SHOWS THE SIZE AND LOCATION OF THE PROPERTY,
ITS EXTERIOR BOUNDARIES, THE LOCATION OF ALL VISIBLE STRUCTURES AND DIMENSIONS OF ALL
PRINCIPAL BUILDINGS THEREON, BOUNDARY FENCES, APPARENT EASEMENTS AND ROADWAYS AND
VISIBLE ENCROACHMENTS, IF ANY.

THIS SURVEY IS MADE FOR THE EXCLUSIVE USE OF THE PRESENT OWNERS OF THE PROPERTY, AND
ALSO THOSE WHO PURCHASE, MORTGAGE, OR GUARANTEE THE TITLE THERETO WITHIN ONE (1) YEAR
FROM DATE HEREOF.

Robert M. Baerenwald
ROBERT M. BAERENWALD
WISCONSIN REGISTERED LAND SURVEYOR, S-1508

DATE *April 12, 1989* JOB NO. *11*

NOTE: THIS IS NOT A CERTIFIED COPY UNLESS SEALED.

SRA-21

5-971