


WALWORTH COUNTY
SURVEYING & MAPPING
LAKE GENEVA, WISCONSIN

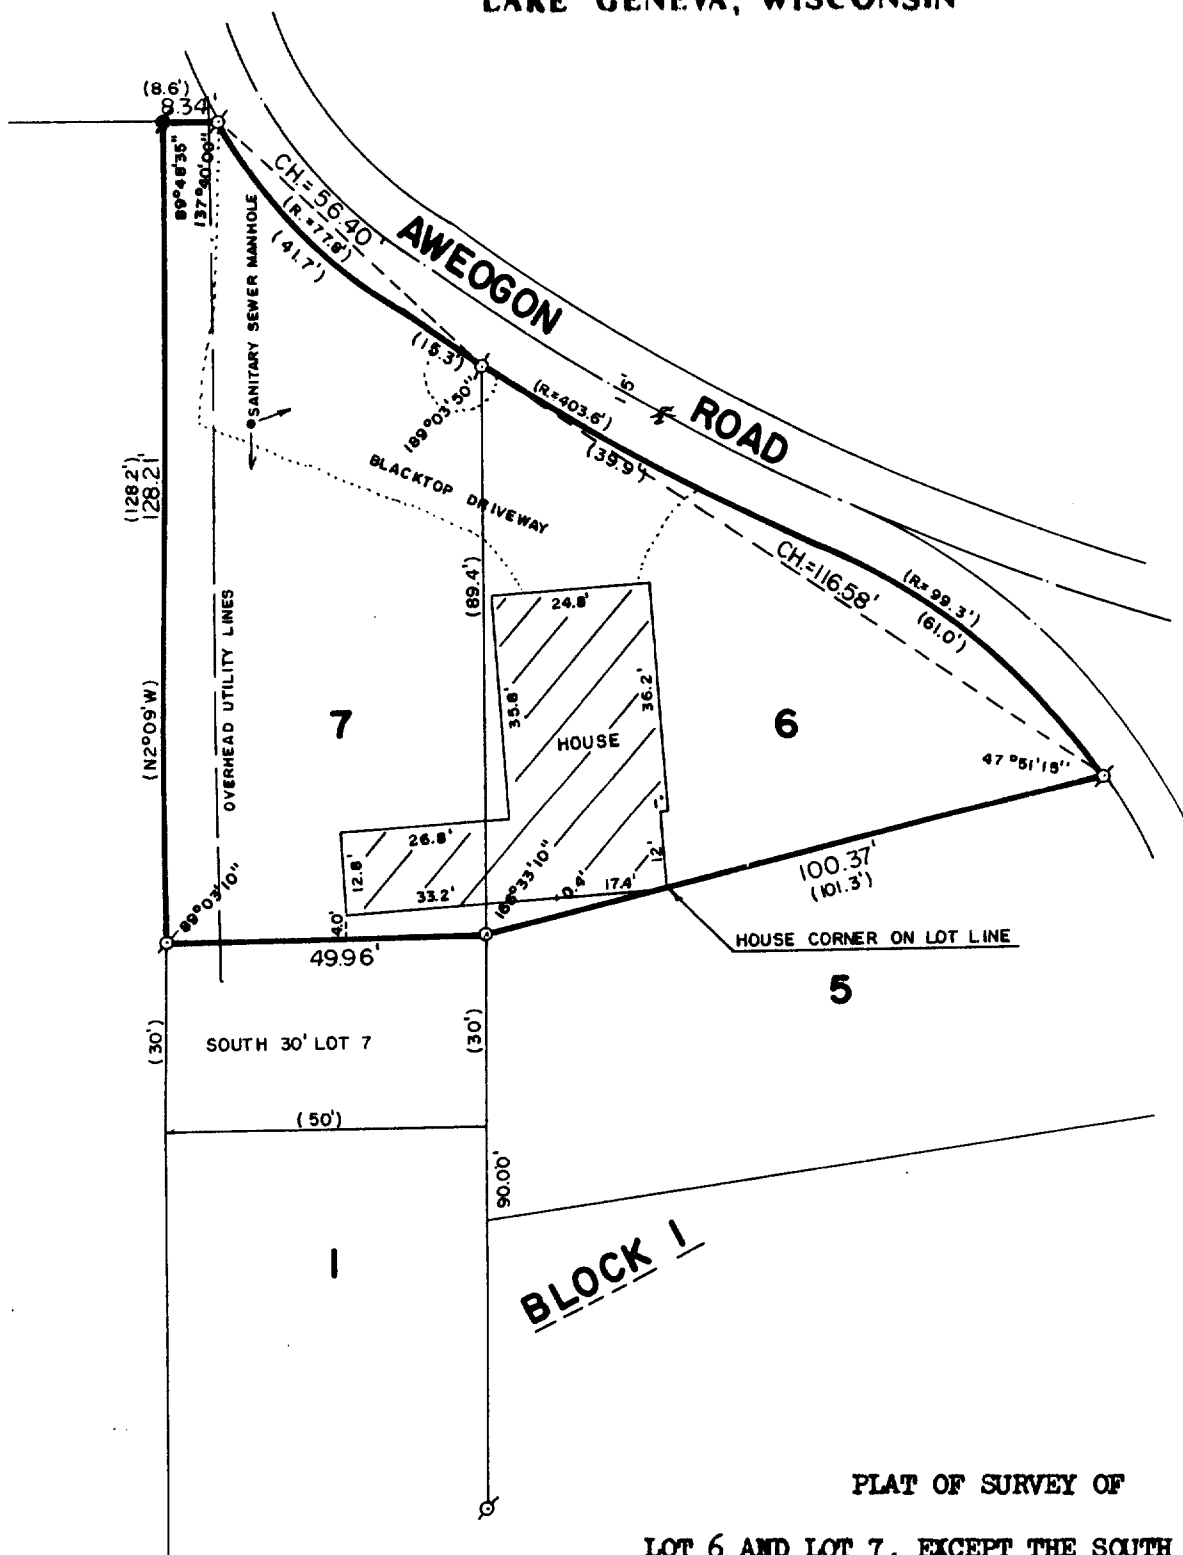


BLOCK 1

PLAT OF SURVEY OF

LOT 6 AND LOT 7, EXCEPT THE SOUTH 30 FEET
THEREOF, BLOCK 1 OF INDIAN HILLS, A SUBDIVISION
LOCATED IN THE VILLAGE OF FONTANA-ON-GENEVA
LAKE, WALWORTH COUNTY, WISCONSIN.

ORDERED BY: DONALD KUNTZ
900 EAST NW HWY
MOUNT PROSPECT, ILLINOIS
60056

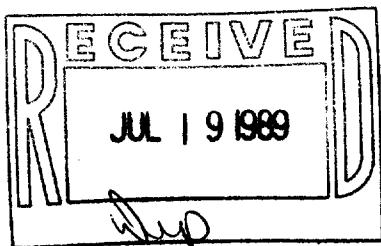

SCALE: 1"=30'

- ⊕ - IRON PIPE FOUND
- ⊙ - CONCRETE MONUMENT FOUND
- - IRON PIPE PLACED
- () - RECORDED AS

I HEREBY CERTIFY THAT I HAVE SURVEYED THE ABOVE DESCRIBED PROPERTY AND THAT THE ABOVE
MAP IS A TRUE REPRESENTATION THEREOF AND SHOWS THE SIZE AND LOCATION OF THE PROPERTY,
ITS EXTERIOR BOUNDARIES, THE LOCATION OF ALL VISIBLE STRUCTURES AND DIMENSIONS OF ALL
PRINCIPAL BUILDINGS THEREON, BOUNDARY FENCES, APPARENT EASEMENTS AND ROADWAYS AND
VISIBLE ENCROACHMENTS, IF ANY.

THIS SURVEY IS MADE FOR THE EXCLUSIVE USE OF THE PRESENT OWNERS OF THE PROPERTY, AND
ALSO THOSE WHO PURCHASE, MORTGAGE, OR GUARANTEE THE TITLE THERETO WITHIN ONE (1) YEAR
FROM DATE HEREOF.

Robert M. Baerenwald
ROBERT M. BAERENWALD
WISCONSIN REGISTERED LAND SURVEYOR, S-1508

DATE *JUL 14 1989* JOB NO. 2026

NOTE: THIS IS NOT A CERTIFIED COPY UNLESS SEALED.