

Farris, Hansen & Associates, Inc.

TEL. 414-723-2098



LOCATION: UNIT 55 ABBEY SPRINGS CONDOMINIUM
VILLAGE OF FONTANA, WALWORTH COUNTY, WI.

WORK ORDERED BY: *ATTY. JOSEPH LARAIA*
FOR: *ROBERT PASCENTE & GLEN SOMERS*

MAP SCALE IN FEET

MAP LEGEND

- - IRON PIPE STAKE FOUND
- IRON PIPE STAKE SET
- IRON ROD STAKE FOUND
- IRON ROD STAKE SET
- CONCRETE MONUMENT FOUND
-) - RECORD DIMENSION

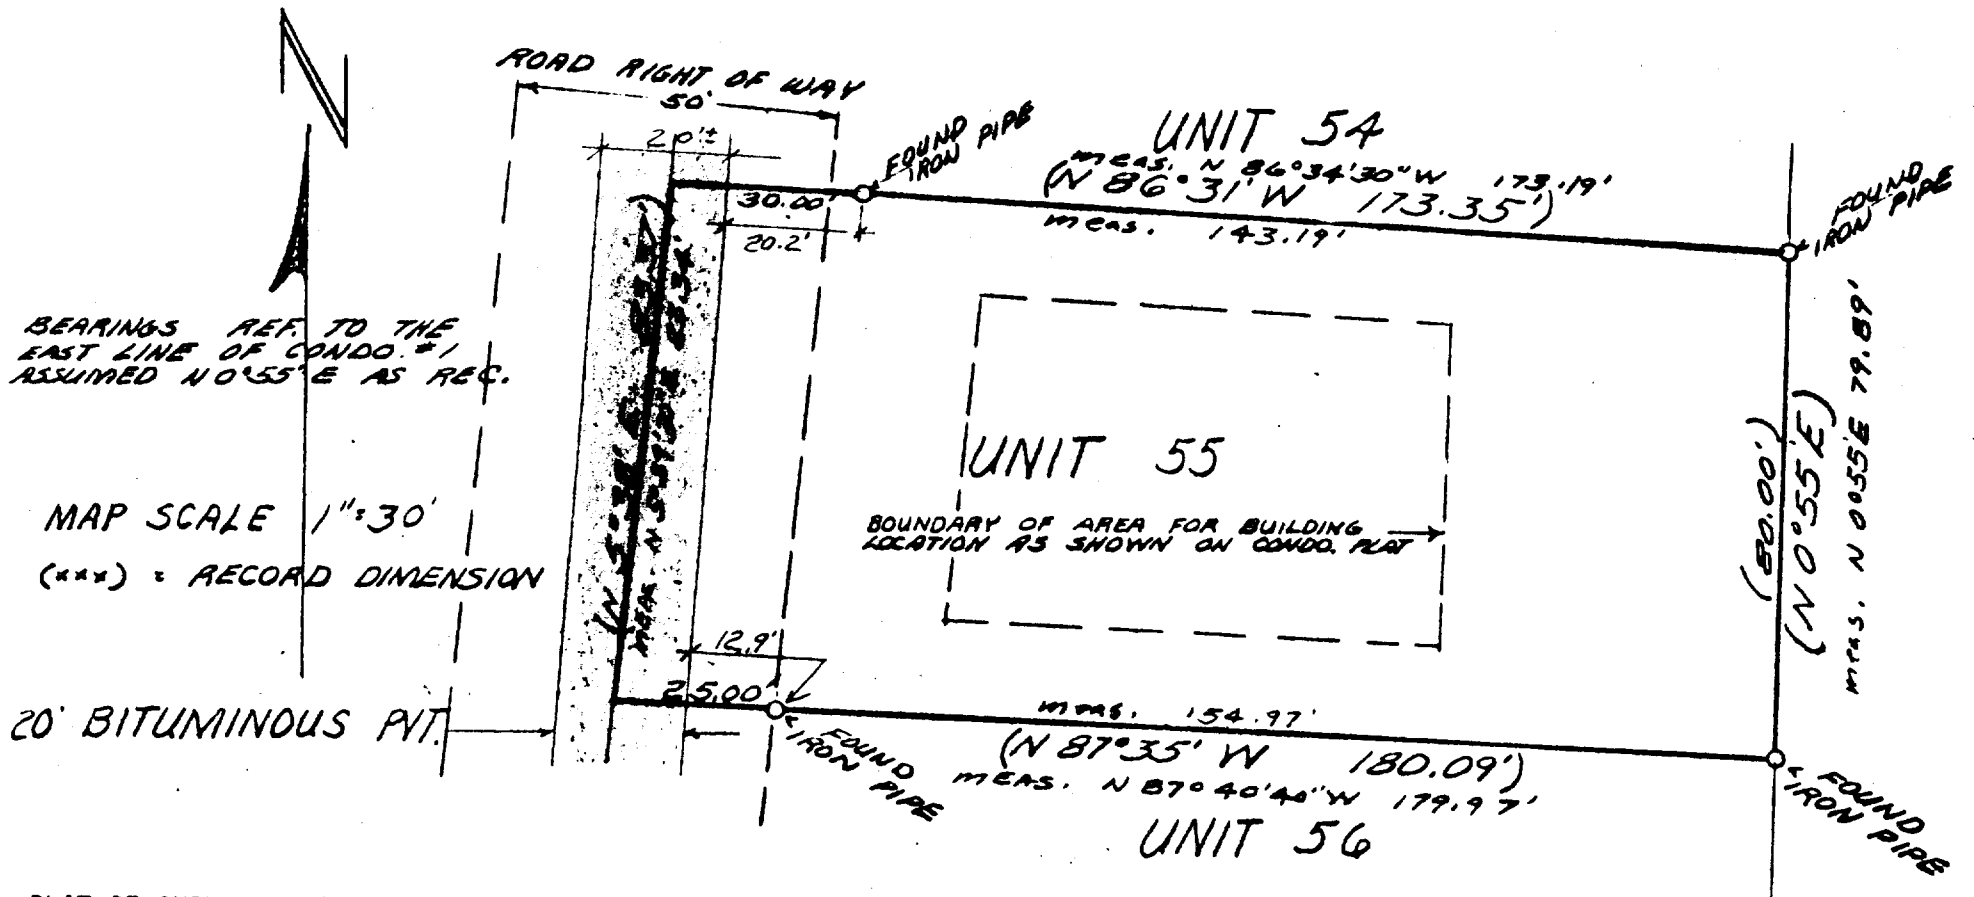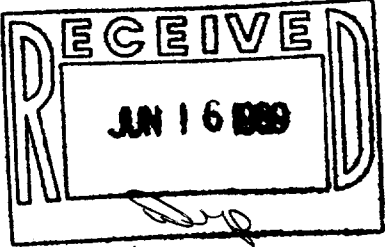

PLAT OF SURVEY OF UNIT 55 OF ABBEY SPRINGS CONDOMINIUM NO. 1
LOCATED IN THE SOUTHEAST 1/4 OF SECTION 13, TOWN 1 NORTH, RANGE
16 EAST, VILLAGE OF FONTANA - ON - GENEVA LAKE, WALWORTH COUNTY, WIS.

NOTE: COPIES OF THIS MAP TO WHICH THE FOLLOWING CERTIFICATE WILL APPLY ARE BLUE LINE PRINTS SHOWING SURVEYOR'S SEAL AND SIGNATURE IN BLACK INK. COPIES BY ANY OTHER MEANS MAY HAVE ALTERATIONS WHICH DO NOT REPRESENT THE SURVEYOR'S WORK PRODUCT.

I HEREBY CERTIFY: that I have surveyed the above described property according to the official records and that this PLAT OF SURVEY is a true and accurate representation of the unit boundary lines and of the existing roadway pavement to the best of my professional knowledge and belief.

DATED : May 23, 1989

A circular seal for a Wisconsin Land Surveyor. The outer ring contains the text "WISCONSIN" at the top and "LAND SURVEYOR" at the bottom, separated by two five-pointed stars. The center of the seal contains the text "ROBERT A. FARRIS", "S-1293", "ELKHORN,", and "WIS." in a stacked format. A horizontal line is drawn across the bottom of the seal, passing through the word "WIS." and the "LAND SURVEYOR" text.

PROJ. NO. 1943 Recert.

5-979