

Farris, Hansen & Associates, Inc.

7 RIDGEWAY COURT, P.O. BOX 437, ELKHORN, WISCONSIN

TEL. 414-723-2098


LOCATION: UNIT 36 ABBEY SPRINGS
CONDOMINIUM NO. 1
IN S. 1/2 SEC. 13-1-16 FONTANA, WAL. CO., WI

WORK ORDERED BY: KEEFE REAL ESTATE
MARY McDONALD


- MAP LEGEND
- IRON PIPE STAKE FOUND
 - IRON PIPE STAKE SET
 - IRON ROD STAKE FOUND
 - IRON ROD STAKE SET
 - CONCRETE MONUMENT FOUND
 - (XXXXX) RECORD DIMENSION
 - xxxx = Measured Dimension



—PLAT OF SURVEY—

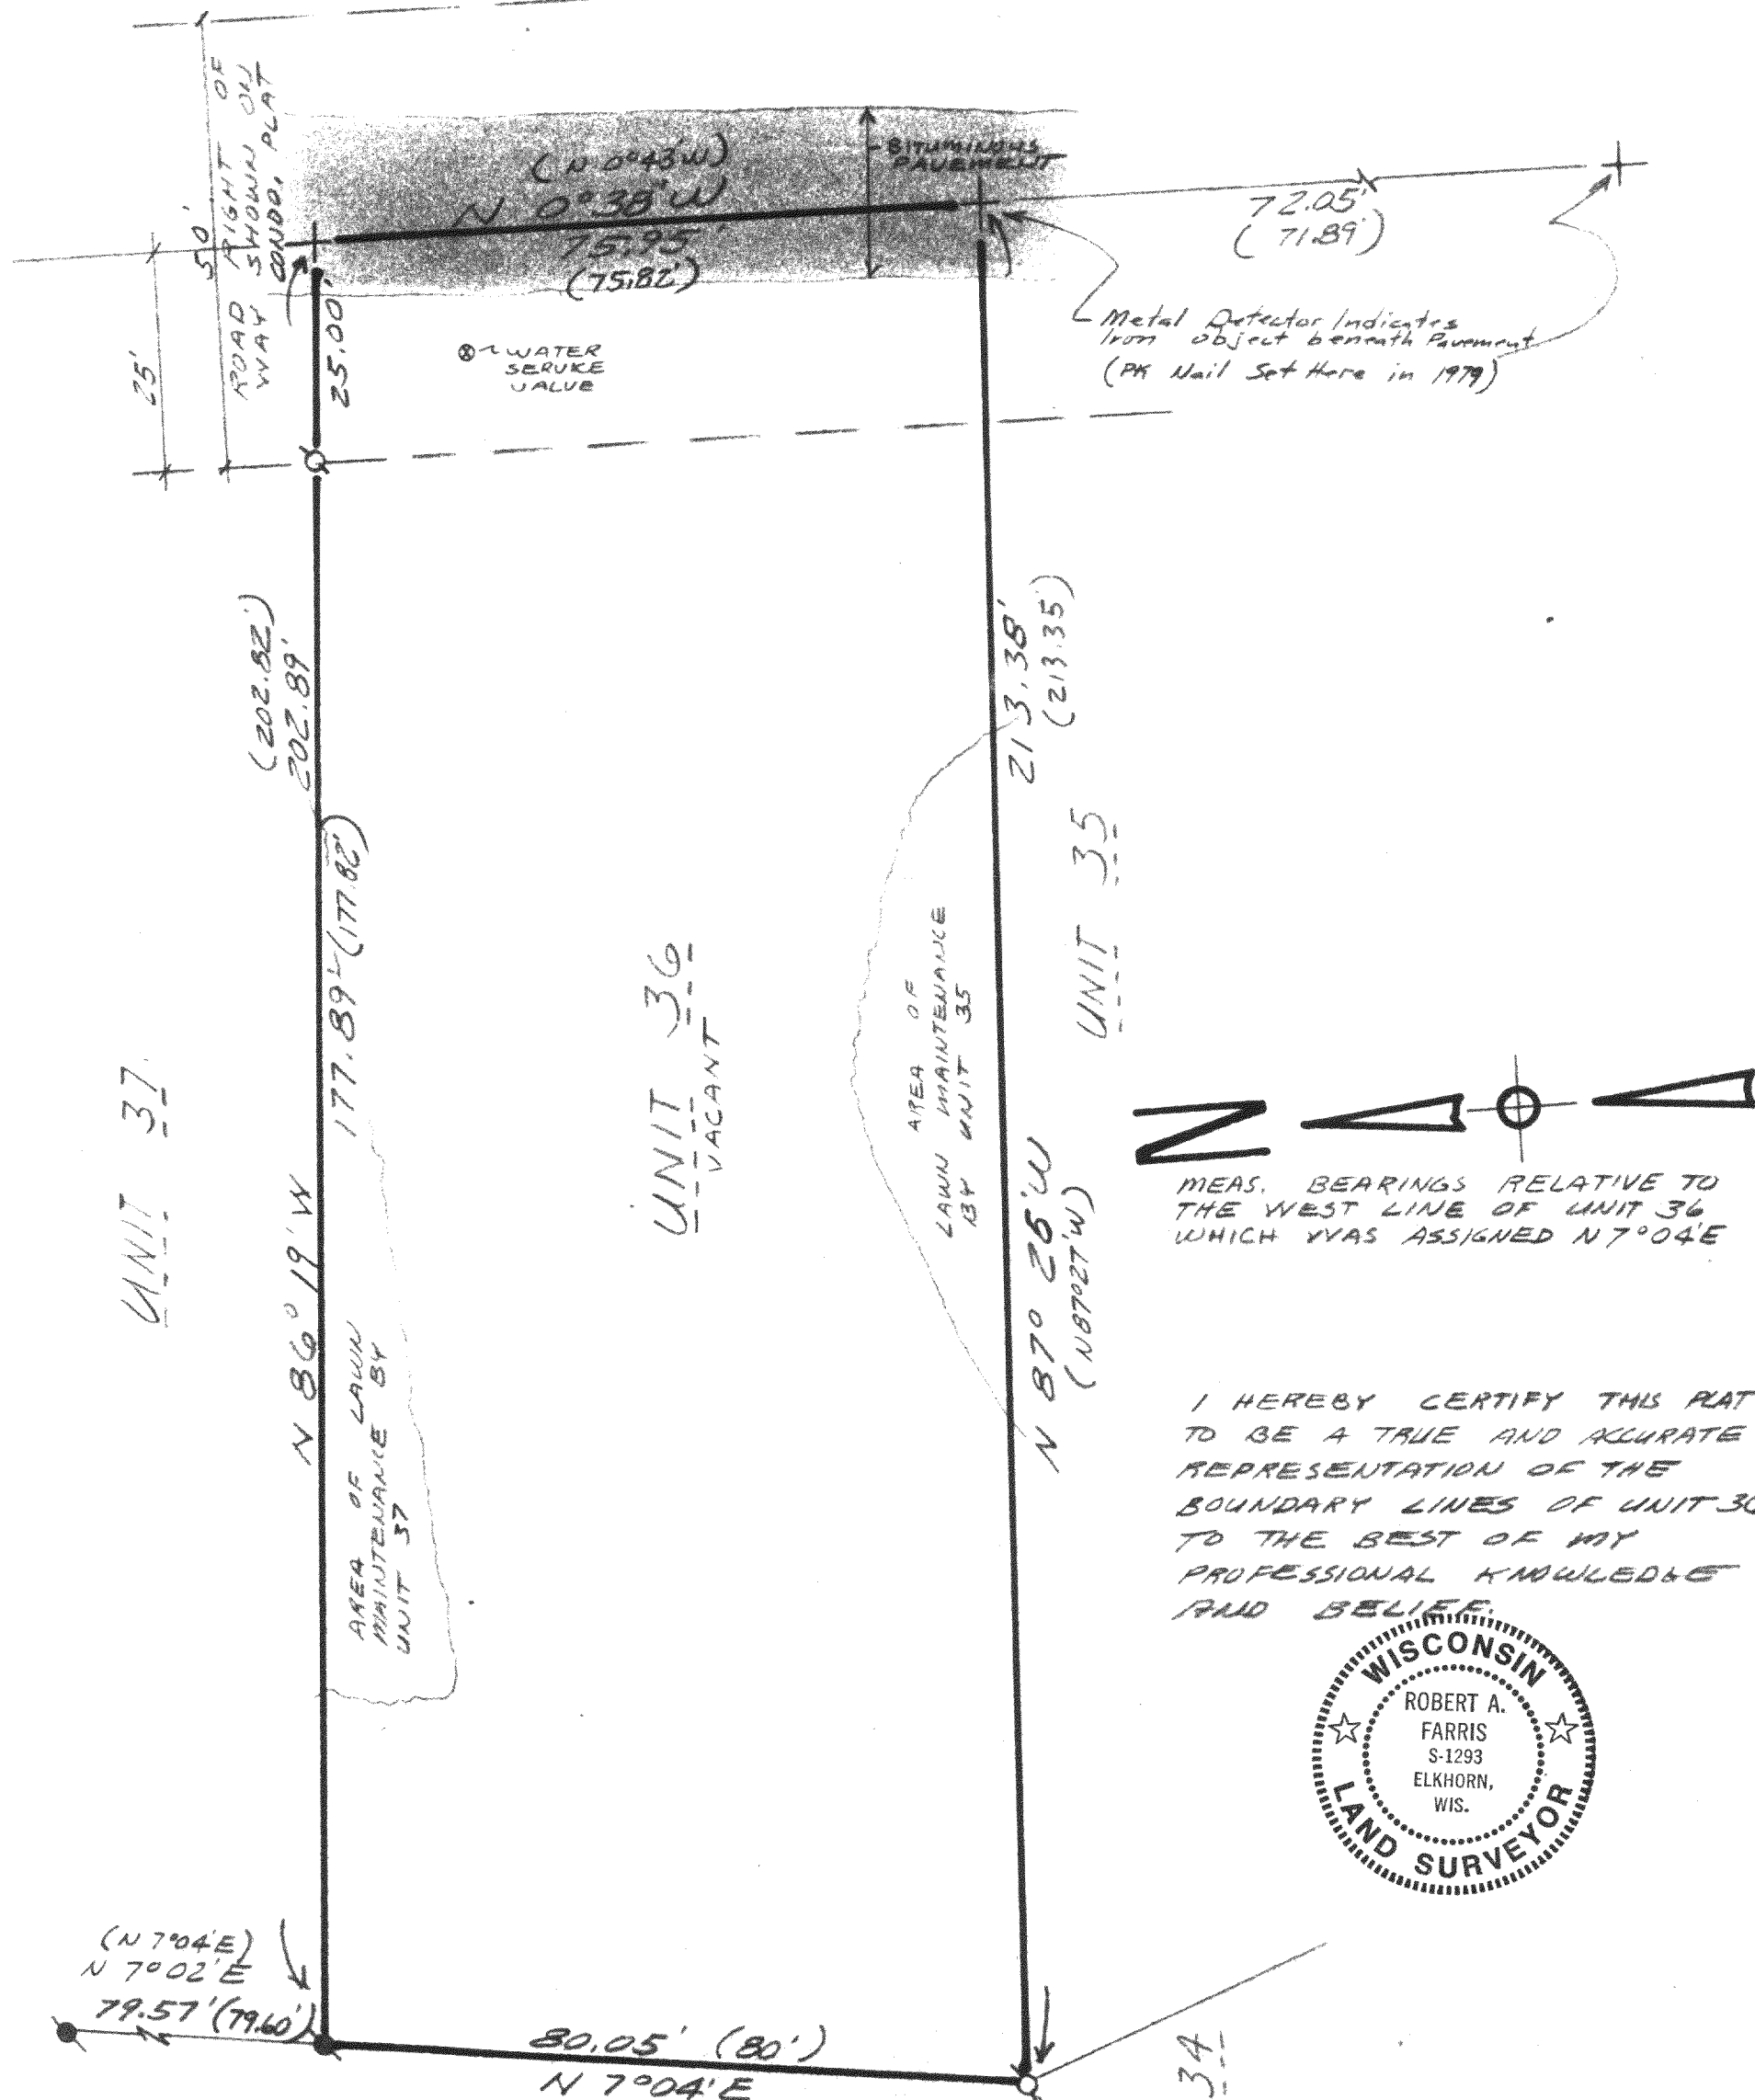

I HEREBY CERTIFY THIS PLAT
TO BE A TRUE AND ACCURATE
REPRESENTATION OF THE
BOUNDARY LINES OF UNIT 36
TO THE BEST OF MY
PROFESSIONAL KNOWLEDGE
AND BELIEF.

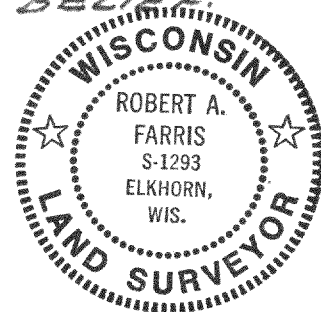

SCDB-36

DATED :

4/28/89

Robert A. Farris

PROJ. NO.

3199