



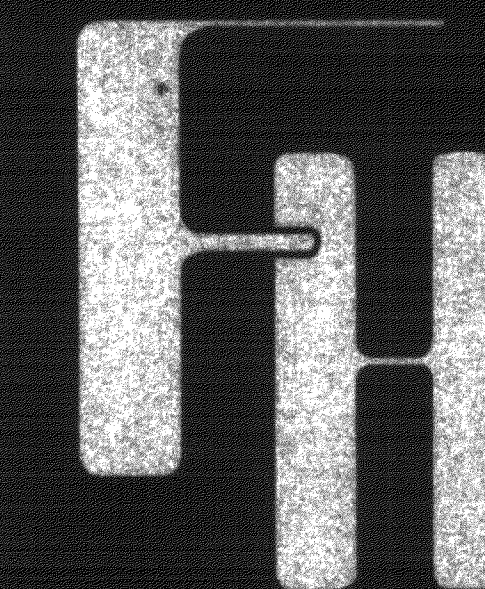


FARRIS, HANSEN & ASSOCIATES, INC.
Engineering, Architecture, Surveying
7 Ridgway Court, P.O. Box 437
ELKHORN, WISCONSIN 53121
Office: (414) 723-2000
Fax: (414) 723-8888

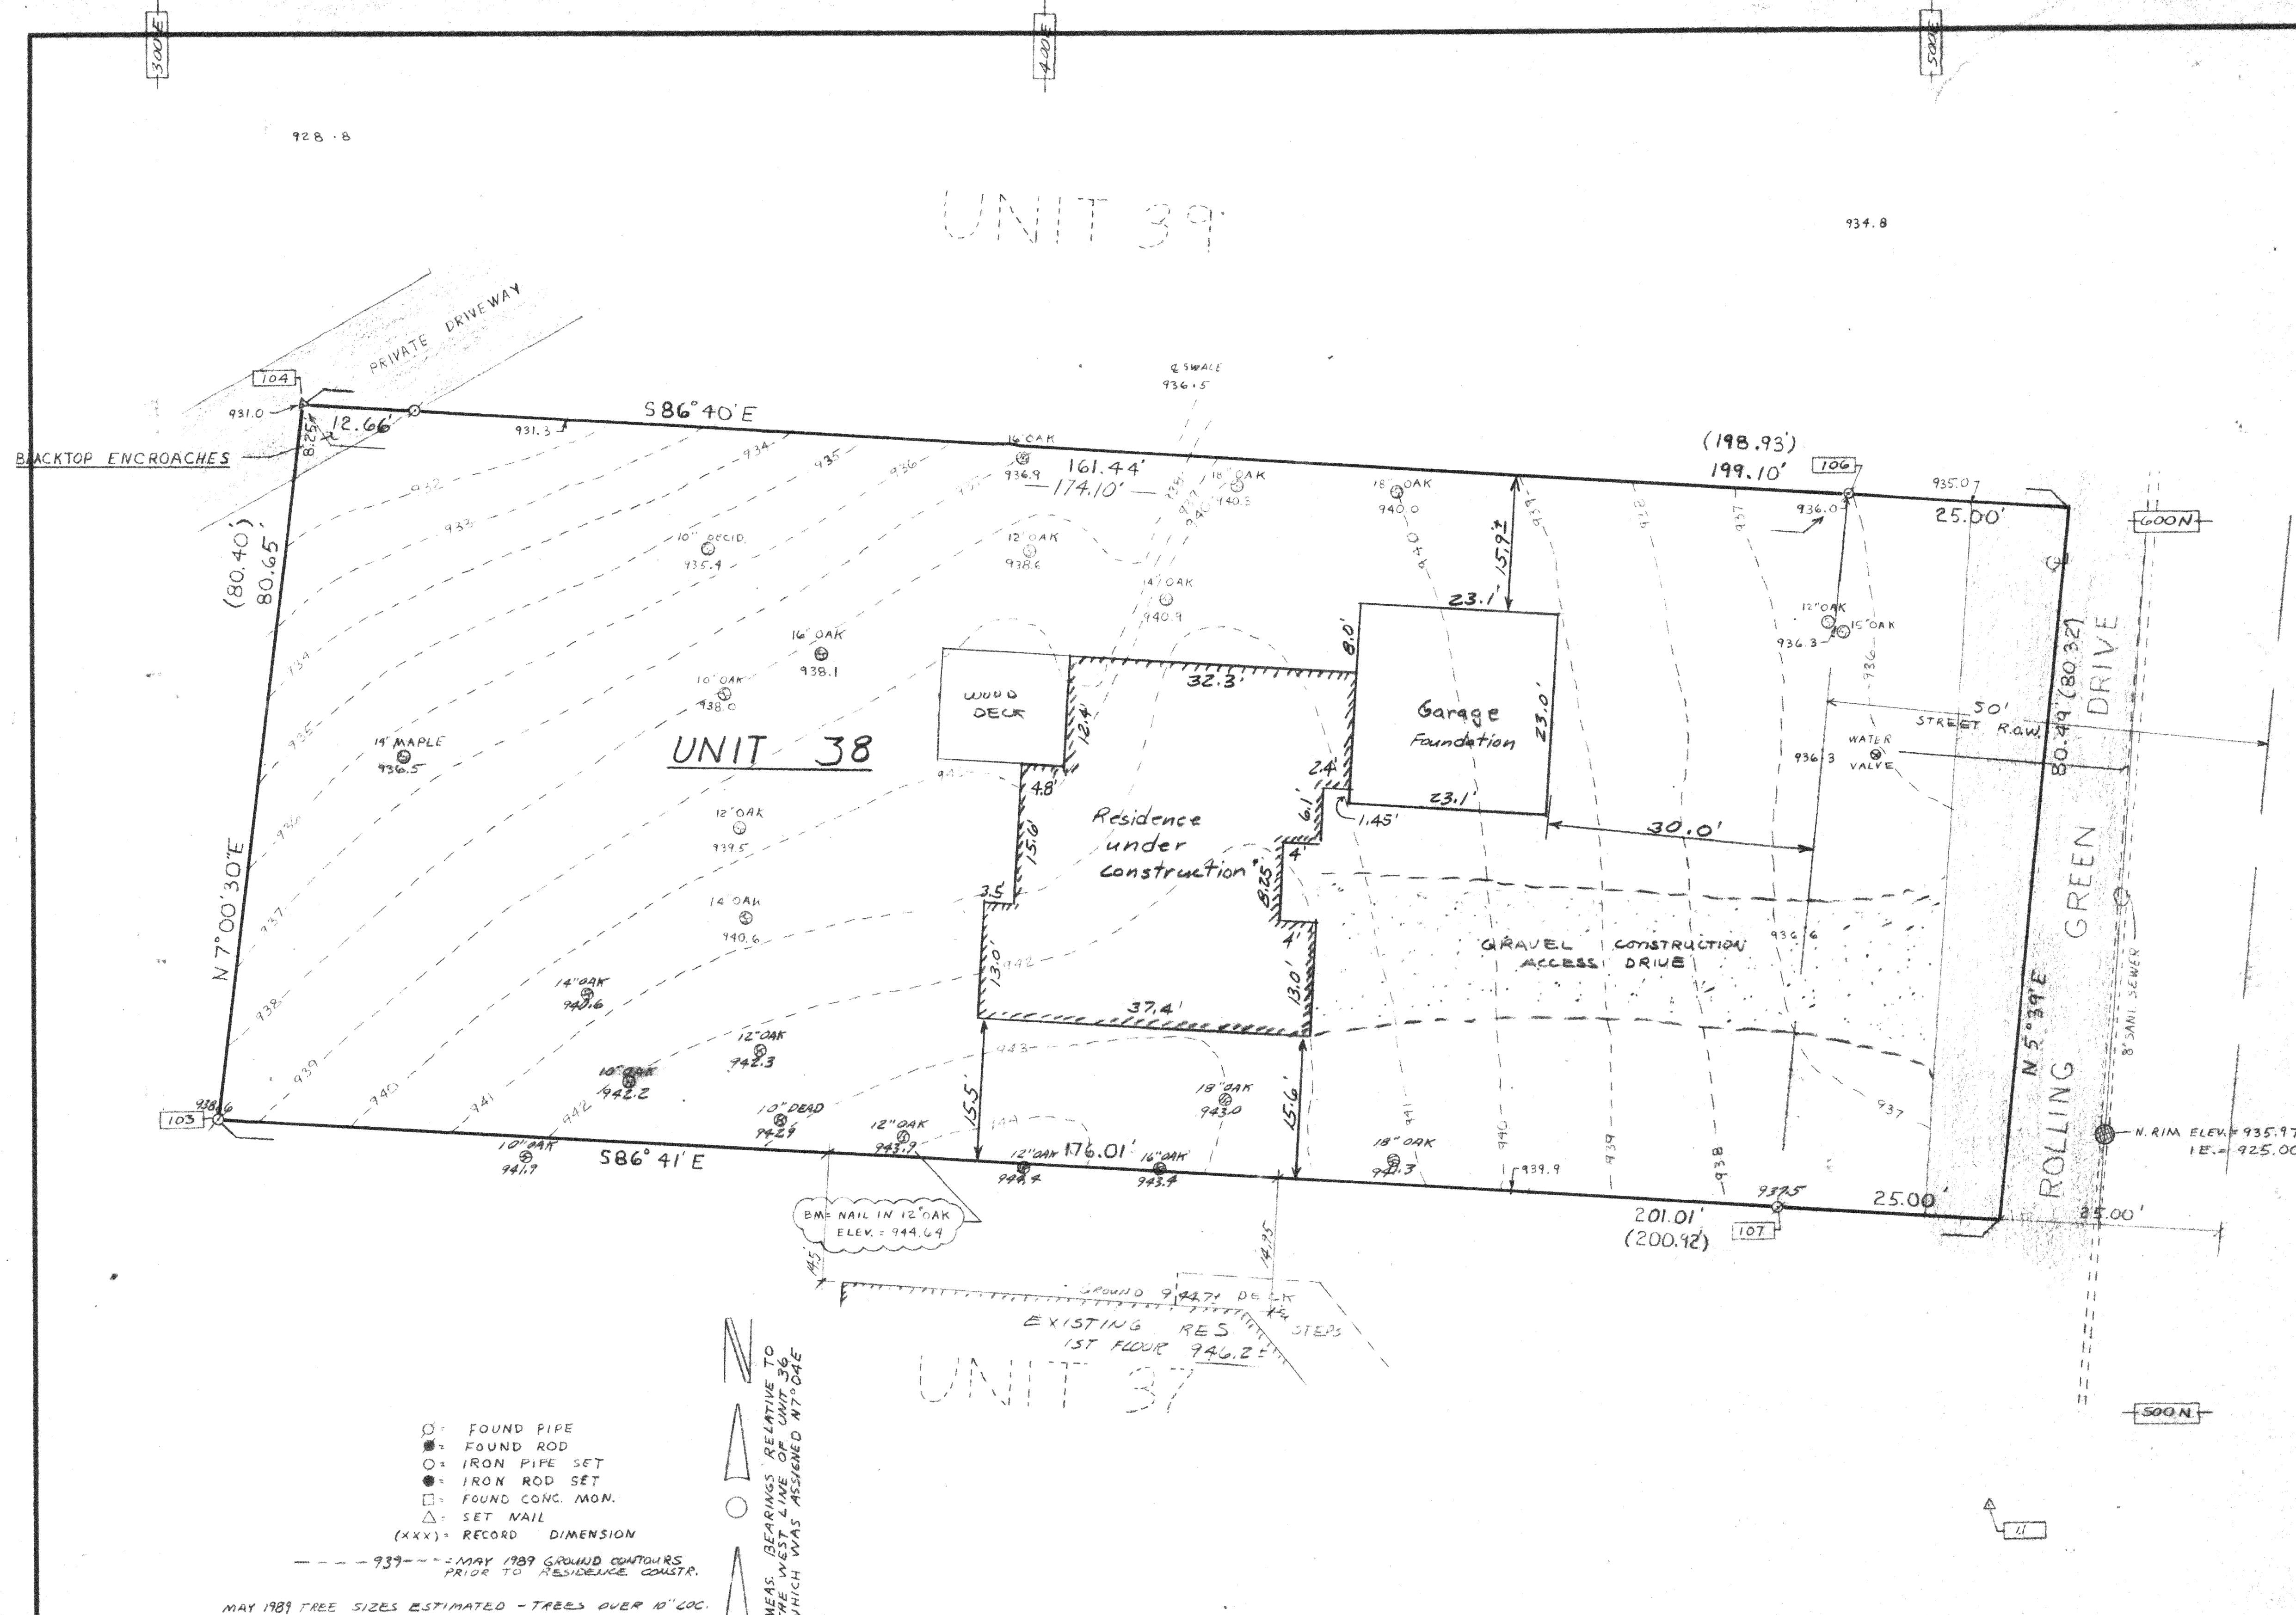

I hereby certify that I have surveyed the above described property and that the above map is a true representation thereof and shows the size and location of the property, its exterior boundaries, the location of all visible structures and dimensions of all principal buildings thereon, boundary fences, apparent easements, roadways and visible encroachments, if any.

This survey is made for the use of the present owners of the property, and also those who purchase, acquire, or otherwise obtain title thereto within one (1) year from the date hereof.

Robert J. Jani
7/27/89

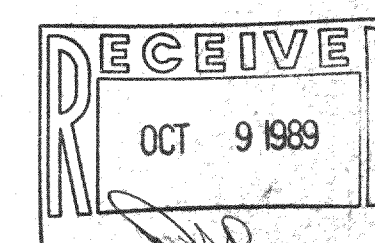

Work Ordered By: Marlon Gray

Plat of Survey Showing Location of New Residence under construction on Unit 38 of Abbey Springs Condominium Village of Fontana, Walworth Co., Wis.

DATE	DRAWN BY	REVISIONS	BY	DATE	PROJECT NO.
7/27/89	RF				3200
SCALE	CHECKED BY				LAST REVISION
1" = 10'					
	APPROVED BY				SHEET NO.