




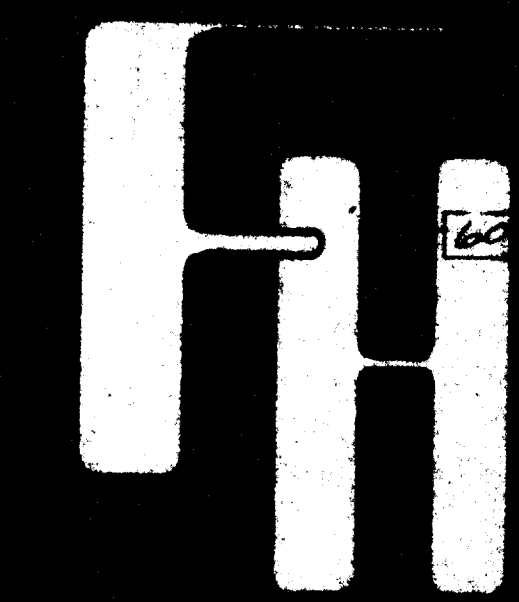

FARRIS, HANSEN & ASSOCIATES, INC.
Engineering, Architecture, Surveying
7 Ridgway Court P.O. Box 437
ELKHORN, WISCONSIN 53121
Office: (414) 723-2000
Fax: (414) 723-5886

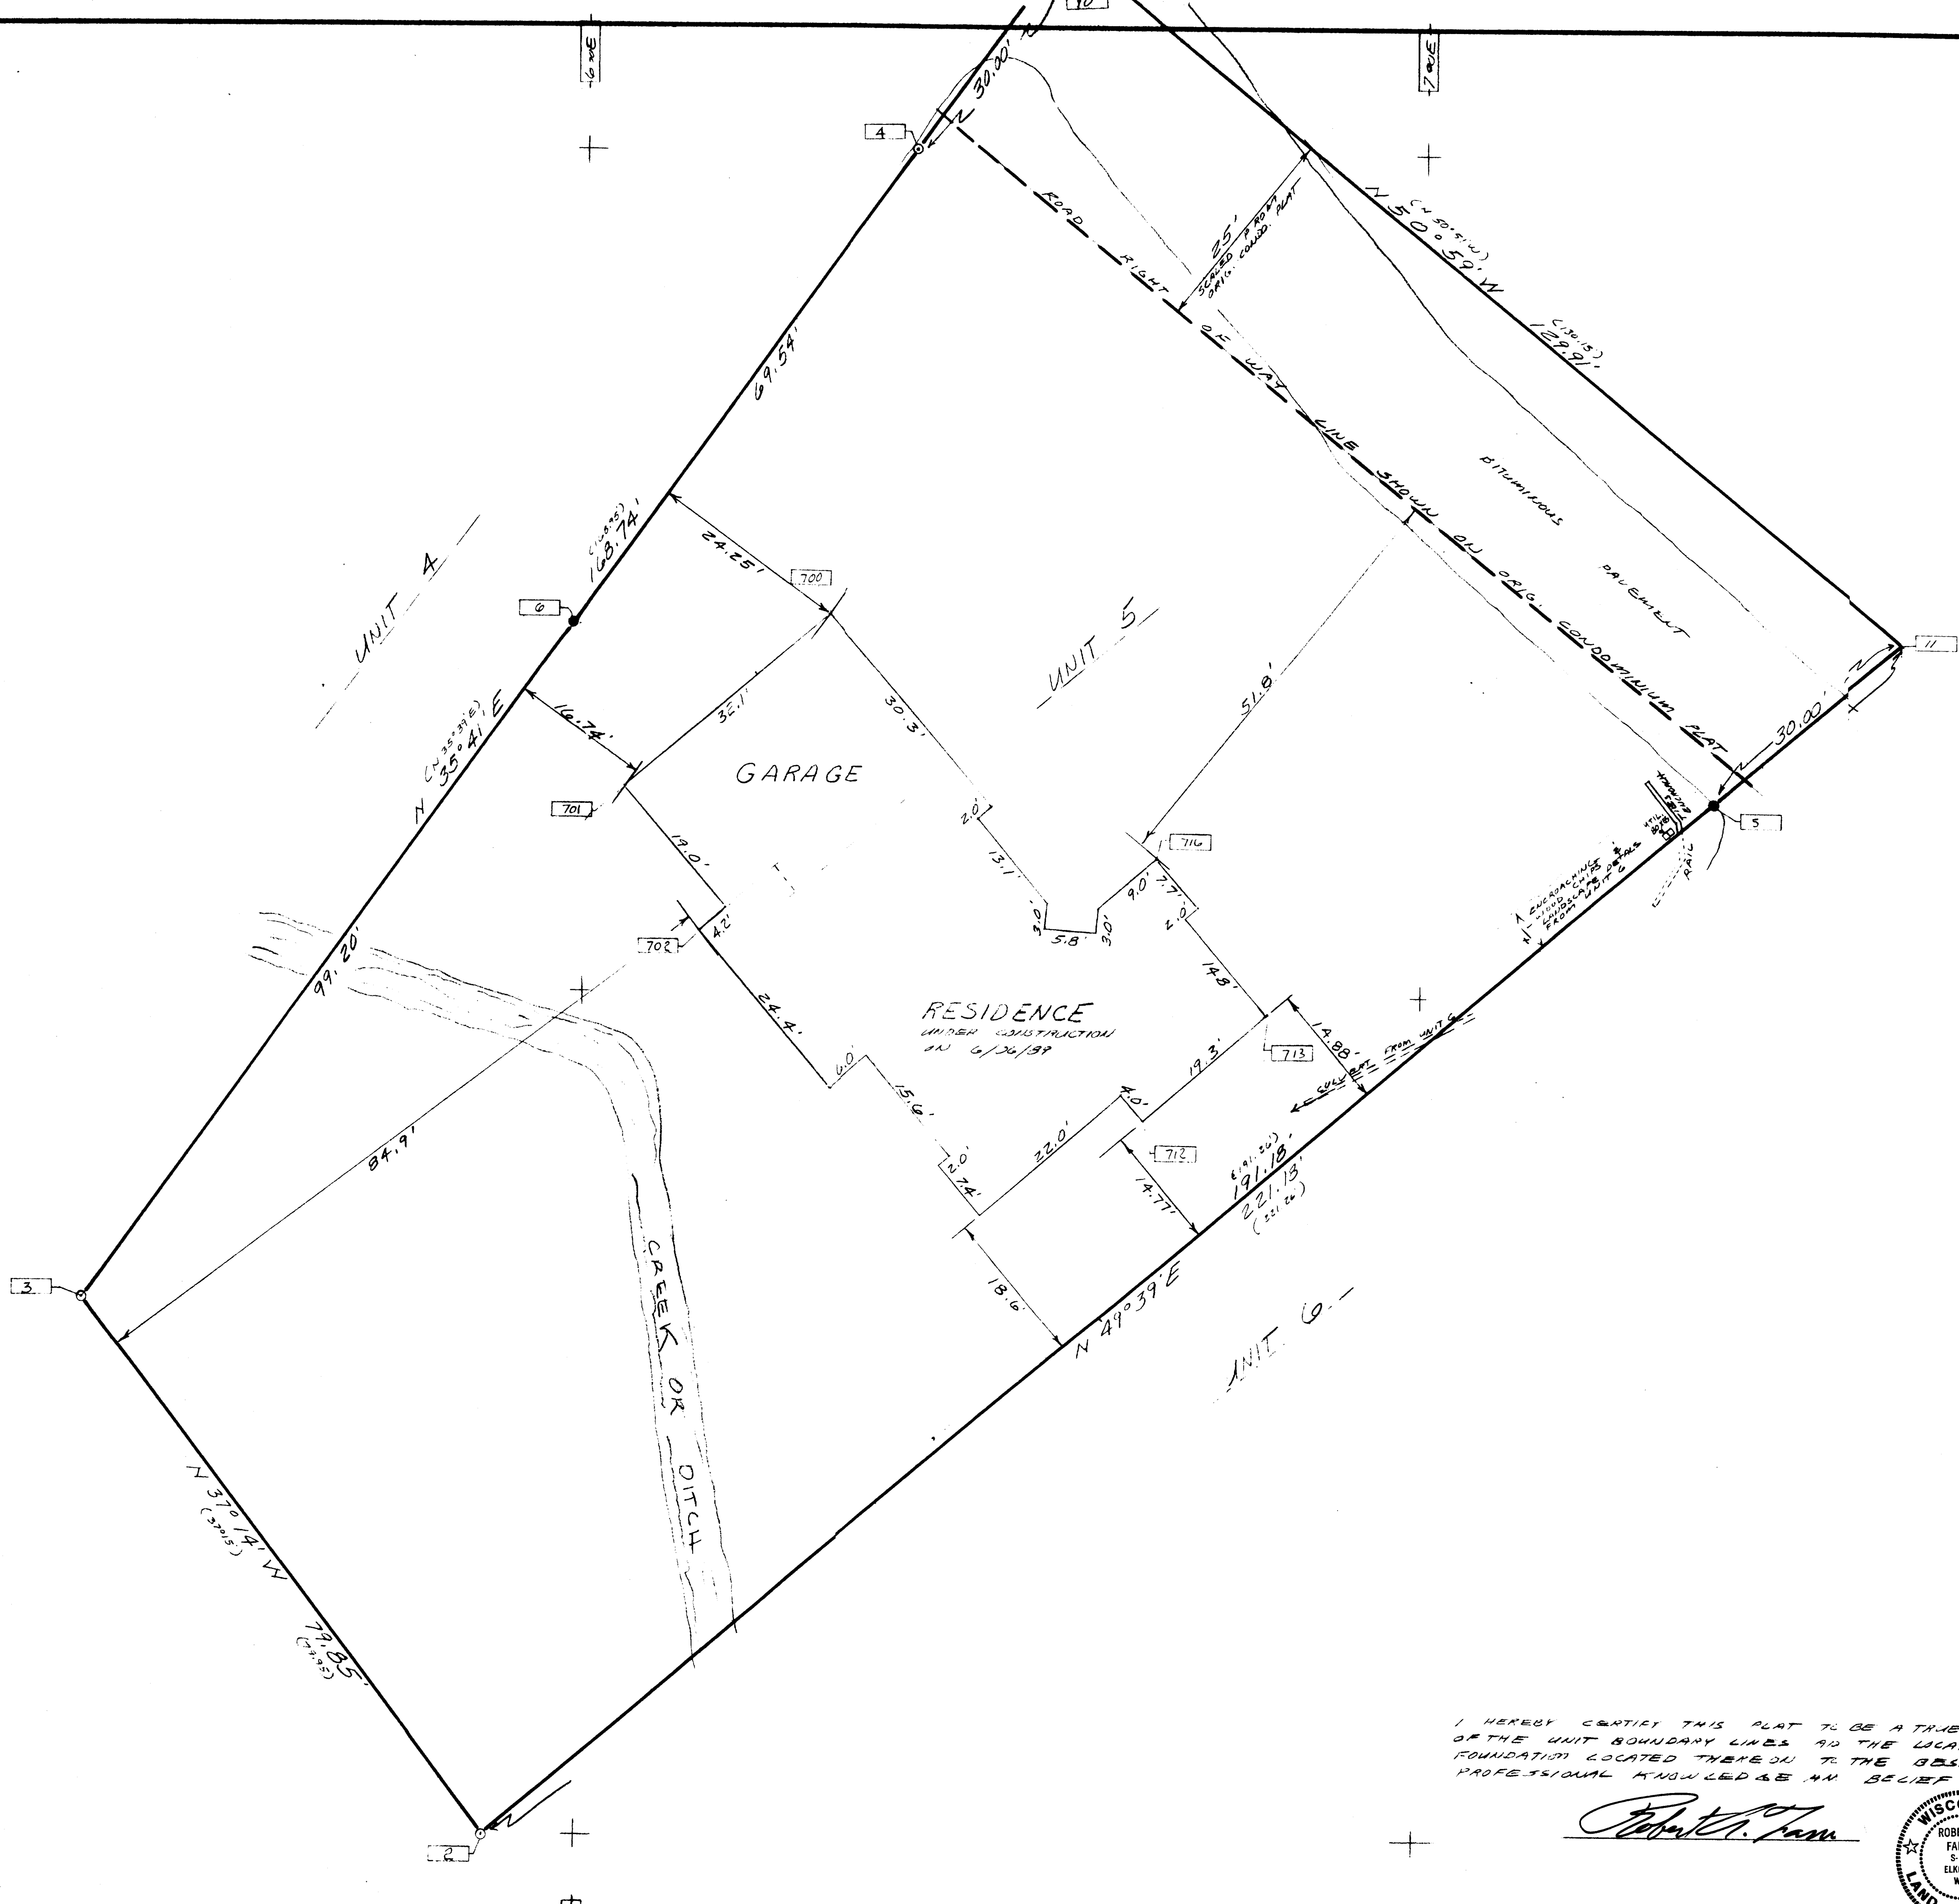

LINE BETWEEN UNITS 5 & 6 USED AS
BASIS FOR THE BEARINGS MEASURED


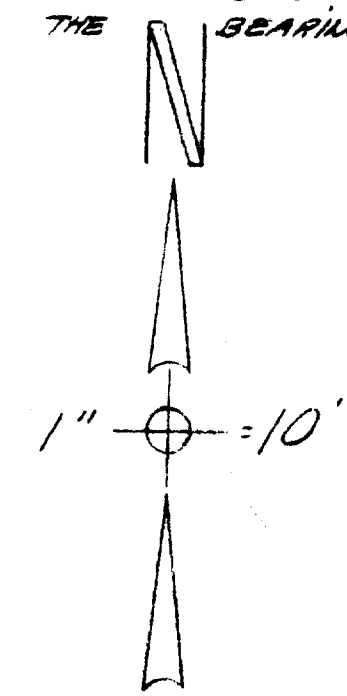


BUILDING DIMENSIONS TO FACE OF
PLYWOOD SHEATHING IN PLACE 6/5/89
YARDS AND SETBACKS TO CONC. FOUNDATION

- = IRON PIPE STAKE FOUND
- = IRON REBAR STAKE FOUND
- xxx = SURVEYOR'S COORDINATE FILE CABLE
- (xxx) = ORIGINAL PLAT DIMENSION - REC. CONVD. PLAT
WORK ORDERED BY VISNER BUILDERS

I HEREBY CERTIFY THIS PLAT TO BE A TRUE REPRESENTATION
OF THE UNIT BOUNDARY LINES AND THE LOCATION OF A NEW
FOUNDATION LOCATED THEREON TO THE BEST OF MY
PROFESSIONAL KNOWLEDGE AND BELIEF

Robert A. Farris

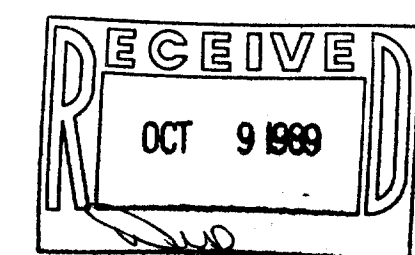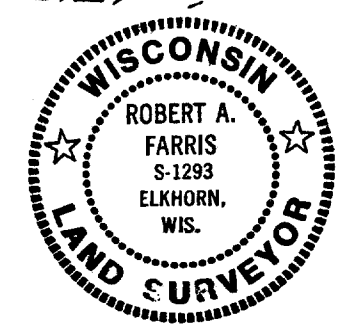

-PLAT OF SURVEY- Unit 5 Abbey Springs Condominium					
Foundation Location for New Residence Under Construction VILLAGE OF FONTANA, WAUKESHA CO., WISCONSIN LOCATED IN NW 1/4 SE 1/4 SEC. 13, T. 1N., R. 16E.					
DATE 6/06/89	DRAWN BY RF	REVISIONS	BY	DATE	PROJECT NO. 3135
SCALE 1"=10'	CHECKED BY				LAST REVISION
	APPROVED BY				