

**DEGEN - FOAT SURVEYING LLC**

048379  
048379S1.DWG

100 SOUTH SECOND STREET  
WATERFORD, WISCONSIN 53185  
(262)534-5404 (FAX)534-2022

**PLAT OF SURVEY**


LOT 1, BLOCK 1 STRAIN'S ADDITION TO THE VILLAGE OF GENOA CITY, FORMERLY GENOA JUNCTION, WALWORTH COUNTY, WISCONSIN.

\* REFER TO A CURRENT TITLE REPORT FOR EASEMENTS, RESTRICTIONS OR COVENANTS OF RECORD THAT MAY AFFECT THIS LAND. \*

SURVEY PREPARED FOR: RE/MAX - SOUTHERN LAKES  
MICKEY HORGAN  
112 ELIZABETH LANE  
GENOA CITY, WI 53128

**WALWORTH STREET**


(66' WIDE)

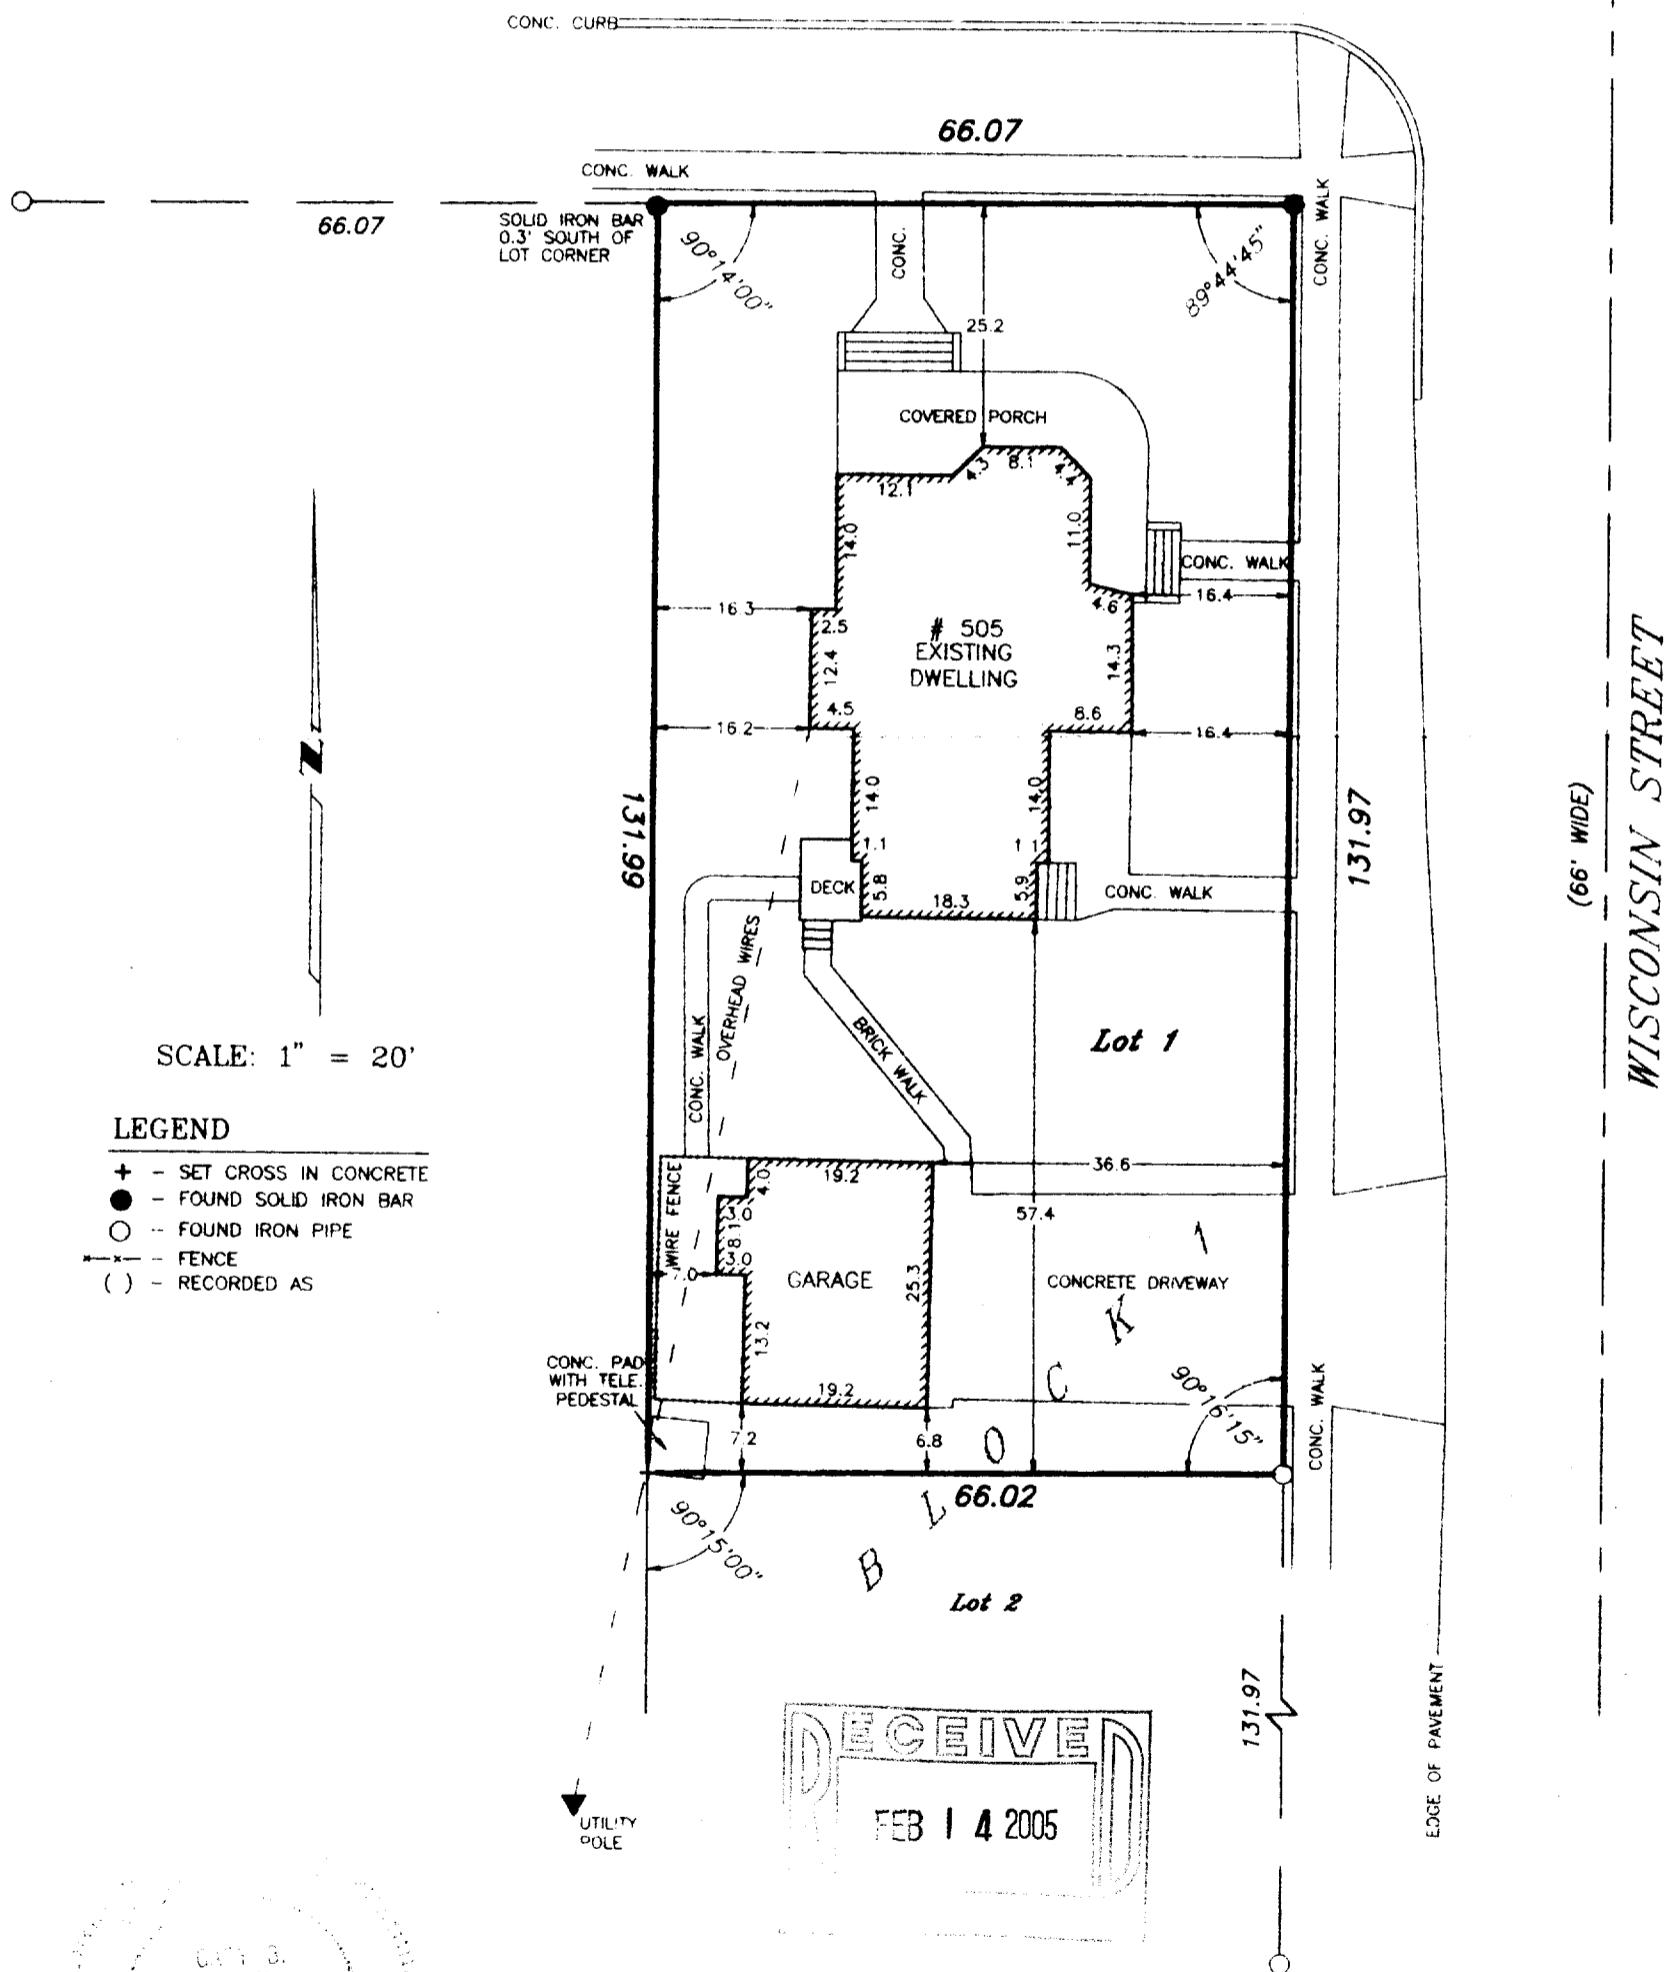

SCALE: 1" = 20'

**LEGEND**

- + - SET CROSS IN CONCRETE
- - FOUND SOLID IRON BAR
- - FOUND IRON PIPE
- - - - FENCE
- ( ) - RECORDED AS

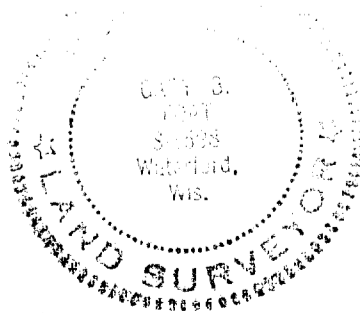

I HEREBY CERTIFY THAT I HAVE SURVEYED THE ABOVE DESCRIBED PROPERTY AND THE ABOVE MAP IS A TRUE REPRESENTATION THEREOF AND SHOWS THE SIZE AND LOCATION OF THE PROPERTY, THE LOCATION OF ALL VISIBLE STRUCTURES AND DIMENSIONS OF ALL PRINCIPAL BUILDINGS THEREON, BOUNDARY FENCES, APPARENT EASEMENTS, ROADWAY AND VISIBLE ENCROACHMENTS, IF ANY.

THIS SURVEY IS MADE FOR THE PRESENT OWNERS OF THE PROPERTY, AND ALSO THOSE WHO PURCHASE OR GUARANTEE THE TITLE THERETO WITHIN (1) YEAR FROM THE DATE HEREOF.

DATED AT WATERFORD, WI THIS 25th DAY OF OCTOBER 20 04

RECERTIFIED \_\_\_\_\_

*Jay Foat*

006-1211

TS-1