


# HAROLD H. KOLB

REGISTERED PROFESSIONAL LAND SURVEYOR

LAKE GENEVA, WISCONSIN

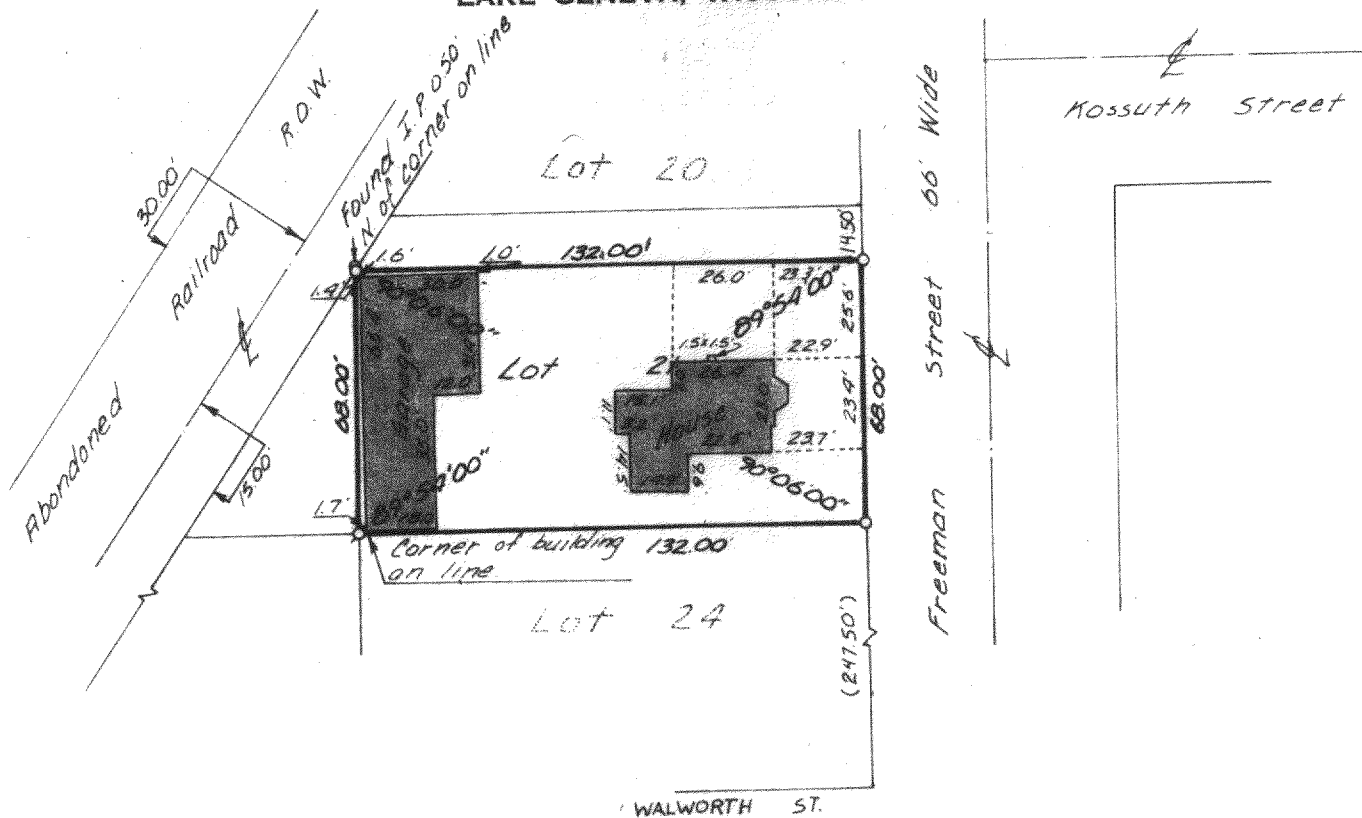

## PLAT OF SURVEY OF

The South 68.00 feet of Lot 21, Freemans Subdivision,  
Village of Genoa City, Walworth County, Wisconsin.

OWNER: R. E. May

ACCURACY: Distance  $\pm$  0.02'  
Angles  $\pm$  01"  
Error of Closure less than  
1/3000


N



Scale: 1" = 50'

### LEGEND

- φ - IRON PIPE FOUND
- - IRON PIPE PLACED
- - CONCRETE MONUMENT
- x - SPIKE
- ( ) - AS PLATTED

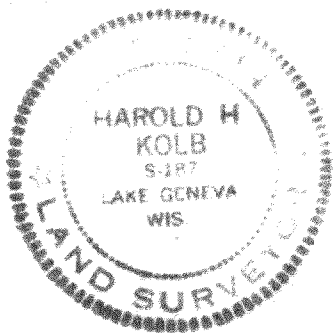

I. HAROLD H. KOLB, DO HEREBY CERTIFY THAT I HAVE SURVEYED THE PROPERTY HEREON DESCRIBED ACCORDING TO THE OFFICIAL RECORDS, AND THAT THE PLAT HEREON IS A CORRECT REPRESENTATION OF THE LOT LINES.

*Harold H. Kolb*

HAROLD H. KOLB  
WISCONSIN REGISTERED LAND SURVEYOR, S-187

DATE Feb. 3, 1975

TFR-11