


NORTHEAST CORNER OF
SECTION 35, T1N R18E

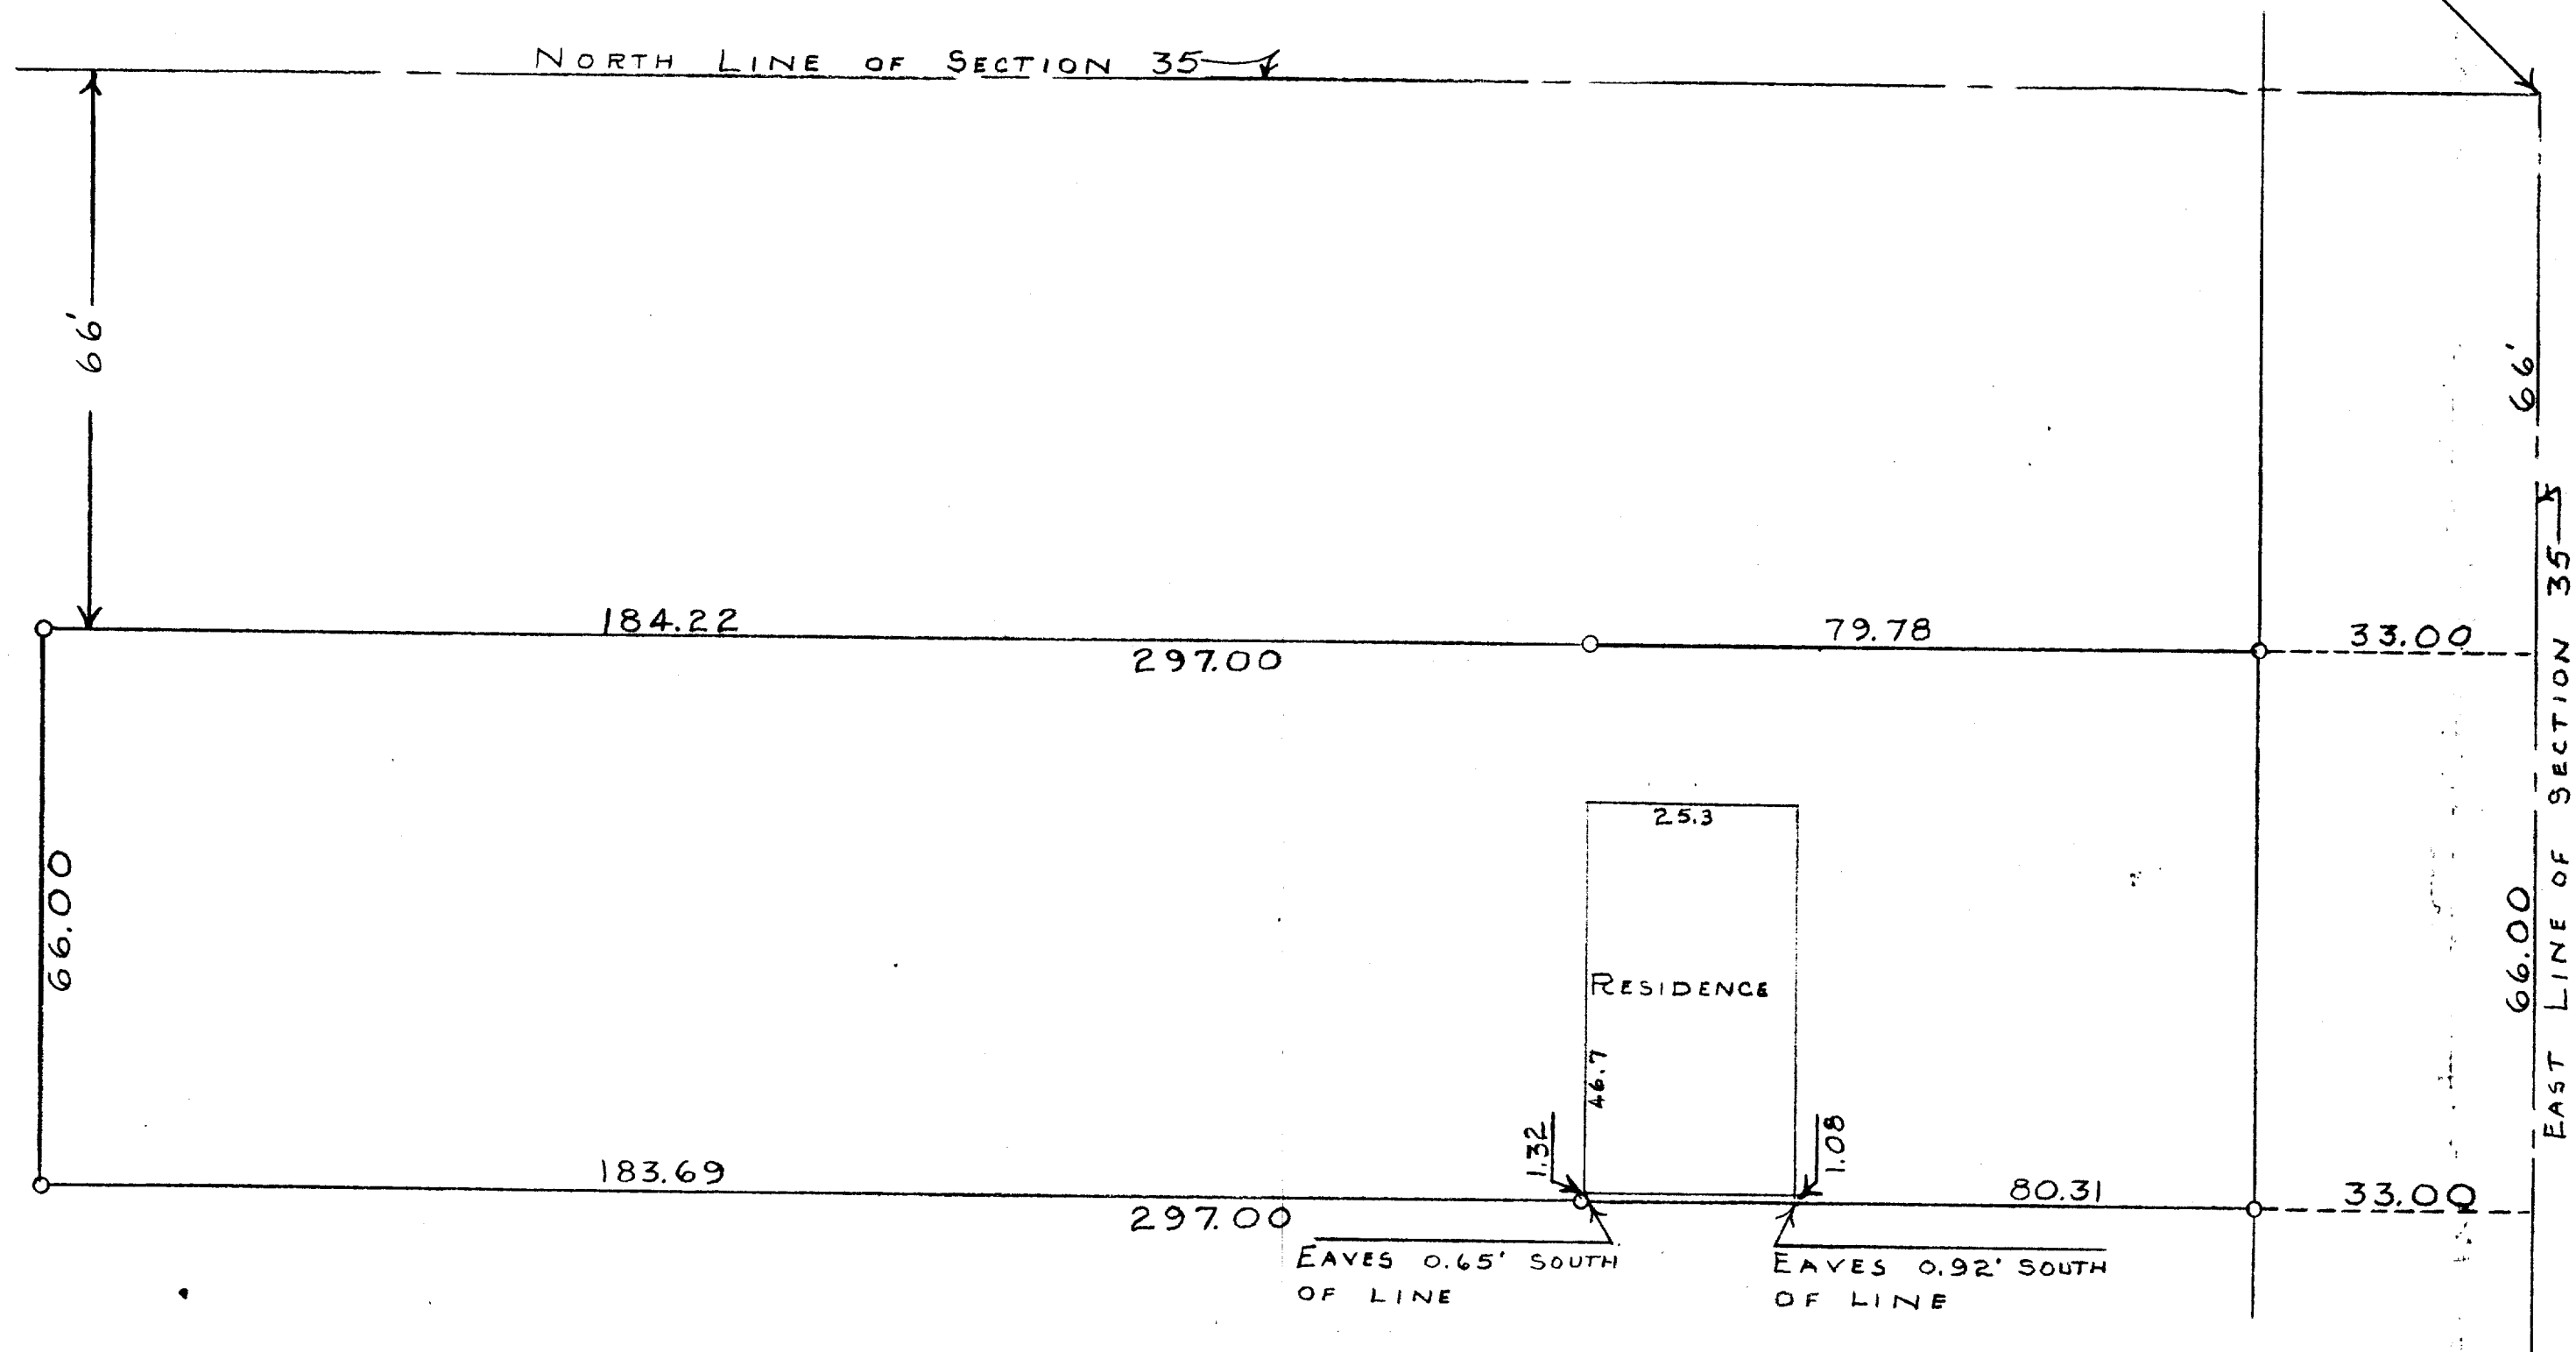

PLAT OF SURVEY OF A PARCEL OF LAND LOCATED IN THE
NORTHEAST 1/4 OF SECTION 35, T1N R18E, VILLAGE OF GENOA
CITY, WALWORTH COUNTY, WISCONSIN.
OCTOBER 14, 1954

George T. Dunham
GEORGE T. DUNHAM, SURVEYOR
DELAVER, WISCONSIN

6-1

VGC-1D + part of VGC-1