


PLAT OF SURVEY OF LOTS 4 & 5 OF CAREY'S
ADD. TO GENOA CITY, T1N, R18E, WALWORTH
COUNTY, WISCONSIN

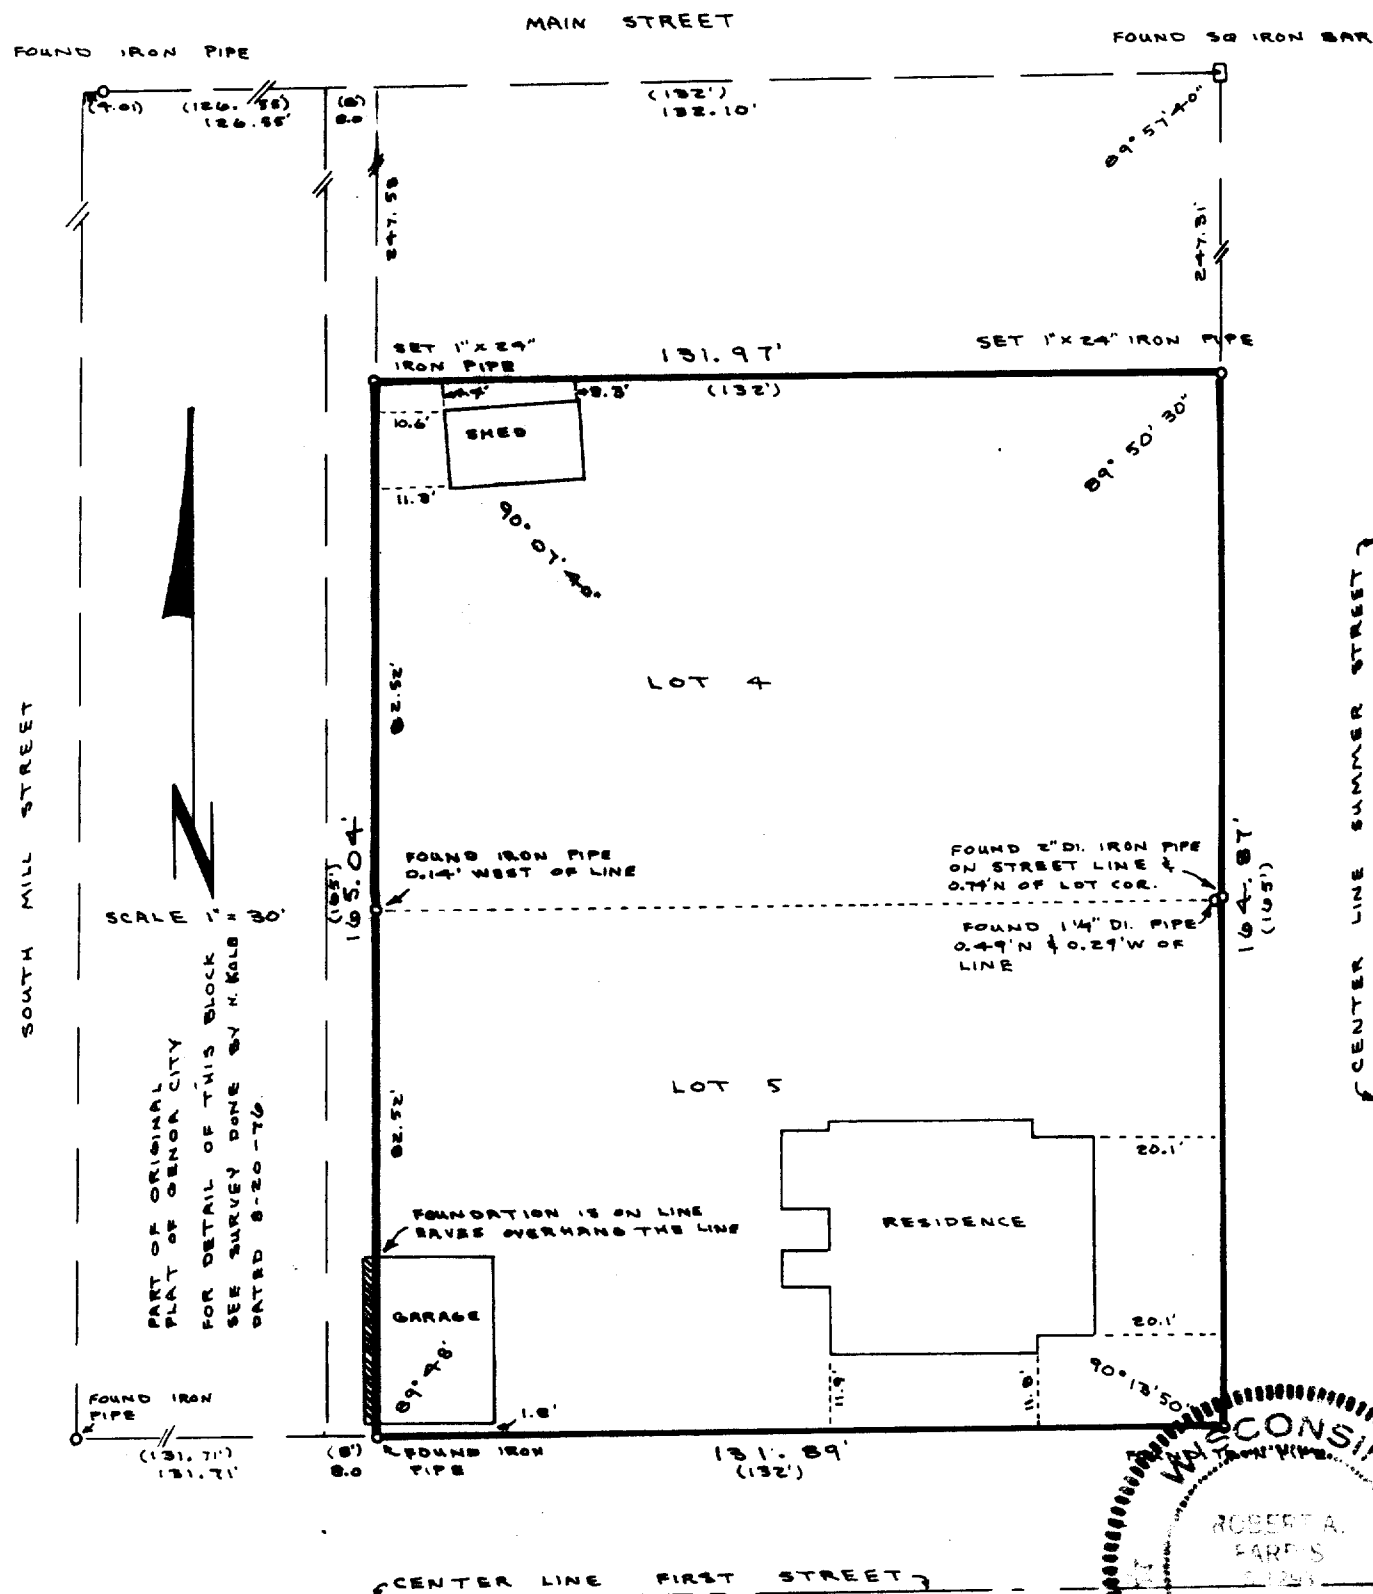

I HAVE SURVEYED THE ABOVE-DESCRIBED PROPERTY AND THE ABOVE MAP IS A TRUE REPRESENTATION THEREOF AND SHOWS THE SIZE AND LOCATION OF THE PROPERTY, THE LOCATION OF THE STRUCTURES THEREON AND VISIBLE ENCROACHMENTS TO THE BEST OF MY KNOWLEDGE AND BELIEF.

CLIENT: WM. LAWTON


ATTY.: RANDALL LEECE

ROBERT A. FARRIS RLS

DATED THIS 23rd DAY OF March 1978

715 W WALWORTH AVE. P.O. BOX 487
ELKHORN, WISCONSIN 53121
TELEPHONE 414-723-2096

DRAWING NO. 1321

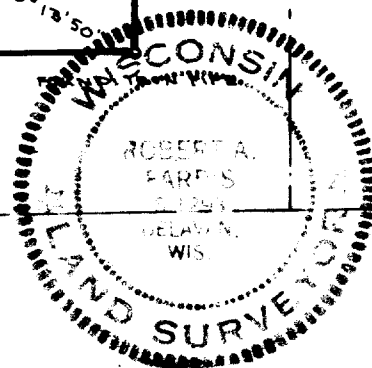

6-106