


PLAT OF SURVEY

OF

All that part of the Southeast Quarter of the Southeast Quarter of Section 35, Township 1 North, Range 18 East of the 4th Principal Meridian, Village of Genoa City, Walworth County, Wisconsin bonded and described as follows:

Commencing at a point four rods (66.00 feet) west of the northwest corner of Lot 1, Block 1, Strains Addition to the Village of Genoa Junction (now Genoa City), thence running South 10 rods (165.00 feet), thence East 4 rods (66.00 feet) to the place of beginning.


Legal description as provided.

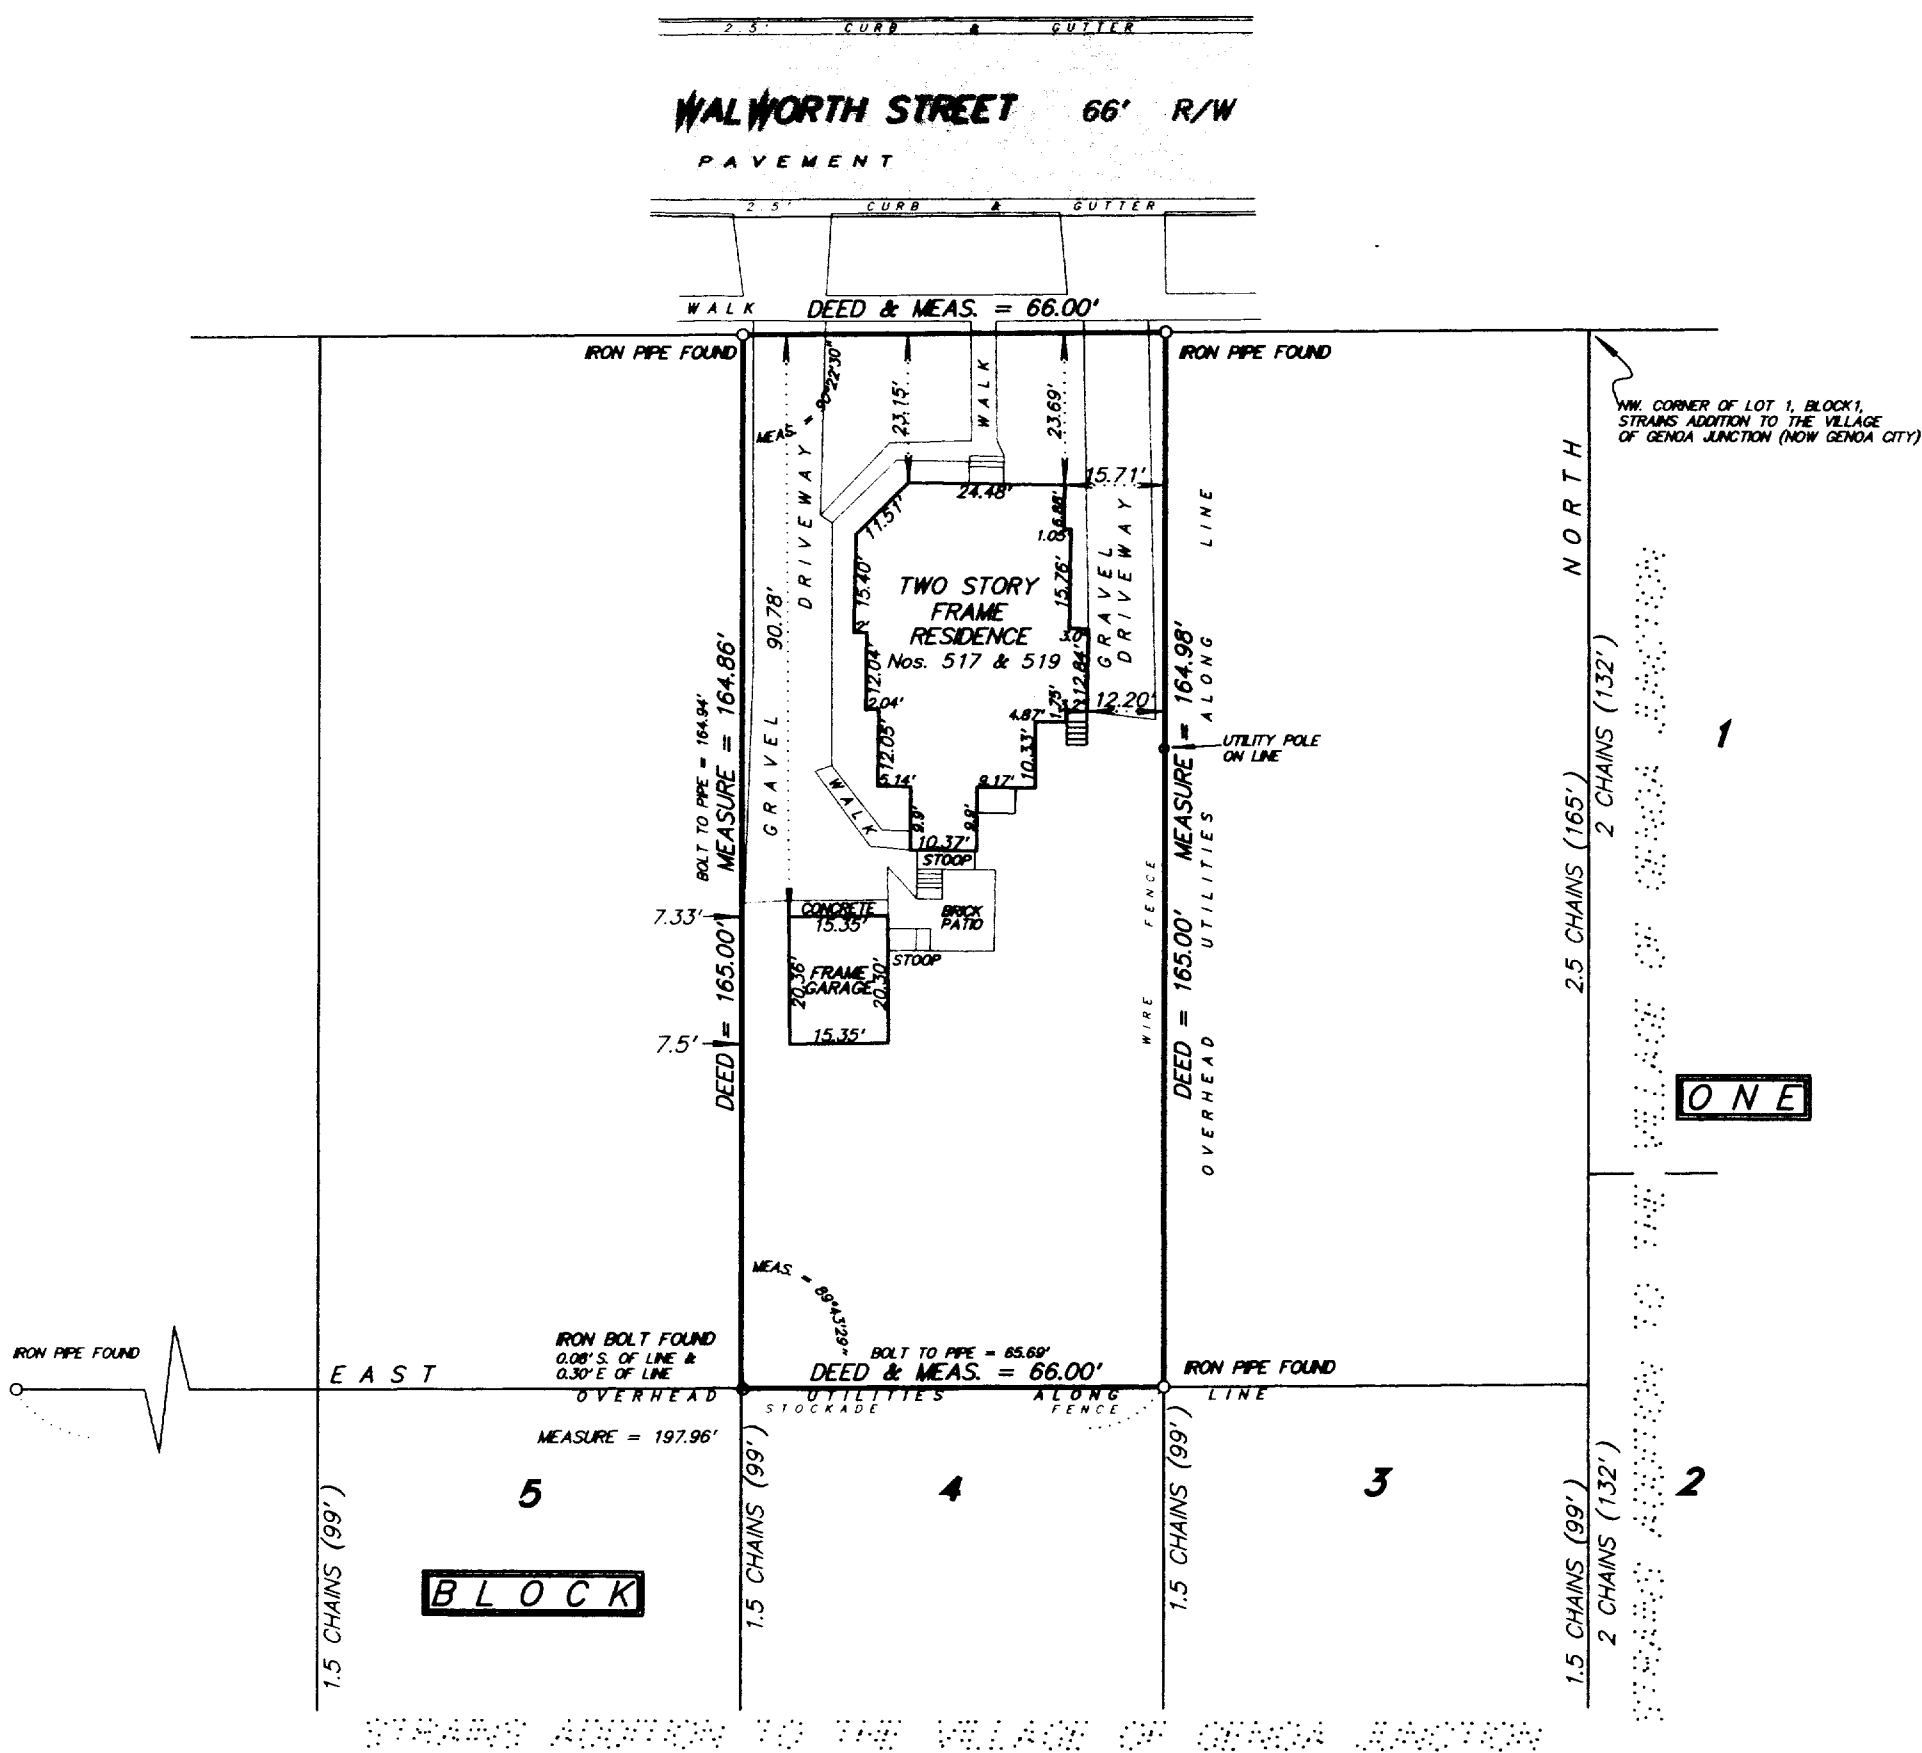

SCALE 1 inch = 30 feet

ORDERED BY K. Lewis / Lewis and Levinson

JOB NO. 0 2 2 4 8

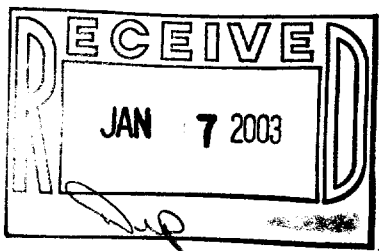

I hereby certify that I have surveyed the above described property and the above plat is a true representation thereof and shows the size and location of the property, its exterior boundaries, the location and dimensions of all visible structures thereon, boundary fences, apparent easements and roadways and visible encroachments, if any.

This survey is made for the exclusive use of the present owners of the property, and also those who purchase, mortgage, or guarantee the title thereto within one year from the date hereof.

Dated at Bassett, Wisconsin this _____ day of _____ 2002.

Mark A. Bolender
Wisconsin Registered Land Surveyor S - 1784